


No.	Date	Description
1	2025/12/11	Contract Documents
3	2025/01/29	Addendum 4

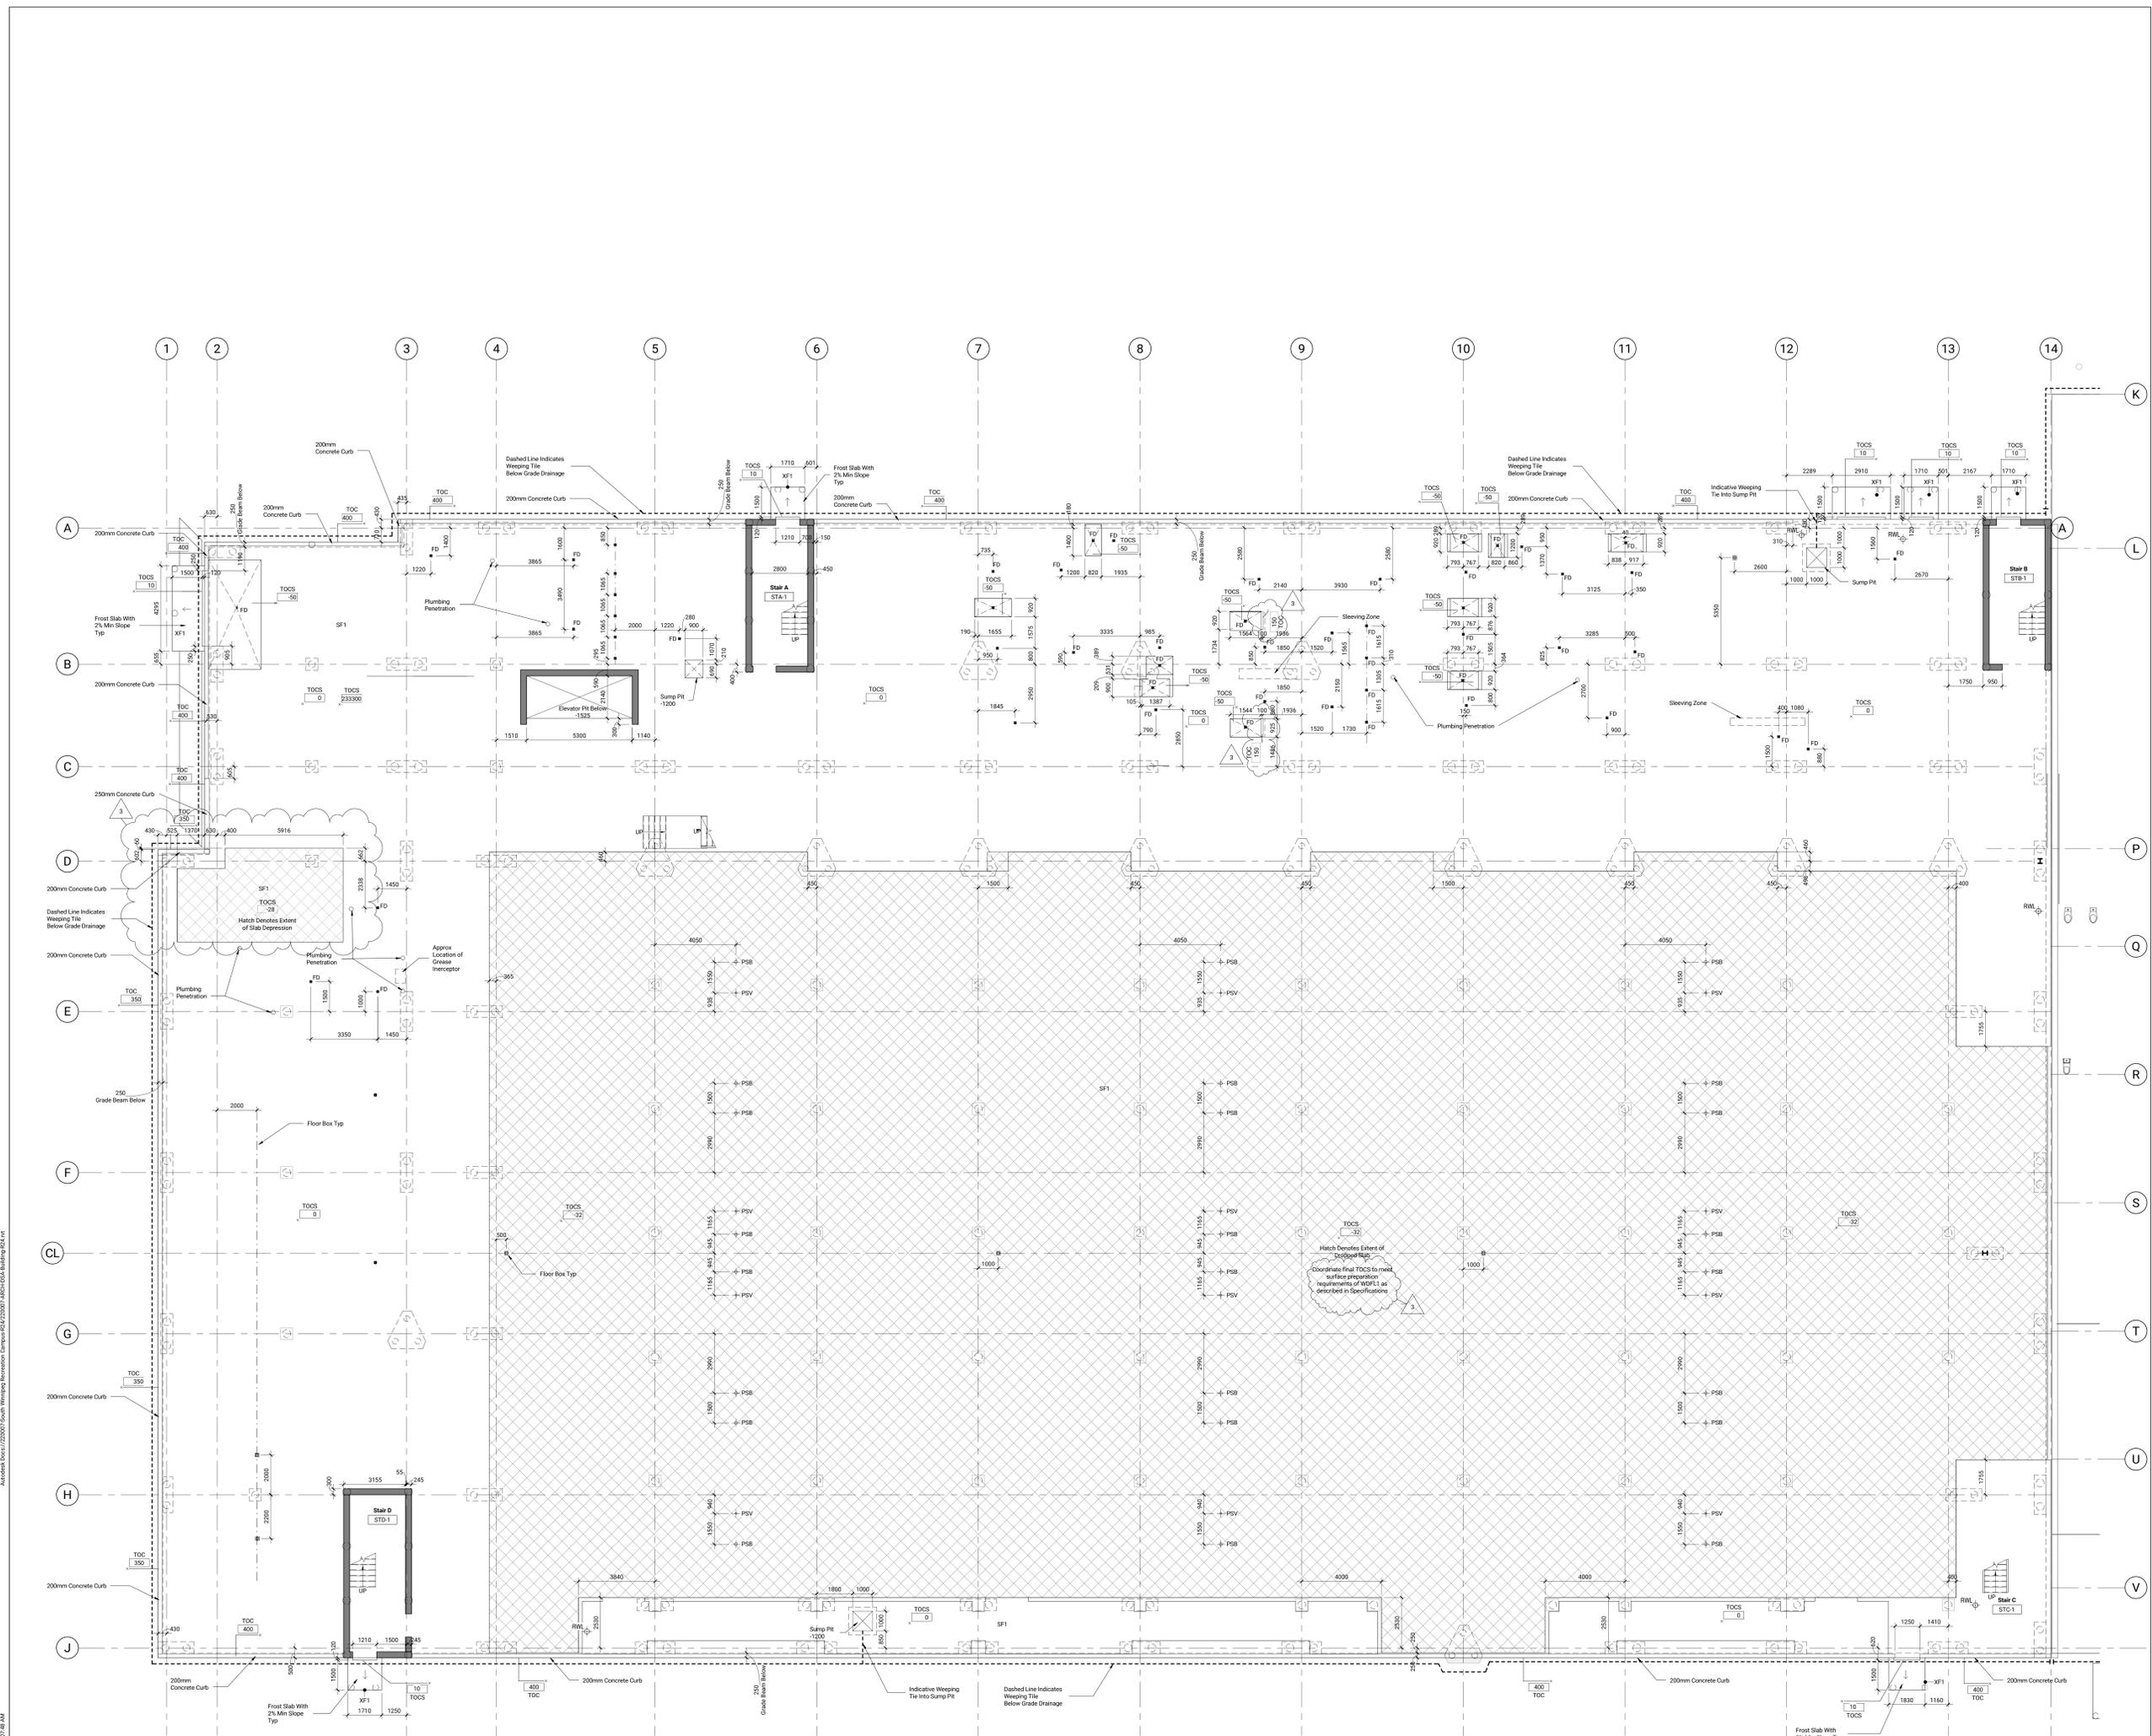

Contractor Must Check & Verify all Dimensions on the Job.
Do Not Scale Drawings.
All Drawings, Specifications and Related Documents are the Copyright Property of the Architect and shall be returned upon Request, Reproduction or Circulation, Modification and Release Constitutes Part or in Whole of Violation Without the Written permission of the Architect.
This Drawing is Not to be Used for Construction Until Signed by the Architect.

**South Winnipeg Recreation
Campus Phase 1**
Address: 15 Ruth Crossing & 25 Ruth Crossing
Winnipeg, MB
Consultant Project No.: 220007
City of Winnipeg Project No.: 2020/127
City of Winnipeg Tender No.: CS-2025B

Level 1 - Slab Edge - Recreation Centre
1:100

A150

2025-01-29 11:07:48 AM Autodesk Docs://220007-South Winnipeg Recreation Campus-654223007-480104-D54-Building-654.rvt