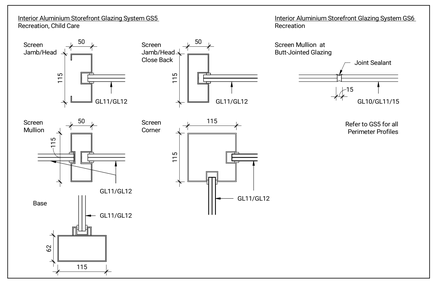

Aluminum Interior Storefront Details 19 A352
1 : 5

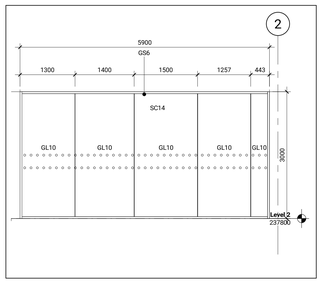

Level 2 - Recreation at Living Room - SC14 18 A352
1 : 50

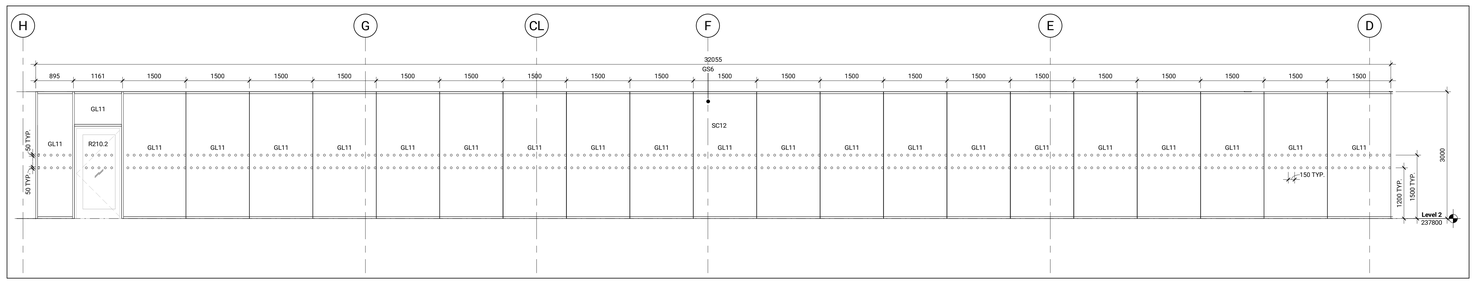

Level 2 - Recreation - Gymnasium - SC12 17 A352
1 : 50

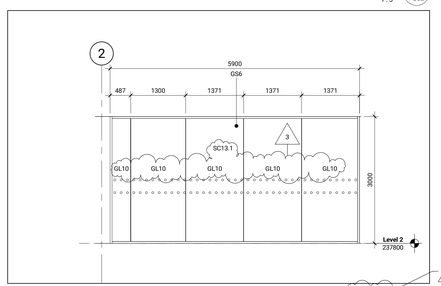

Level 2 - Recreation at Movement Studio - SC13.1 16 A352
1 : 50

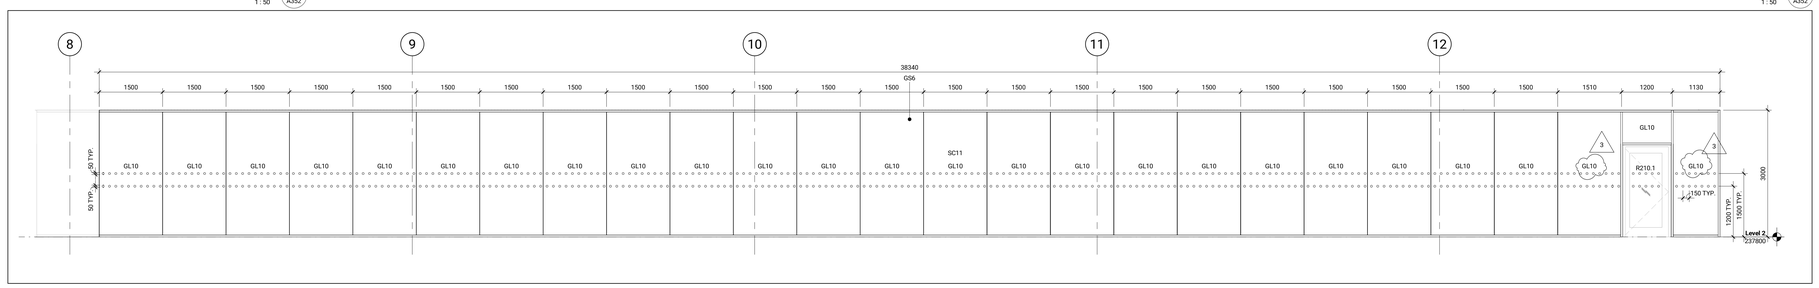

Level 2 - Recreation - Running Track - SC11 (Continued) 15 A352
1 : 50

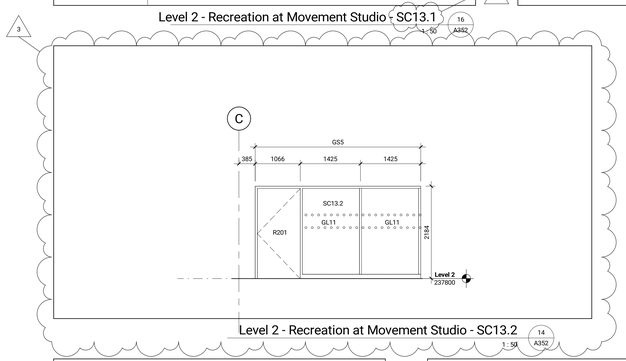

Level 2 - Recreation at Movement Studio - SC13.2 14 A352
1 : 50

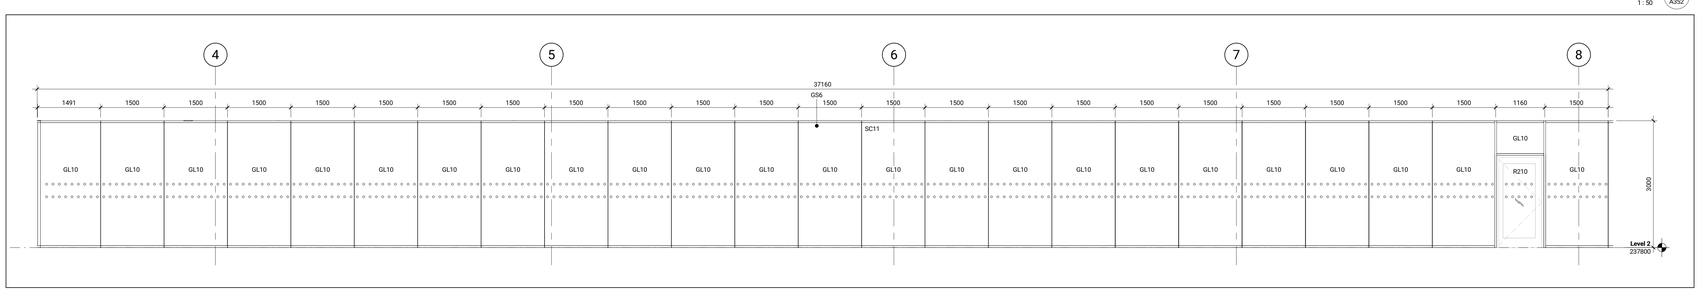

Level 2 - Recreation - Running Track - SC11 13 A352
1 : 50

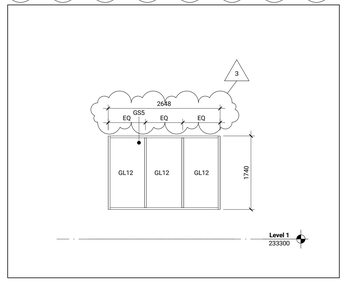

Level 1 - Admin Office - Child Care - SC15 12 A352
1 : 50

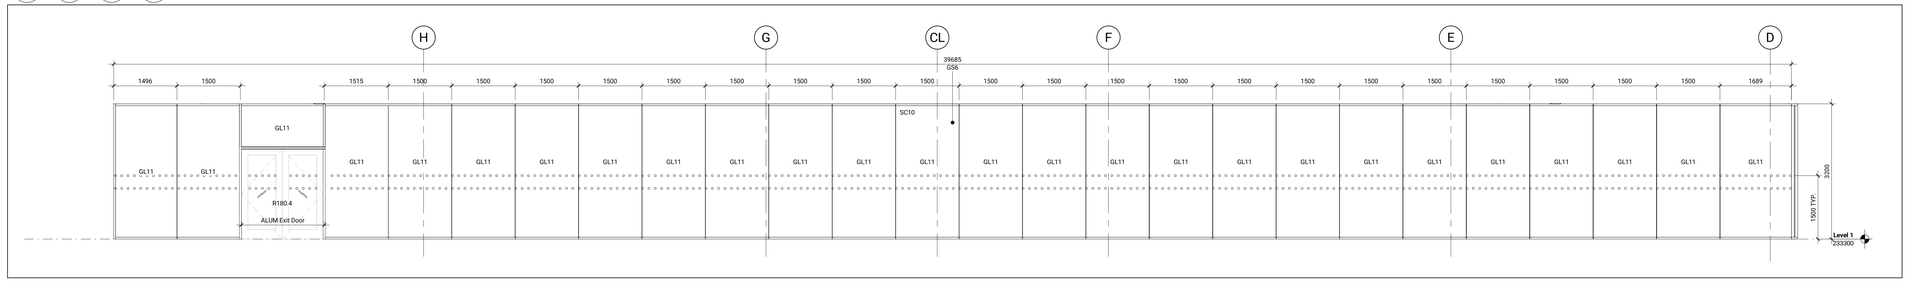

Level 1 - Recreation - Gymnasium - SC10 11 A352
1 : 50

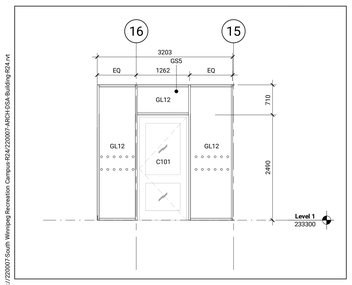

Level 1 - Child Care Entry - SC18 10 A352
1 : 50

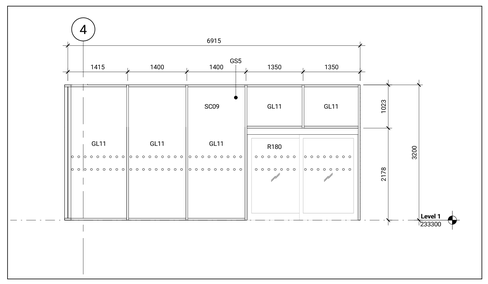

Level 1 - Recreation - Gymnasium - SC09 9 A352
1 : 50

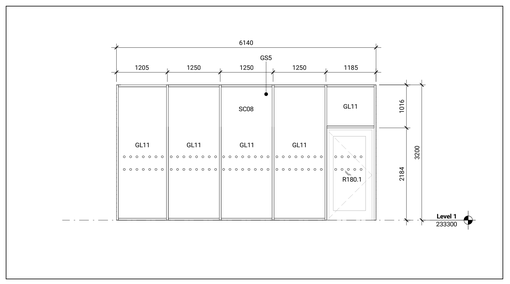

Level 1 - Recreation - Gymnasium - SC08 8 A352
1 : 50

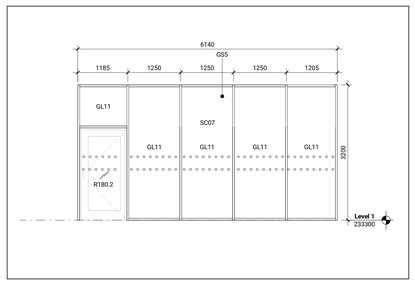

Level 1 - Recreation - Gymnasium - SC07 7 A352
1 : 50

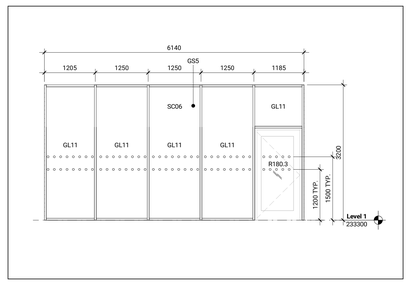

Level 1 - Recreation - Gymnasium - SC06 6 A352
1 : 50

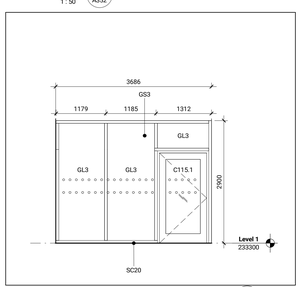

Level 1 - Child Care - Vestibule - SC20 5 A352
1 : 50

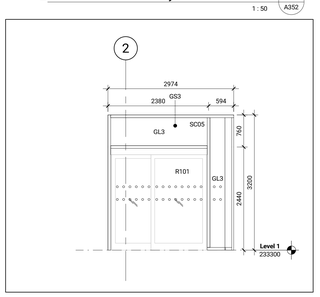

Level 1 - Recreation - Entry Vestibule - SC05 4 A352
1 : 50

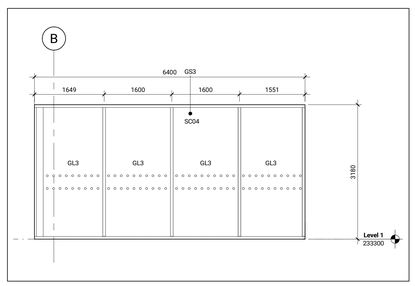

Level 1 - Recreation - Entry Vestibule - SC04 3 A352
1 : 50

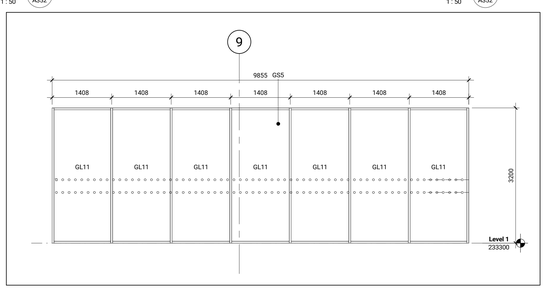

Level 1 - Recreation - Universal Change Room - SC03 2 A352
1 : 50

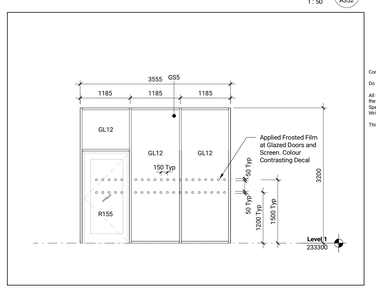

Level 1 - Recreation - Multipurpose Team Room - SC02 1 A352
1 : 50

diamond schmitt
BrookMcIlroy/

Winnipeg
THE CITY OF WINNIPEG
ASSETS & PROJECT MANAGEMENT DEPARTMENT
MUNICIPAL ACCOMMODATIONS DIVISION
3-65 GARRY STREET, R3C 4K4

Manitoba
Manitoba Public Service Delivery
200 - 400 Ellice Avenue,
Winnipeg, Manitoba
R3B 3M3

Issued

No.	Date	Description
1	2023/12/11	Contract Documents
3	2026/01/29	Addendum 4

Contractor Must Check & Verify all Dimensions on the Job.

Do Not Scale Drawings.

All Drawings, Specifications and Related Documents are the Copyright Property of the Architect and Must be Returned Upon Request. Reproduction of Drawings, Specifications and Related Documents in Part or in Whole is Forbidden Without the Written permission of the Architect.

This Drawing is Not to be Used for Construction Until Signed by the Architect.

South Winnipeg Recreation Campus Phase 1
Address: 15 Ruth Crossing & 25 Ruth Crossing
Winnipeg, MB
Consultant Project No: 220007
City of Winnipeg Project No: 2020-127
City of Winnipeg Tender No: 63-20258

Interior Screen Schedule
As indicated
A352

Autodesk Docs://220007-South Winnipeg Recreation Campus RSA/220007-MCH-DSA-Building-RSA.rvt
2026-01-29 11:38:25 AM