


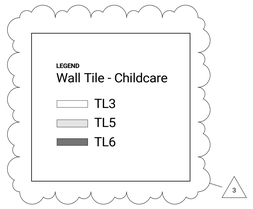


Kitchen Child Care C116 - West 27 A822
1 : 50




Kitchen Child Care C116 - South 26 A822
1 : 50




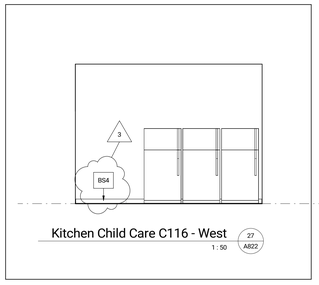Kitchen Child Care C116 - East 25 A822
1 : 50

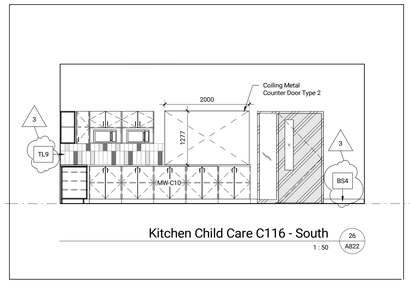


Kitchen Child Care C116 - North 24 A822
1 : 50

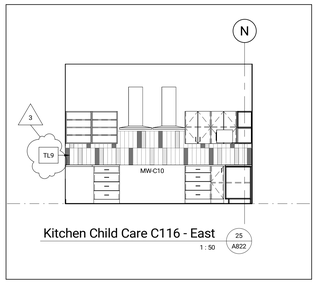


Laundry 2 C141 - East 23 A822
1 : 50

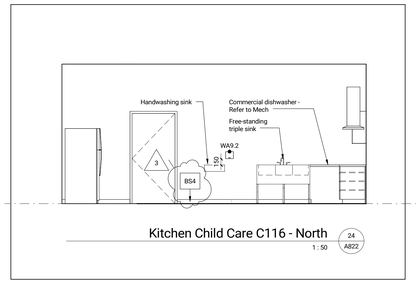


Laundry C141 - South 22 A822
1 : 50

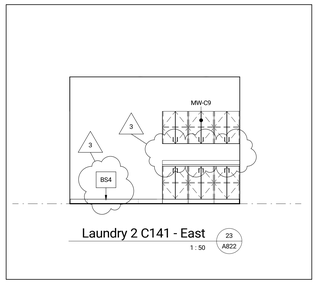


Laundry 2 C141 - West 21 A822
1 : 50

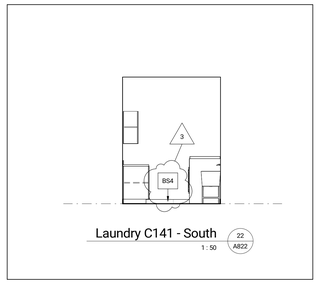


Pre-school Rm Play/Nap 8 C138 - West 20 A822
1 : 50

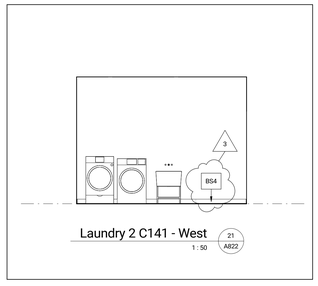


Pre-school Rm Play/Nap 8 C138 - South 19 A822
1 : 50

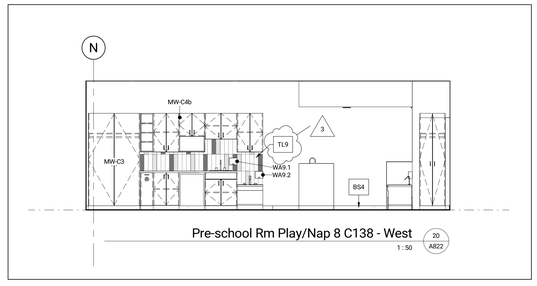


Pre-school Rm Play/Nap 8 C138 - East 18 A822
1 : 50

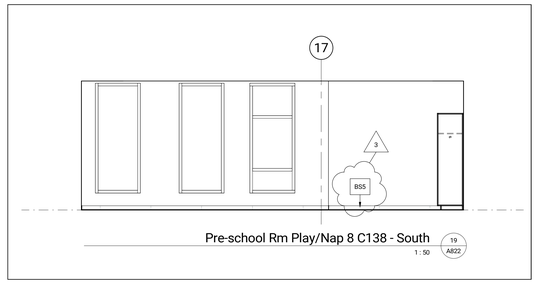


Pre-school Rm Play/Nap 8 C138 - North 17 A822
1 : 50

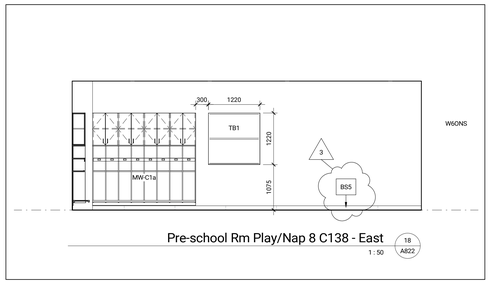


Pre-school East Vestibule C143 - West 16 A822
1 : 50

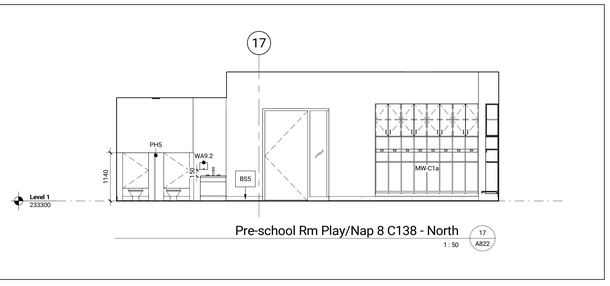


Pre-school East Vestibule C143 - South 15 A822
1 : 50

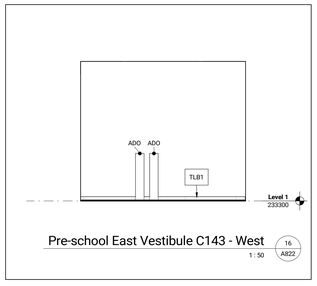


Pre-school East Vestibule C143 - East 14 A822
1 : 50

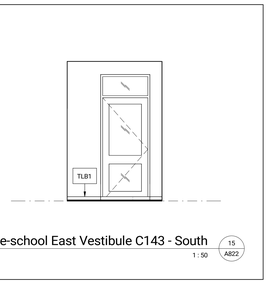


Pre-school East Vestibule C143 - North 13 A822
1 : 50

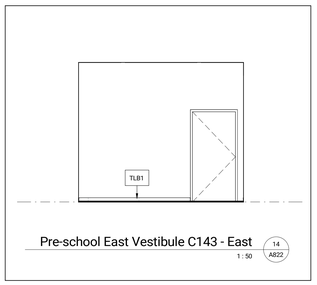


PS Change W/C 5 C135b - West 12 A822
1 : 50

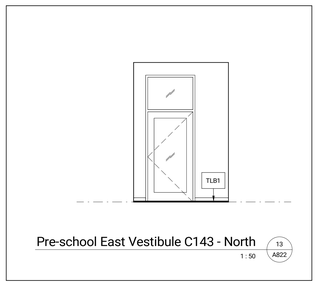


PS Change W/C 5 C135b - South 11 A822
1 : 50

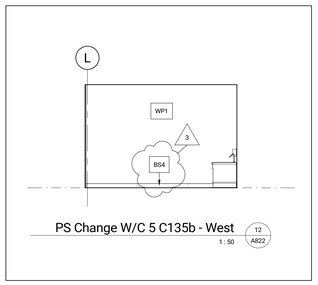


PS Change W/C 5 C135b - East 10 A822
1 : 50

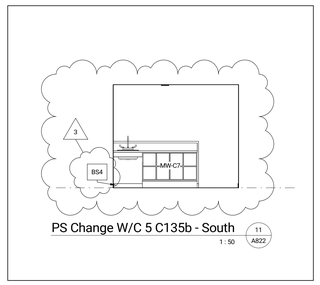


PS Change W/C 5 C135b - North 9 A822
1 : 50

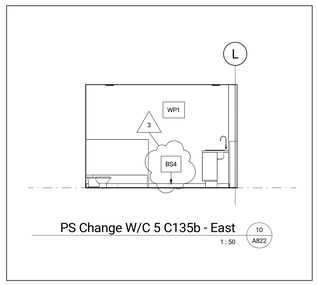


Pre-school Rm Play/Nap 5 C135 - West 8 A822
1 : 50

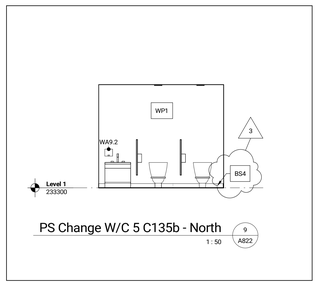


Pre-school Rm Play/Nap 5 C135 - South 7 A822
1 : 50

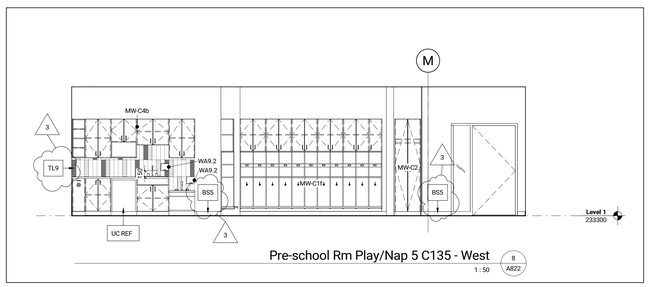


Pre-school Rm Play/Nap 5 C135 - East 6 A822
1 : 50

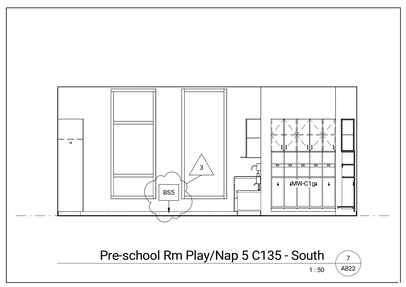


Pre-school Rm Play/Nap 5 C135 - North 5 A822
1 : 50

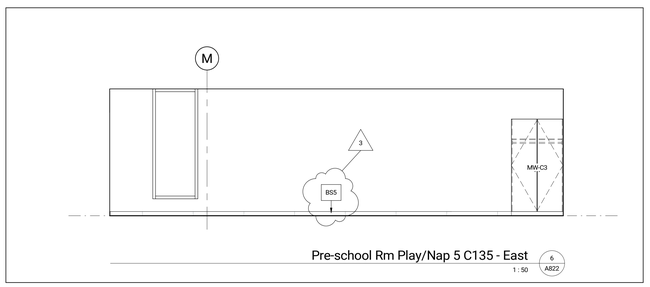


Pre-school Rm Play/Nap 4 C134 - West 4 A822
1 : 50

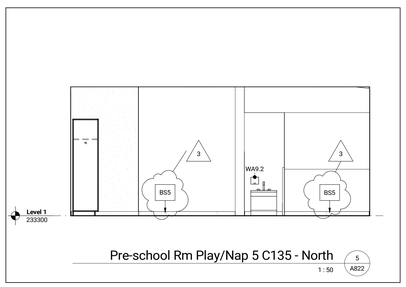


Pre-school Rm Play/Nap 4 C134 - South 3 A822
1 : 50

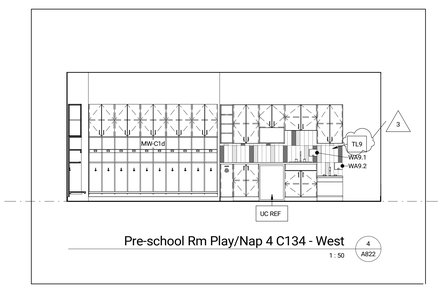


Pre-school Rm Play/Nap 4 C134 - East 2 A822
1 : 50

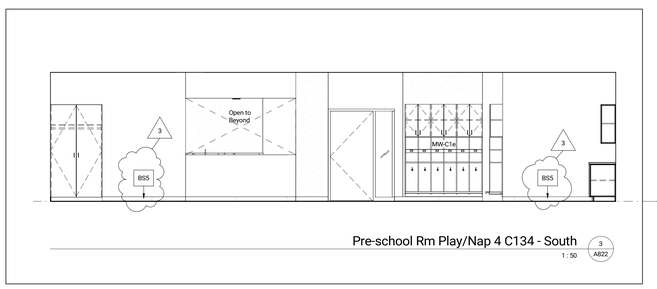


Pre-school Rm Play/Nap 4 C134 - North 1 A822
1 : 50

diamond schmitt
BrookMcIlroy/

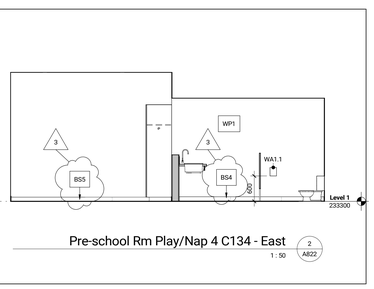Winnipeg
THE CITY OF WINNIPEG
ASSETS & PROJECT MANAGEMENT DEPARTMENT
MUNICIPAL ACCOMMODATIONS DIVISION
3-65 GARRY STREET, R3C 4K4

Manitoba
**Manitoba Public Service Delivery**
**200 - 400 Ellice Avenue,**
**Winnipeg, Manitoba**
**R3B 3M3**

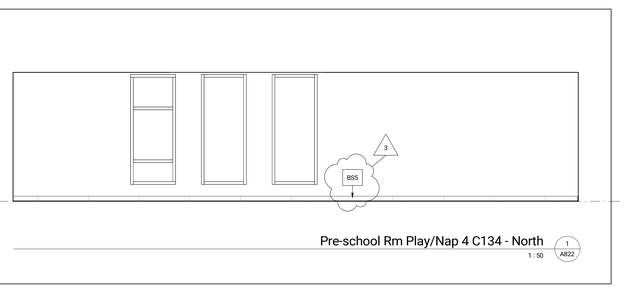**Issued**

| No. | Date | Description |
|---|---|---|
| 1 | 2025/12/11 | Contract Documents |
| 3 | 2026/01/29 | Addendum 4 |

Contractor Must Check & Verify all Dimensions on the Job.

Do Not Scale Drawings.

All Drawings, Specifications and Related Documents are the Copyright Property of the Architect and Must be Returned Upon Request. Reproduction of Drawings, Specifications and Related Documents in Part or in Whole is Forbidden Without the Written permission of the Architect.

This Drawing is Not to be Used for Construction Until Signed by the Architect.

South Winnipeg Recreation Campus Phase 1
Address: 15 Ruth Crossing & 25 Ruth Crossing
Winnipeg, MB
Consultant Project No: 220007
City of Winnipeg Project No: 2020-127
City of Winnipeg Tender No: 63-2025B

**Interior Elevations - Child Care**
As indicated
**A822**

Autodesk Docs://220007-South Winnipeg Recreation Campus R24/220007-ARCH-05A-Building-B04.rvt
2026-01-28 4:52:20 PM