


No.	Date	Description
1	2025/12/11	Contract Documents
3	2026/01/29	Addendum 4

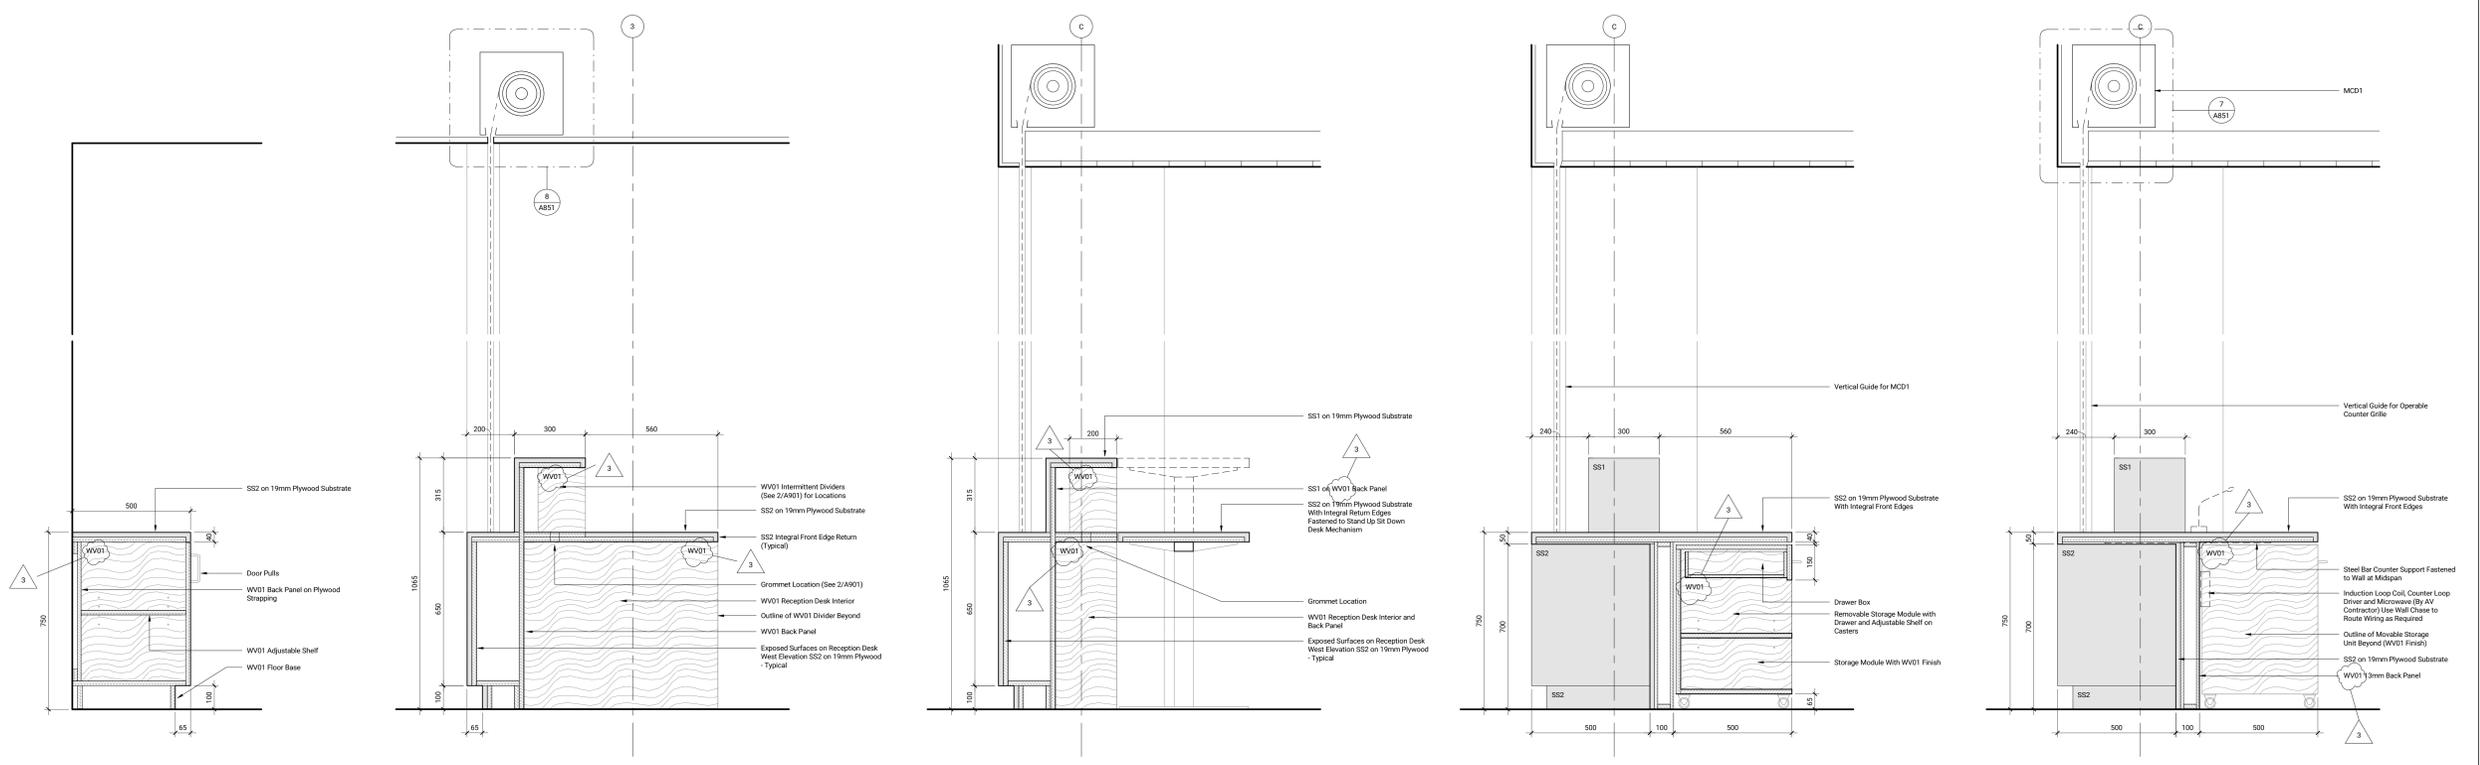


MW-R-1 Section Detail 5  
1:10 A901

MW-R-1 Section Detail 4  
1:10 A901

MW-R-1 Section Detail 3  
1:10 A901


MW-R-1 Section Detail 2  
1:10 A901

MW-R-1 Section Detail 1  
1:10 A901

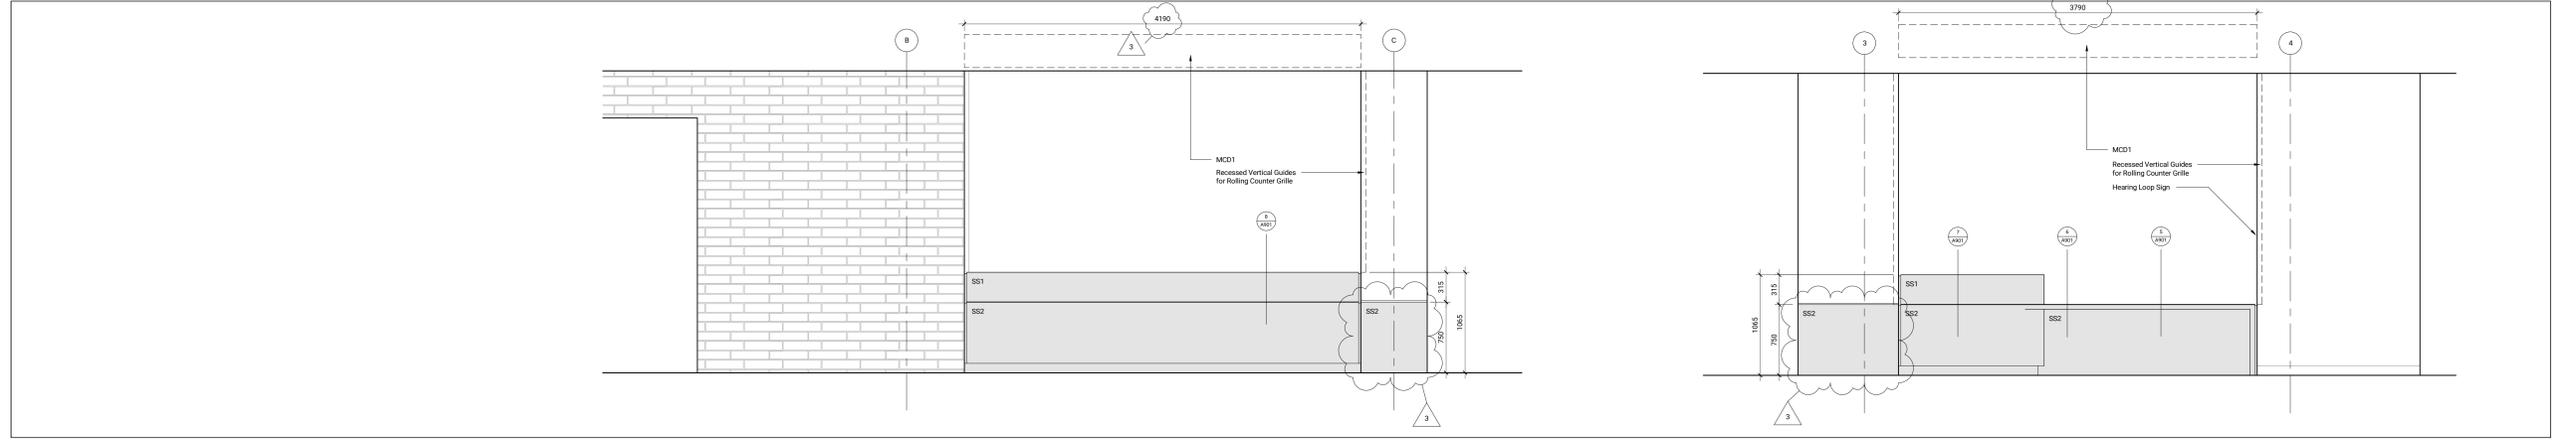

MW-R-1 West Elevation  
1:25 A901

MW-R-1 South Elevation  
1:25 A901

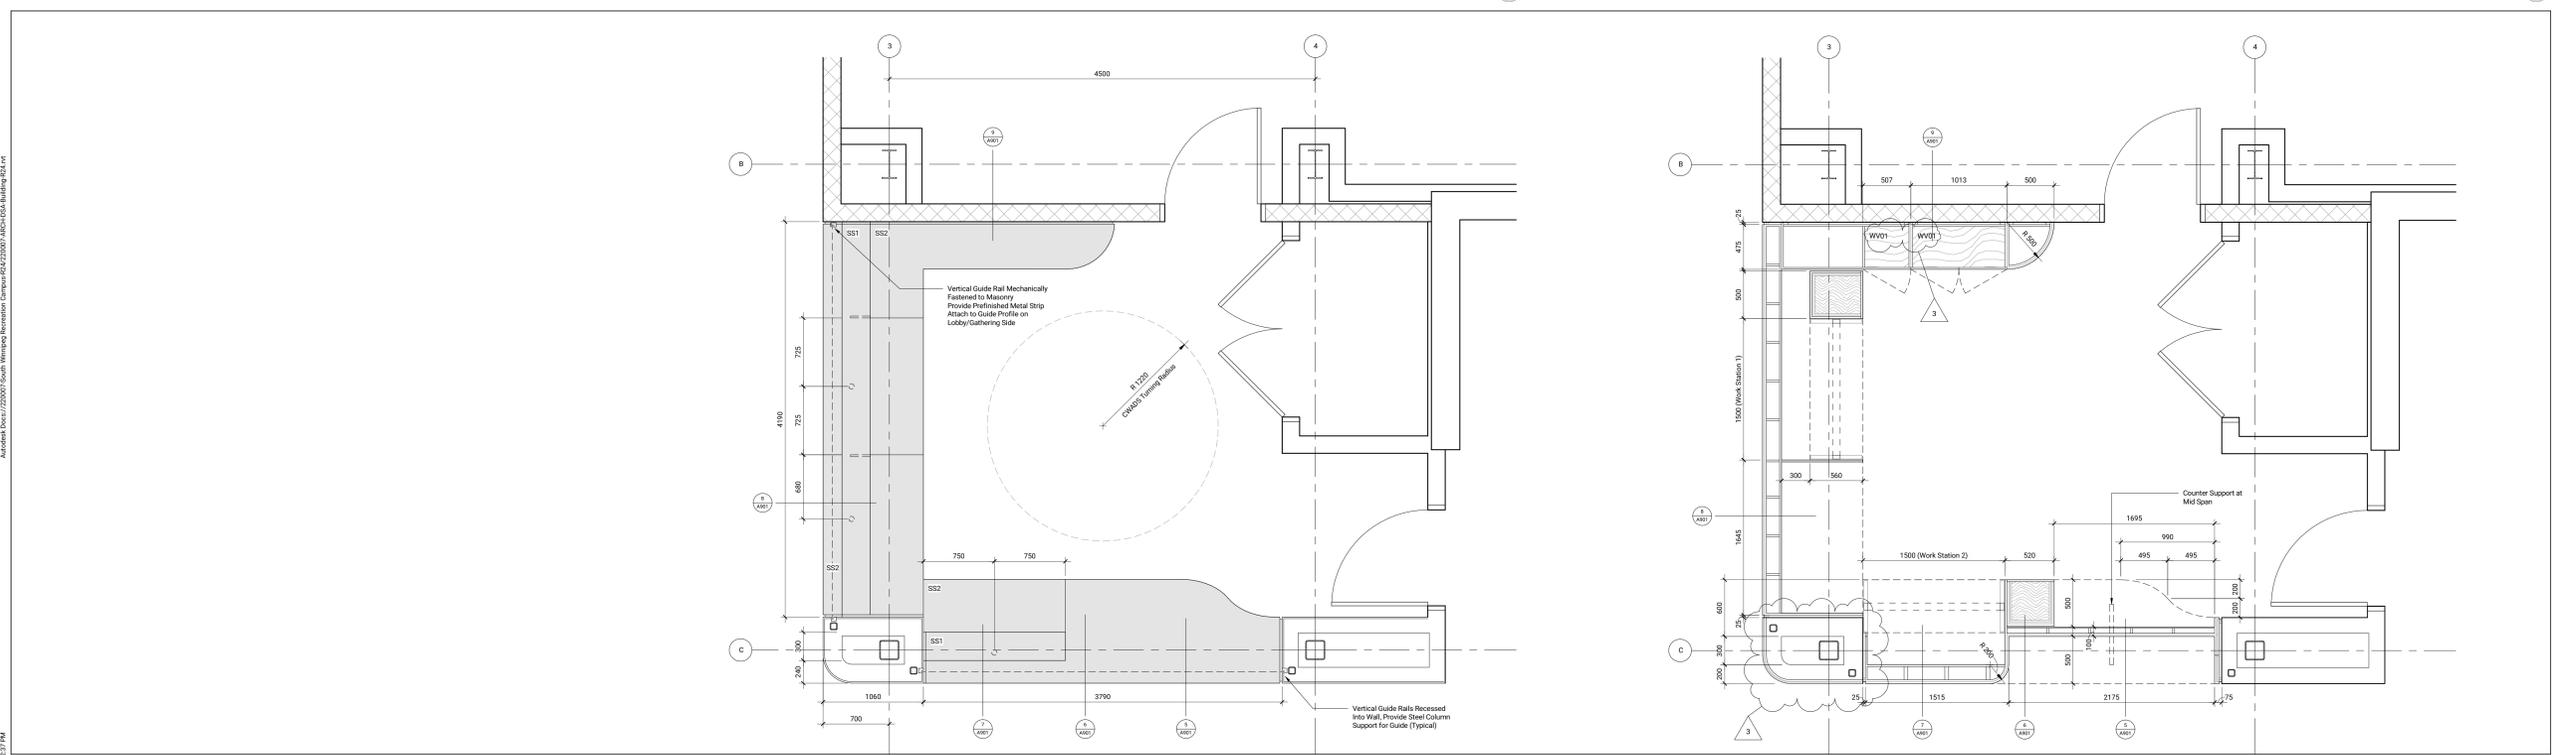

MW-R-1 Plan  
1:25 A901

MW-R-1 Plan Section  
1:25 A901


Contractor shall check & verify all dimensions on the job.  
Do Not Scale Drawings.  
All Drawings, Specifications and Related Documents are the Copyright Property of the Architect and shall be returned upon Request, Rejection or Cancellation. Specifications and Related Documents are Part of the Contract Documents and shall be returned upon Request, Rejection or Cancellation. This Drawing is Not to be Used for Construction Until Signed by the Architect.

**South Winnipeg Recreation  
Campus Phase 1**  
Address: 15 Ruth Crossing & 25 Ruth Crossing  
Winnipeg, MB  
Consultant Project No: 220007  
City of Winnipeg Project No: 2020/127  
City of Winnipeg Tender No: 63-2025B