


No.	Date	Description
1	2025/12/11	Contract Documents
3	2026/01/29	Addendum 4

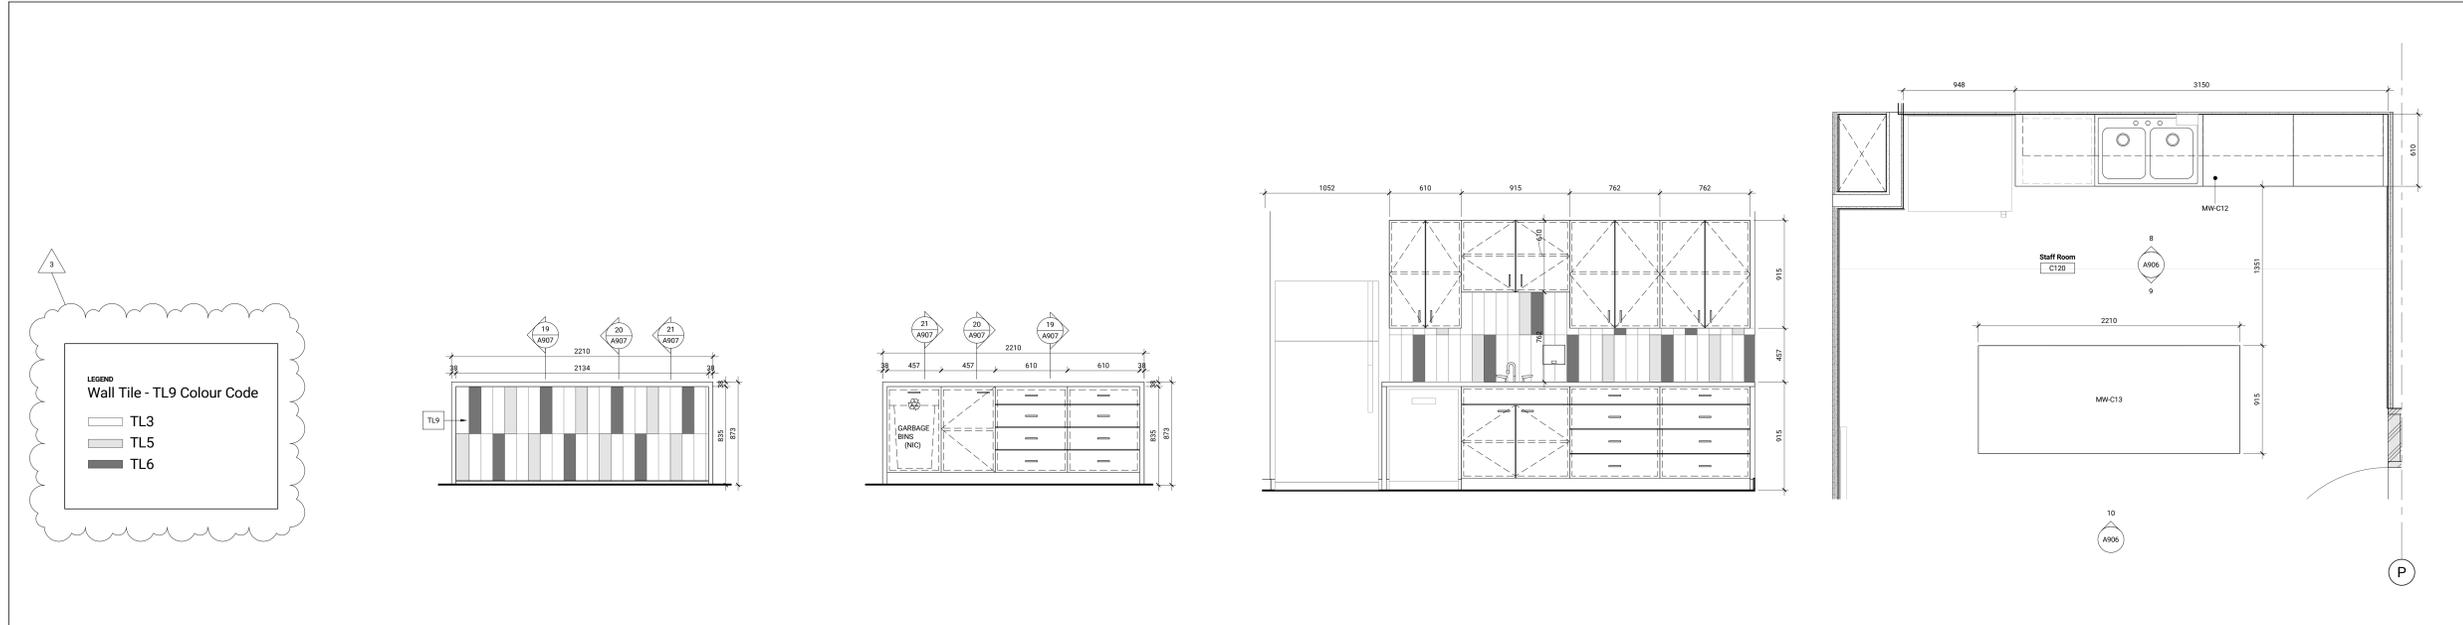


Elevation 2 - MW-C13 1:20 A906

Elevation 1 - MW-C13 1:20 A906

Elevation - MW-C12 1:20 A906

Plan - MW-C12 & C13 (Staff Room Kitchen C120) 1:20 A906

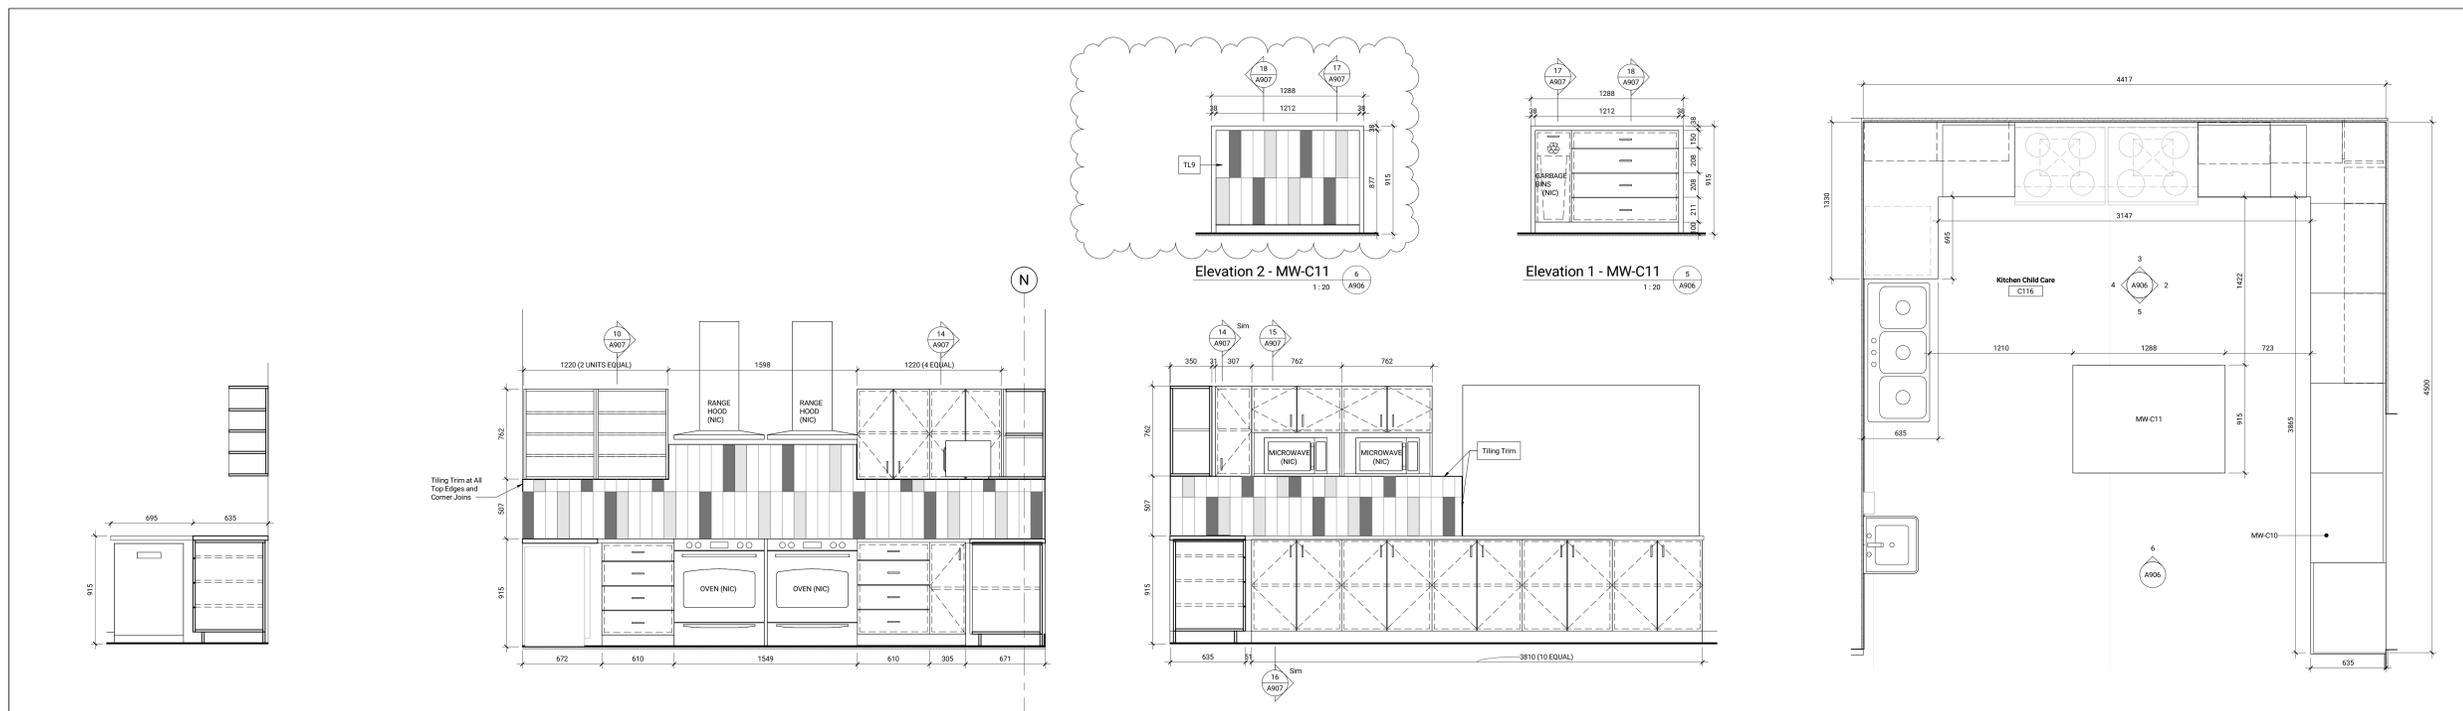

Elevation 3 - MW-C10 1:20 A906

Elevation 2 - MW-C10 1:20 A906

Elevation 1 - MW-C10 1:20 A906

Plan - MW-C10 & MW-C11 (Kitchen Child Care C116) 1:20 A906

Contractor Must Check & Verify all Dimensions on the Job.
Do Not Scale Drawings.
All Drawings, Specifications and Related Documents are the Copyright Property of the Architect and shall be returned upon Request, Reproduction or Circulation, Modification and Related Documents in Part or in Whole is Forbidden without the Written permission of the Architect.
This Drawing is Not to be Used for Construction until Signed by the Architect.

**South Winnipeg Recreation
Campus Phase 1**
Address: 15 Ruth Crossing & 25 Ruth Crossing
Winnipeg, MB
Consultant Project No: 220007
City of Winnipeg Project No: 2020/127
City of Winnipeg Tender No: 63-2025B

Millwork - Elevations - Child Care
As Indicated

A906

A:\Archives\Drawings\220007\South Winnipeg Recreation Campus\63-2025B\A906\1054_Building.dwg, 2025-01-28 14:52:38 PM