




13 WATER COIL CONNECTION (765.02)

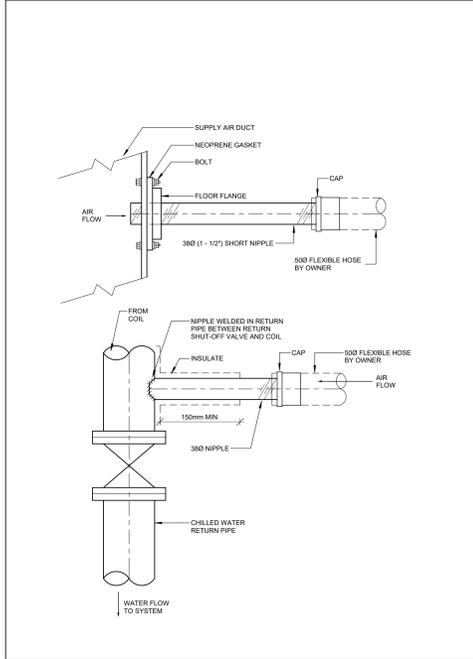


14 COOLING COIL WINTERIZATION (765.03)

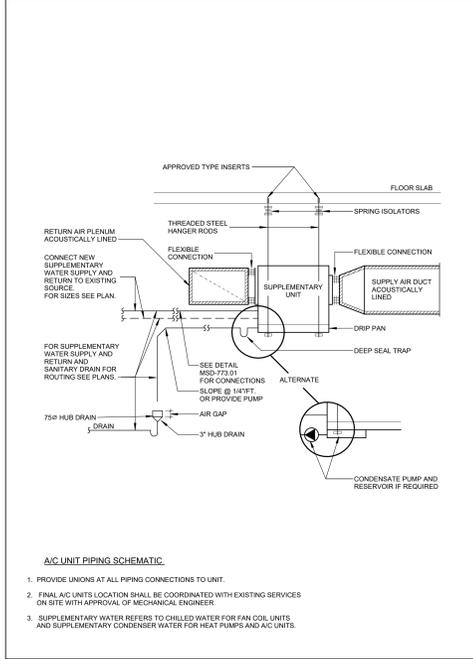


15 SUPPLEMENTARY COOLING UNIT (773.04)

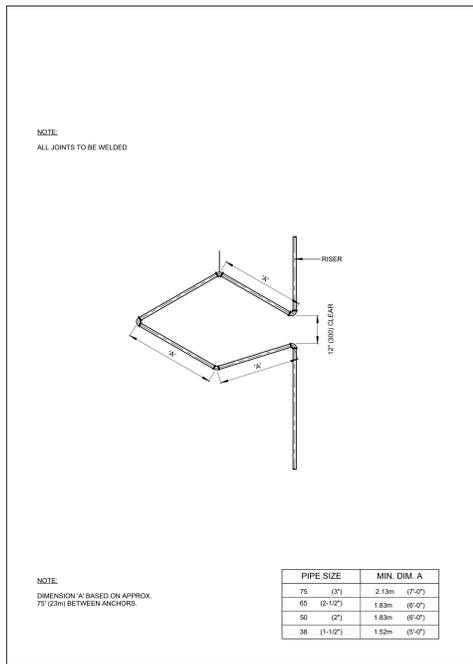


16 RISER EXPANSION LOOPS (765.02)

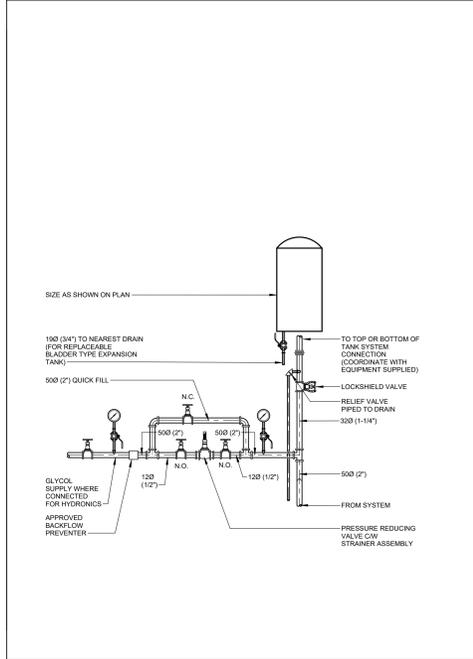


11 EXPANSION TANK PIPING SCHEMATIC (768.01)

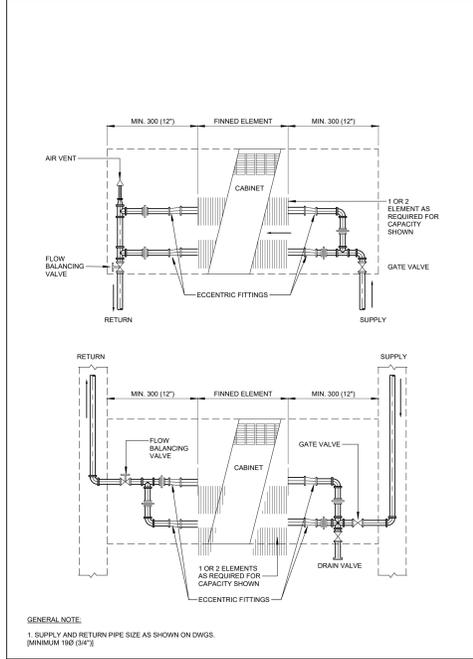


12 WALL FIN RADIATION (765.01)

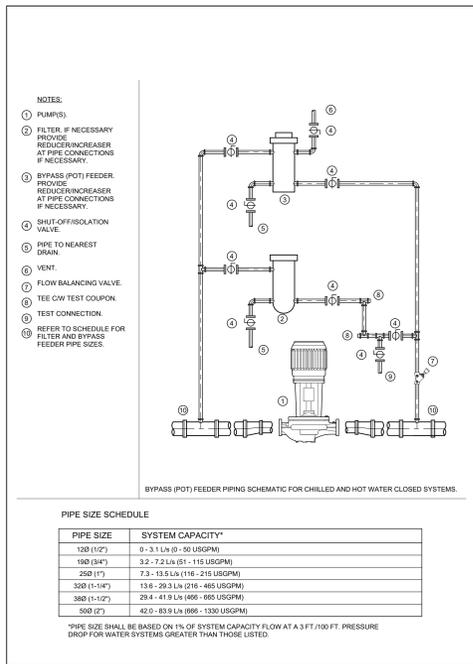


7 BYPASS (POT) FEEDER AND FILTER PIPING (765.05)

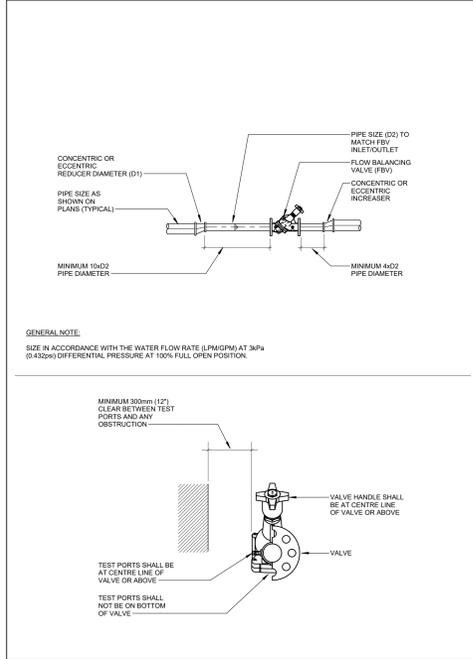


8 TYPICAL FLOW BALANCING VALVE INSTALLATION (765.08)

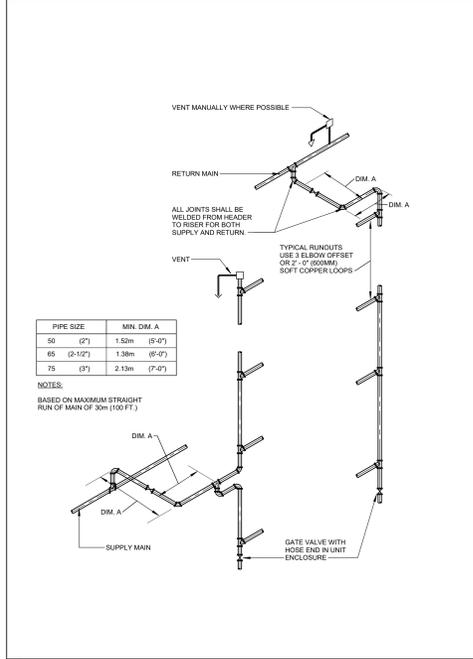


9 PIPE EXPANSION OFFSETS (765.01)

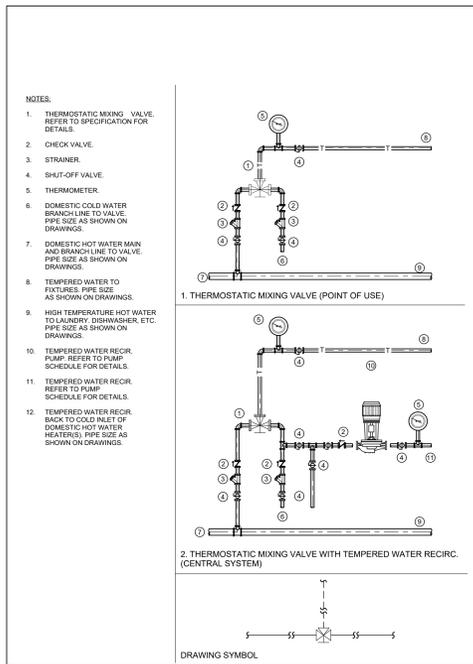


4 THERMOSTATIC MIXING VALVES (450.04)

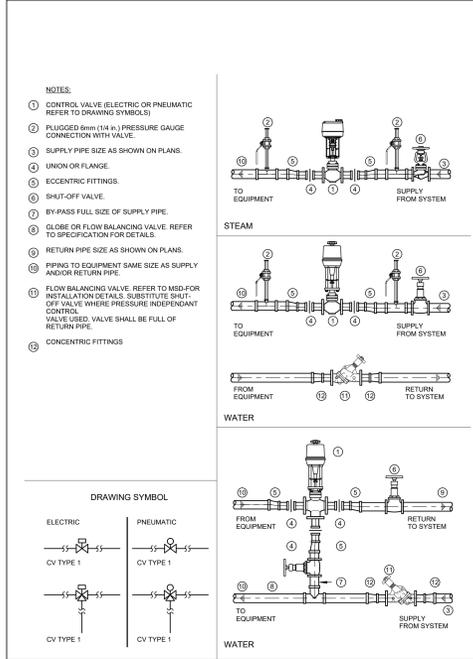


5 CONTROL VALVE TYPE 1 (765.01)

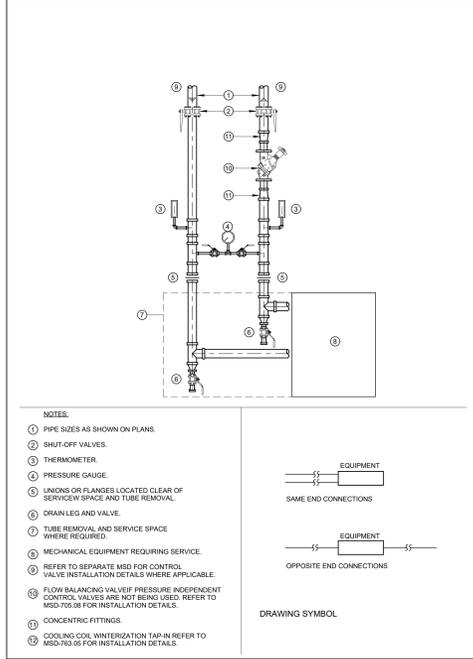


6 EQUIPMENT INSTALLATION (765.04)

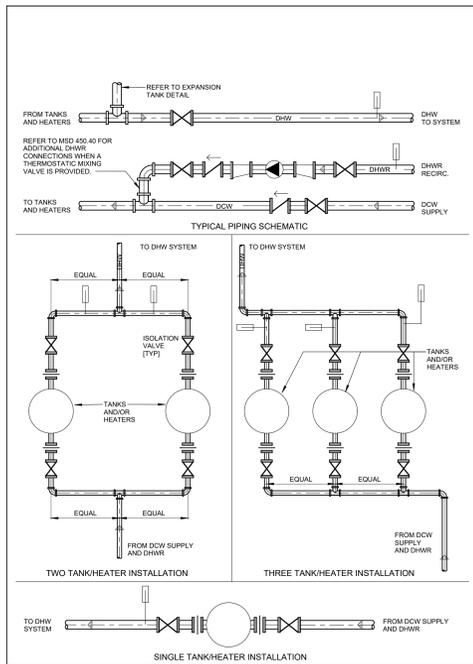

1 DOMESTIC HOT WATER HEATERS (425.01)

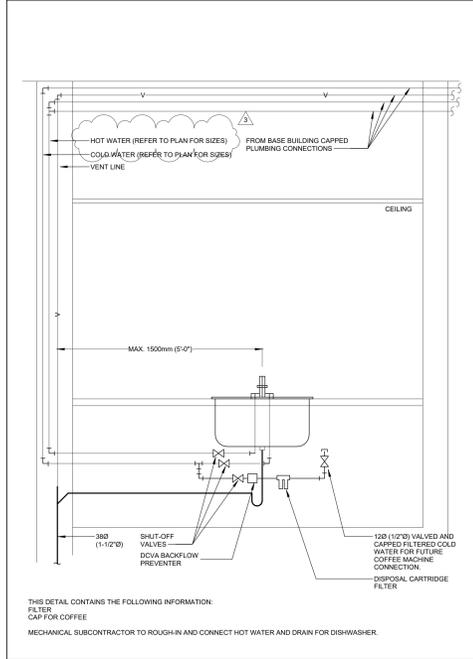

2 REC CENTRE AND CHILD CARE SINK DETAIL (450.30)

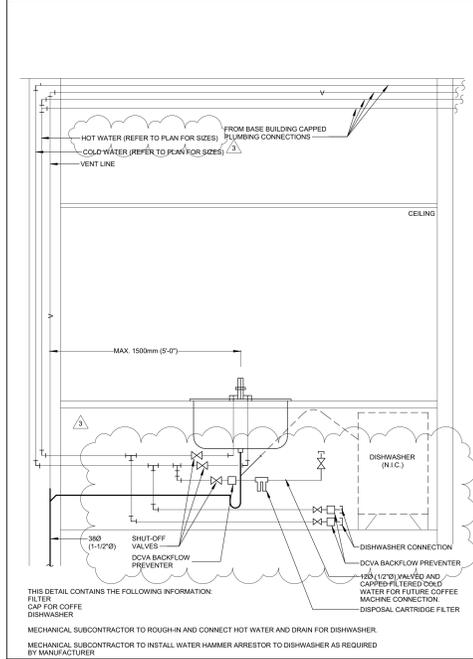

3 REC CENTRE AND CHILD CARE SINK W/ DISHWASHER DETAIL (450.31)

No.	Date	Description
1	2025.12.11	Contract Documents
2	2026.01.15	Addendum 3
3	2026.01.29	Addendum 4