

700-2025 ADDENDUM 3

SUPPLY AND DELIVERY OF Q'STRAIT® Q'POD WHEELCHAIR SECUREMENTS

ISSUED: September 4, 2025
BY: Tim VanDekerkhove
TELEPHONE NO. 204 619-2208

URGENT

**PLEASE FORWARD THIS DOCUMENT TO
WHOEVER IS IN POSSESSION OF THE
BID/PROPOSAL**

**THIS ADDENDUM SHALL BE INCORPORATED
INTO THE BID/PROPOSAL AND SHALL FORM
A PART OF THE CONTRACT DOCUMENTS**

Template Version: Add 2024-02-01

Please note the following and attached changes, corrections, additions, deletions, information and/or instructions in connection with the Bid/Proposal, and be governed accordingly. Failure to acknowledge receipt of this Addendum in Paragraph 10 of Form A: Bid/Proposal may render your Bid/Proposal non-responsive.

PART B – BIDDING PROCEDURES

Revise: B2.1 to read: The Submission Deadline is 4:00 p.m. Winnipeg time, **September 9, 2025**.


PART E – SPECIFICATIONS

Add: E2.1.4.1 Refer to 700-2025 _Addendum 03-Drawing_ SR-2354 LD for additional information specific to SR number 2354.

Add: E3: Photos

E3: PHOTO

E3.1 Photo of 2354 New Flyer XD60 stated in E2.1.2

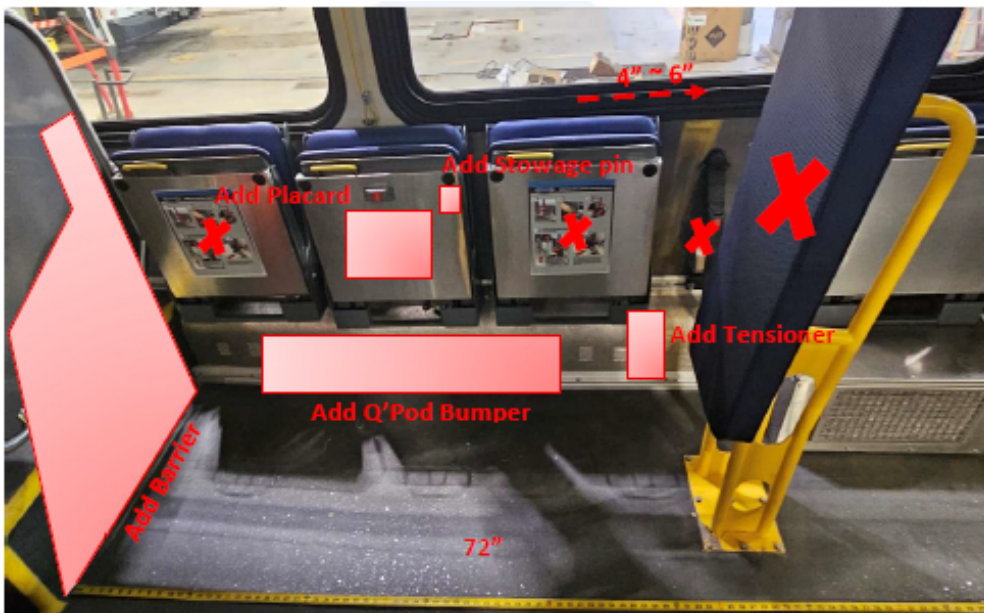

DRAWINGS

Add: 700-2025 _Addendum 03-Drawing_ SR-2354 LD