
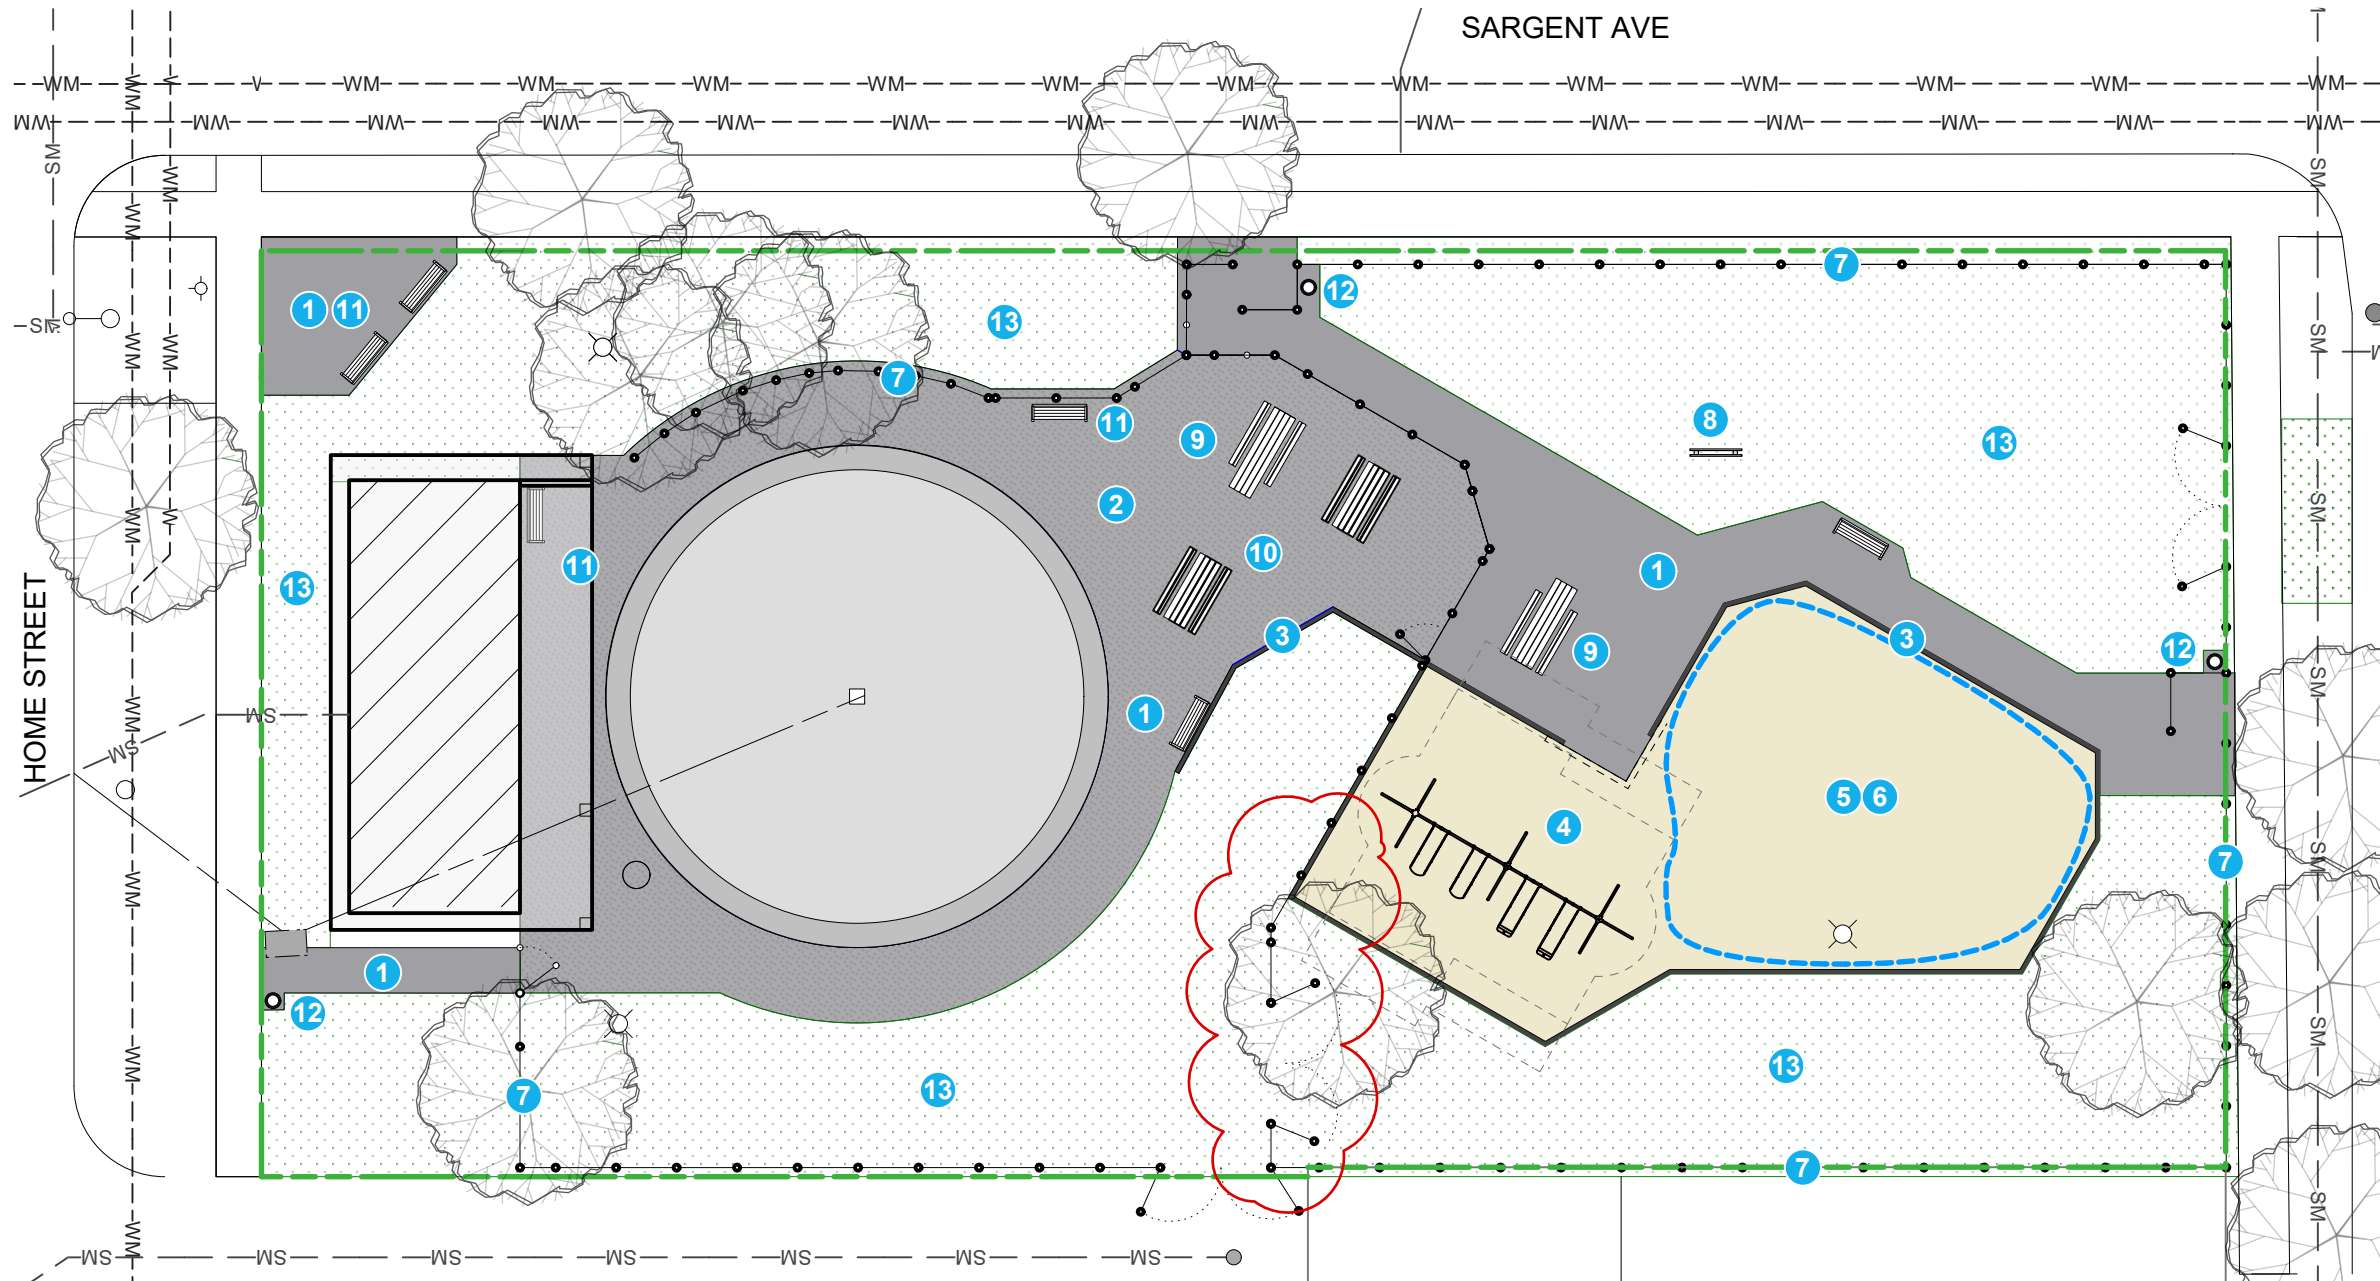


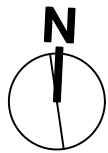


LEGEND

- 1 Supply & install asphalt pavement c/w rolled asphalt edge in to play area (SCD-648) (185 SM)
- 2 Supply & install asphalt pavement c/w concrete dust in pool area (SCD-648) 285 SM)
- 3 Supply & install two-tier timber playground edging and wall (SCD-651A / SCD-651D) (76 LM)
- 4 Supply & install two-bay swing set c/w two belt and two bucket seats
- 5 Supply and install ages 2-12 play equipment
- 6 Supply & install engineered wood fibre safety surfacing c/w additional 150mm depth of drainage stone in lieu of subsurface drainage pipe (236 SM)
- 7 Supply and install 1.5m high chain link fence c/w two (2) baffle gates as per SCD- 633 and three (3) vehicle access gates (195 LM)
- 8 Supply and install double-sided park sign as per SCD-153 (1)
- 9 Supply and install accessible picnic tables as per SCD-122A (2)
- 10 Supply and install picnic tables as per SCD-122 (2)
- 11 Supply and install surface mount benches as per SCD-121E (5)
- 12 Supply and install waste receptacles as per SCD-119 (3)
- 13 Supply and install topsoil and sod (1031 SM)

- Proposed asphalt
- Proposed concrete dust over asphalt
- Proposed safety surface area
- Proposed fencing
- Proposed topsoil and sod
- Park property line
- Existing light fixture (PROTECT)

MATERIAL NOTES

- 1.ALL WORK TO CONFORM TO CURRENT CITY OF WINNIPEG STANDARD CONSTRUCTION SPECIFICATIONS AND DETAILS UNLESS OTHERWISE NOTED.
- 2.DIMENSIONS ARE IN METERS UNLESS OTHERWISE NOTED.
- 3.DO NOT SCALE DRAWING.
- 4.PROTECT EXISTING TREES TO REMAIN, TYP.
- 5.GRADES ARE APPROXIMATE AND TO BE CONFIRMED ON SITE WITH CONTRACT ADMINISTRATOR

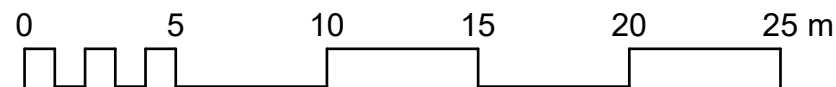

CONTRACTOR TO CONFIRM ALL DIMENSIONS AND REPORT ANY DISCREPANCIES TO CONTRACT ADMINISTRATOR PRIOR TO CONSTRUCTION. LOCATION OF UNDERGROUND STRUCTURES AS SHOWN ARE BASED ON THE BEST INFORMATION AVAILABLE BUT NO GUARANTEE IS GIVEN THAT ALL EXISTING UTILITIES ARE SHOWN OR THAT THE GIVEN LOCATIONS ARE EXACT. CONFIRMATION OF EXISTENCE AND EXACT LOCATION OF ALL SERVICES MUST BE OBTAINED FROM THE INDIVIDUAL UTILITIES BEFORE PROCEEDING WITH CONSTRUCTION.



THE CITY OF WINNIPEG
Planning, Property and Development Department
Planning and Land Use Division
Unit 15 - 30 Fort Street, Winnipeg, MB, (R3C 4X5)

DESIGNED BY

CHECKED BY

DRAWN BY

IM

APPROVED BY

MANAGER,
PARK AND OPEN SPACES

DATE

HORIZ. SCALE

1:250

VERT. SCALE

DATE

Oct 9 2025

MANAGER,
PLANNING AND LAND USE DIVISION

DATE

DRAWING TITLE

**Home Street Playground
Playground Redevelopment
Materials Plan - Addendum 1**

SITE ADDRESS 772 Sargent Avenue

DRAWING NO.

H.2-D.2-R1

BID OPPORTUNITY NO.
755-2025