


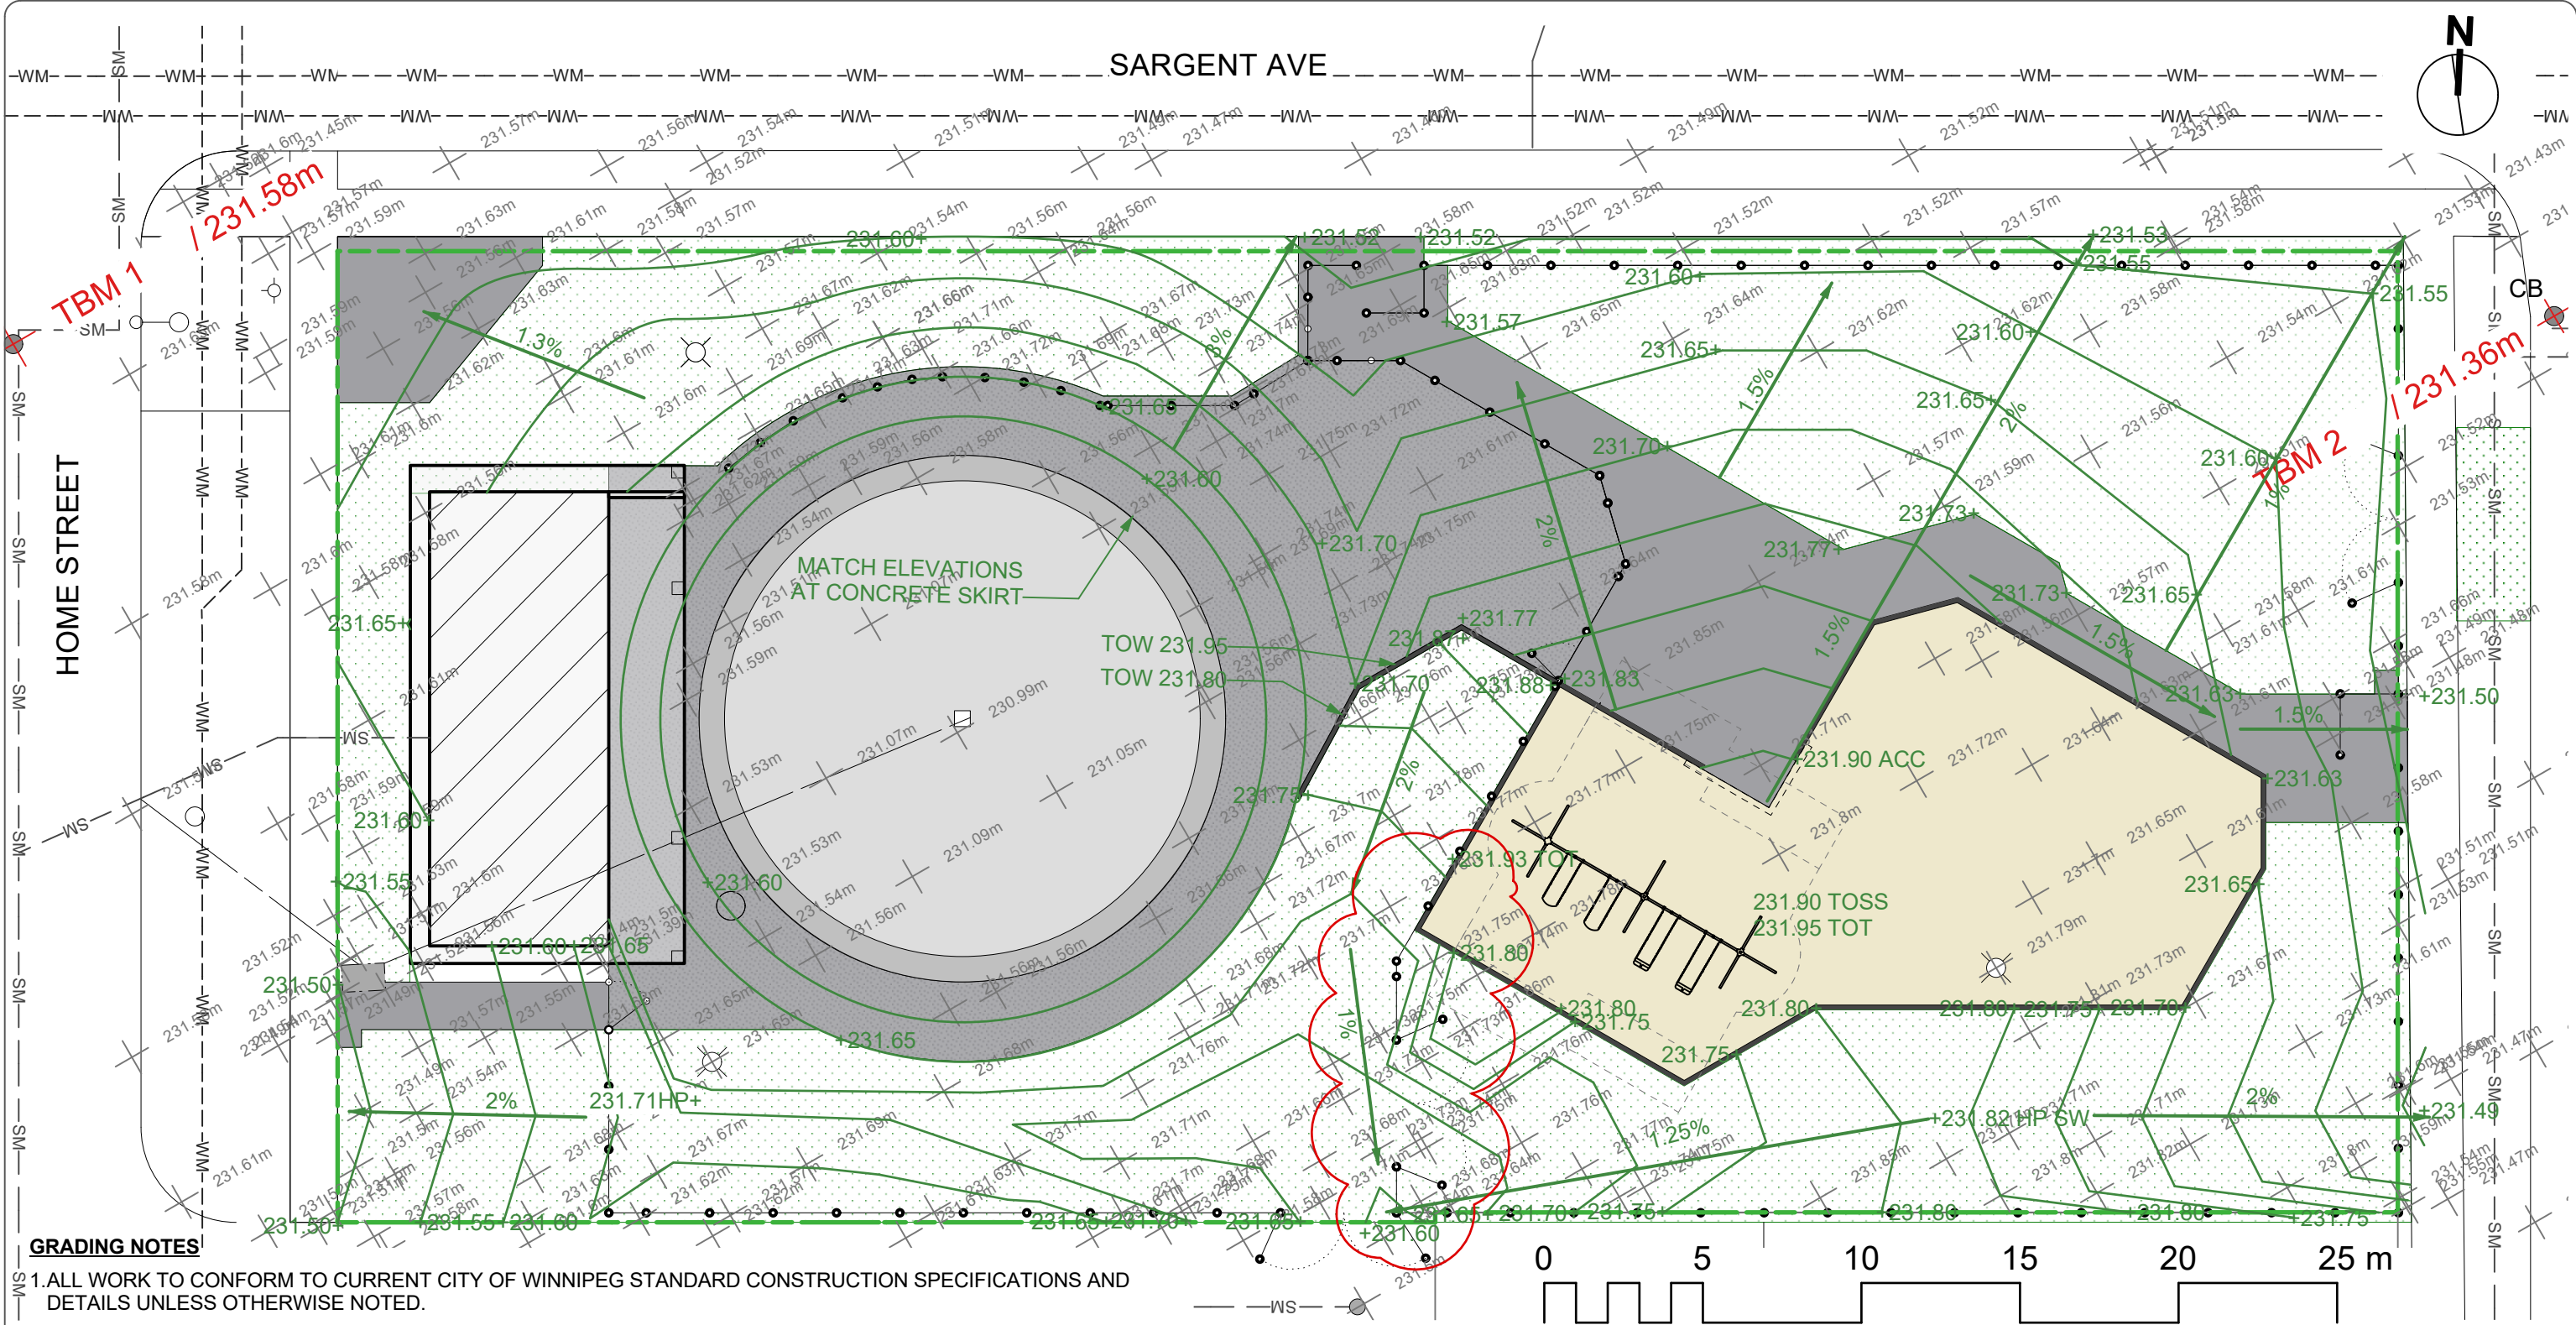

GRADING NOTES

1. ALL WORK TO CONFORM TO CURRENT CITY OF WINNIPEG STANDARD CONSTRUCTION SPECIFICATIONS AND DETAILS UNLESS OTHERWISE NOTED.
2. DIMENSIONS ARE IN METERS UNLESS OTHERWISE NOTED.
3. DO NOT SCALE DRAWING.
4. PROTECT EXISTING TREES TO REMAIN, TYP.
5. GRADES ARE APPROXIMATE AND TO BE CONFIRMED ON SITE WITH CONTRACT ADMINISTRATOR
6. PAVEMENT SLOPE: DIRECTIONAL SLOPE 5% MAX., CROSS SLOPE 2% MAX., UNLESS OTHERWISE NOTED.

TBM 1: Centre of manhole on Home St.
south of Sargent Avenue

TBM 2: Centre of CB on Simcoe St.
south of Sargent Avenue

CONTRACTOR TO CONFIRM ALL DIMENSIONS AND REPORT ANY DISCREPANCIES TO CONTRACT ADMINISTRATOR PRIOR TO CONSTRUCTION. LOCATION OF UNDERGROUND STRUCTURES AS SHOWN ARE BASED ON THE BEST INFORMATION AVAILABLE BUT NO GUARANTEE IS GIVEN THAT ALL EXISTING UTILITIES ARE SHOWN OR THAT THE GIVEN LOCATIONS ARE EXACT. CONFIRMATION OF EXISTENCE AND EXACT LOCATION OF ALL SERVICES MUST BE OBTAINED FROM THE INDIVIDUAL UTILITIES BEFORE PROCEEDING WITH CONSTRUCTION.



THE CITY OF WINNIPEG
Planning, Property and Development Department
Planning and Land Use Division
Unit 15 - 30 Fort Street, Winnipeg, MB, (R3C 4X5)

DESIGNED BY	CHECKED BY
DRAWN BY IM	APPROVED BY
HORIZ. SCALE 1:200	
VERT. SCALE	
DATE Oct 9 2025	

MANAGER, PARK AND OPEN SPACES	DATE
MANAGER, PLANNING AND LAND USE DIVISION	DATE

DRAWING TITLE Home Street Playground Playground Redevelopment Grading Plan - Addendum 1
SITE ADDRESS 772 Sargent Avenue

DRAWING NO. H.2-D.3-R1
BID OPPORTUNITY NO. 755-2025