


LEGEND:


EXISTING GARBAGE (APPROX.)

NOTES:

- TOPOGRAPHY BASED ON CITY OF WINNIPEG DRONE SURVEY MAY, 2025. TRANSVERSE MERCATOR PROJECTION, NAD 1983 CSRS, ZONE 14.
- FOR DETAILED TEST HOLE LOGS AND DESCRIPTION OF SITE GEOLOGY REFER TO SPECIFICATIONS.
- BURIED ALIGNMENT IS APPROXIMATE AND DEPTH OF BURIAL IS TO BE CONFIRMED PRIOR TO ANY EXCAVATION IN WORK AREAS. WORK AREA LIMITS TO BE DEFINED BY CITY OF WINNIPEG IN AGREEMENT WITH CONTRACTOR.

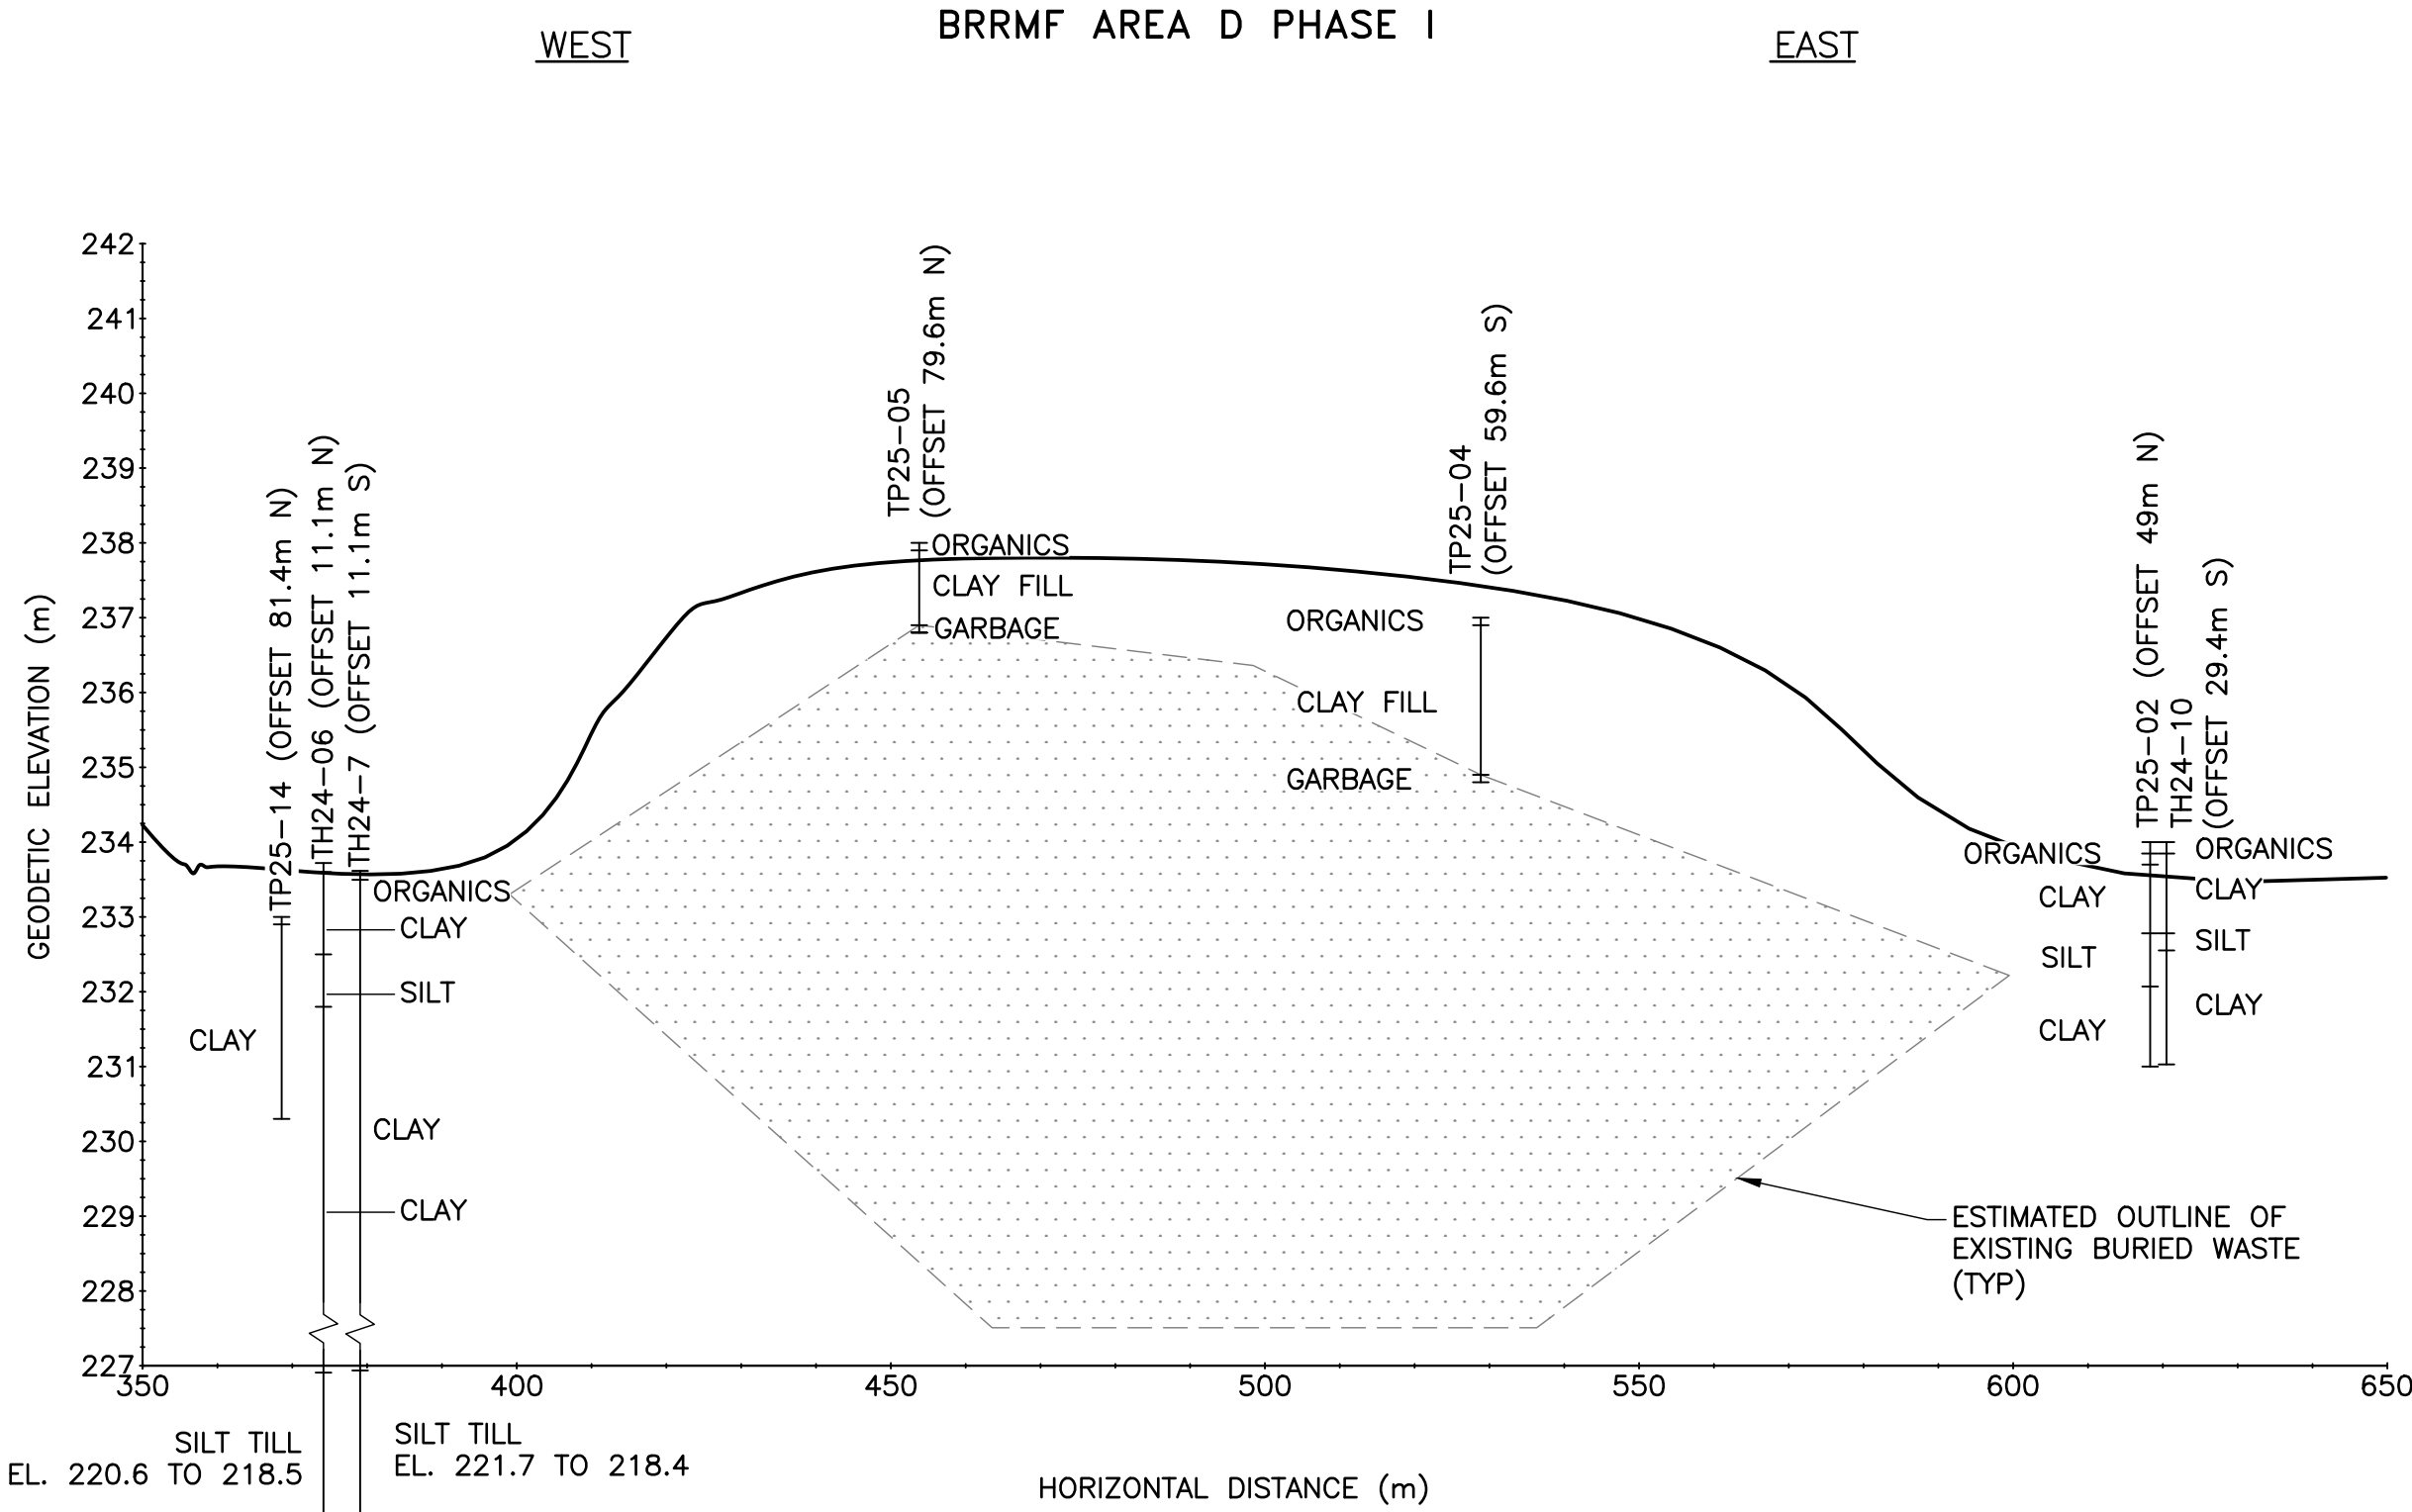


1 SECTION
G01 SCALE: 1:1000 METRIC
VERT. EXAGGERATION x10

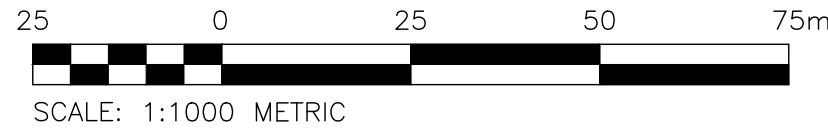

NORTH

BRRMF AREA D PHASE I

SOUTH

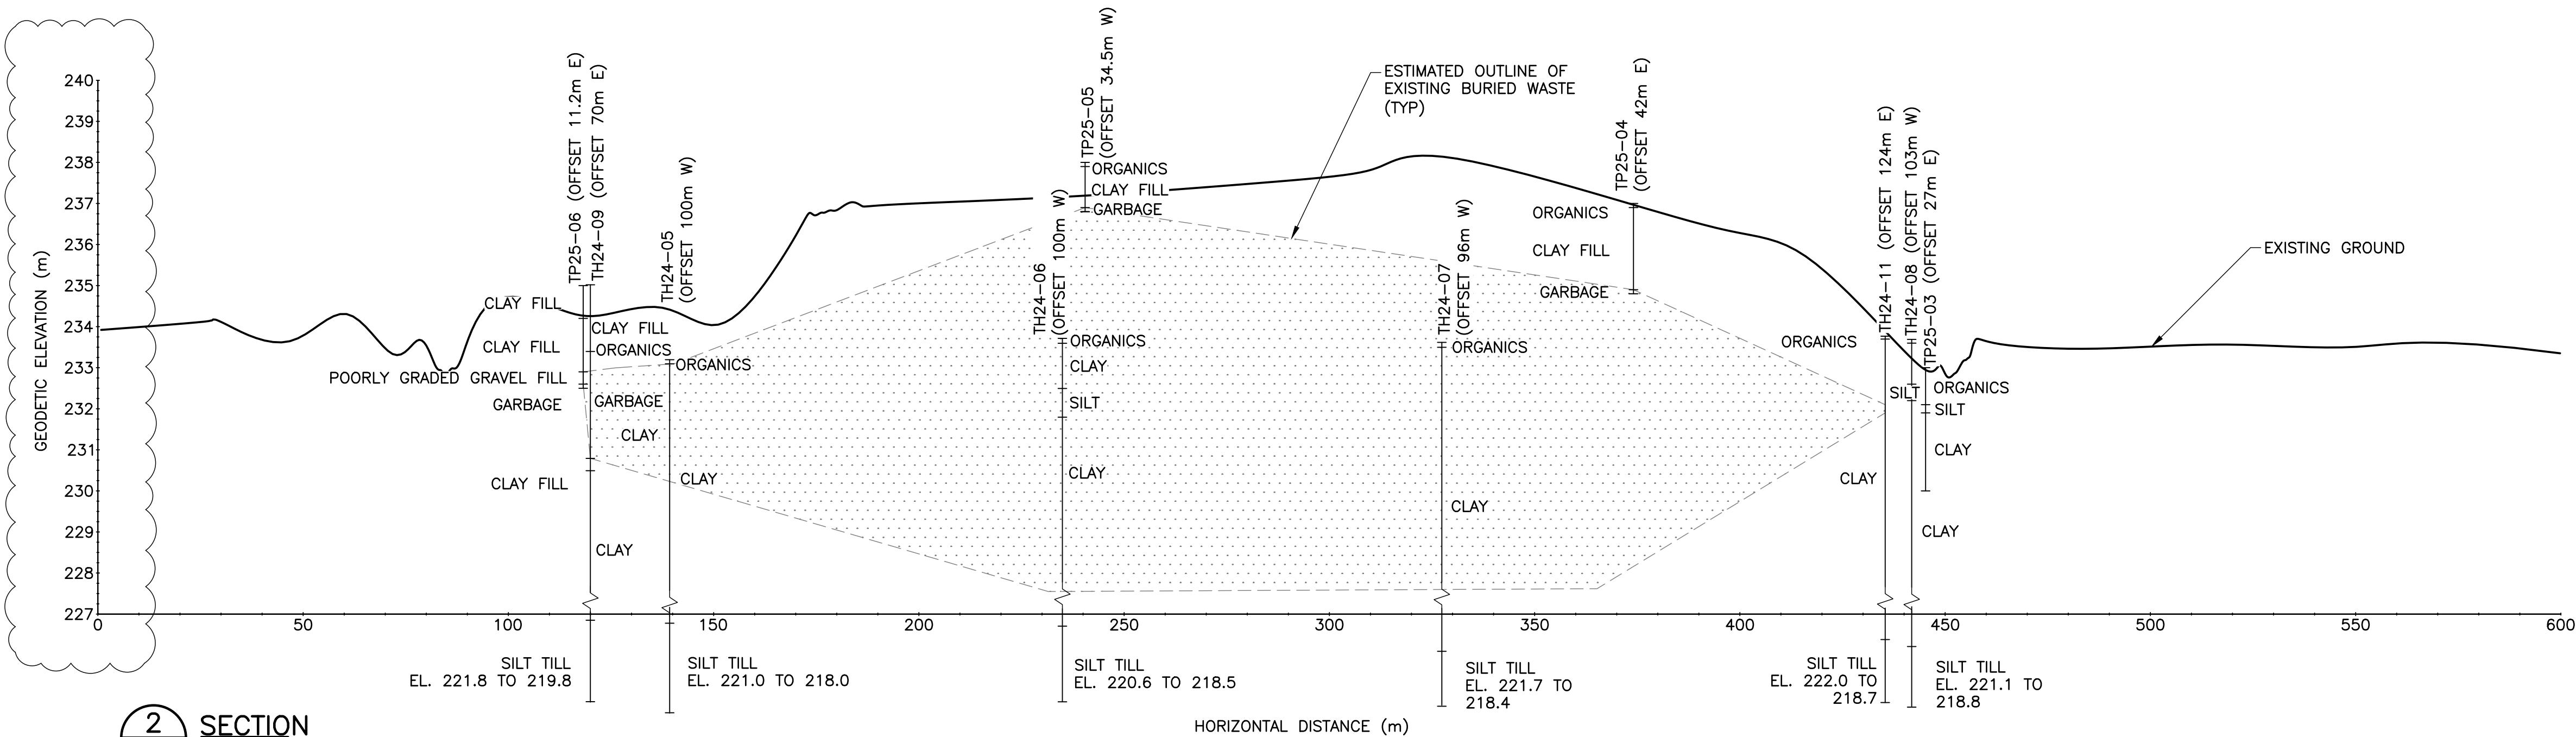

2 SECTION
G01 SCALE: 1:1000 METRIC
VERT. EXAGGERATION x10

FOR TENDER ONLY
NOT TO BE USED FOR CONSTRUCTION

LOCATIONS OF UNDERGROUND STRUCTURES AS SHOWN ARE BASED ON THE BEST INFORMATION AVAILABLE. BUT NO GUARANTEE IS GIVEN THAT ALL EXISTING UTILITIES ARE SHOWN OR THAT THE GIVEN LOCATIONS ARE EXACT. CONFIRMATION OF EXISTENCE AND EXACT LOCATION OF ALL SERVICES MUST BE OBTAINED FROM THE INDIVIDUAL UTILITIES BEFORE PROCEEDING WITH CONSTRUCTION

METRIC

WHOLE NUMBERS INDICATE MILLIMETRES
DECIMALIZED NUMBERS INDICATE METRES

WARNING

NOTIFY THE GAS COMPANY OF THE PROPOSED LOCATION OF EXCAVATION.
TAKE PRECAUTION TO AVOID DAMAGE TO GAS COMPANY INSTALLATIONS.
SEE PROVINCIAL REGULATION 210/72 FOR DETAILS.

**ENGINEERS
GEOSCIENTISTS
MANITOBA**
Certificate of Authorization
KGS Group
No. 245

LOCATION APPROVED UNDERGROUND STRUCTURES		B.M. ELEV.		KGS GROUP		ENGINEER'S SEAL		THE CITY OF WINNIPEG WATER AND WASTE DEPARTMENT SOLID WASTE SERVICES	
SUPV. U/G STRUCTURES COMMITTEE		CONSTRUCTION COMPLETION DATE:		DESIGNED BY IH		CHECKED BY NB		BRADY ROAD RESOURCE MANAGEMENT FACILITY (BRRMF)	
NOTE: LOCATION OF UNDERGROUND STRUCTURES AS SHOWN ARE BASED ON THE BEST INFORMATION AVAILABLE BUT NO GUARANTEE IS GIVEN THAT ALL EXISTING UTILITIES ARE SHOWN OR THAT THE GIVEN LOCATIONS ARE EXACT. CONFIRMATION OF EXISTENCE AND EXACT LOCATION OF ALL SERVICES MUST BE OBTAINED FROM THE INDIVIDUAL UTILITIES BEFORE PROCEEDING WITH CONSTRUCTION.				DRAWN BY JP		APPROVED BY TK		AREA D CONTINGENCY CELL	
				SCALE: HORIZONTAL 1:1000 VERTICAL -		RELEASED FOR CONSTRUCTION		STRATIGRAPHIC SECTIONS 1, 2	
				DATE 2025 07 15		DATE -		SHEET 02 OF 05	
				PLOT DATE: 2025 09 15		CONSULTANT DRAWING NUMBER G02		CITY DRAWING NUMBER 1-0400L-C0023-001	
				BID OPPORTUNITY: CONTRACT NUMBER:		FILE PATH: FILE NAME:			