
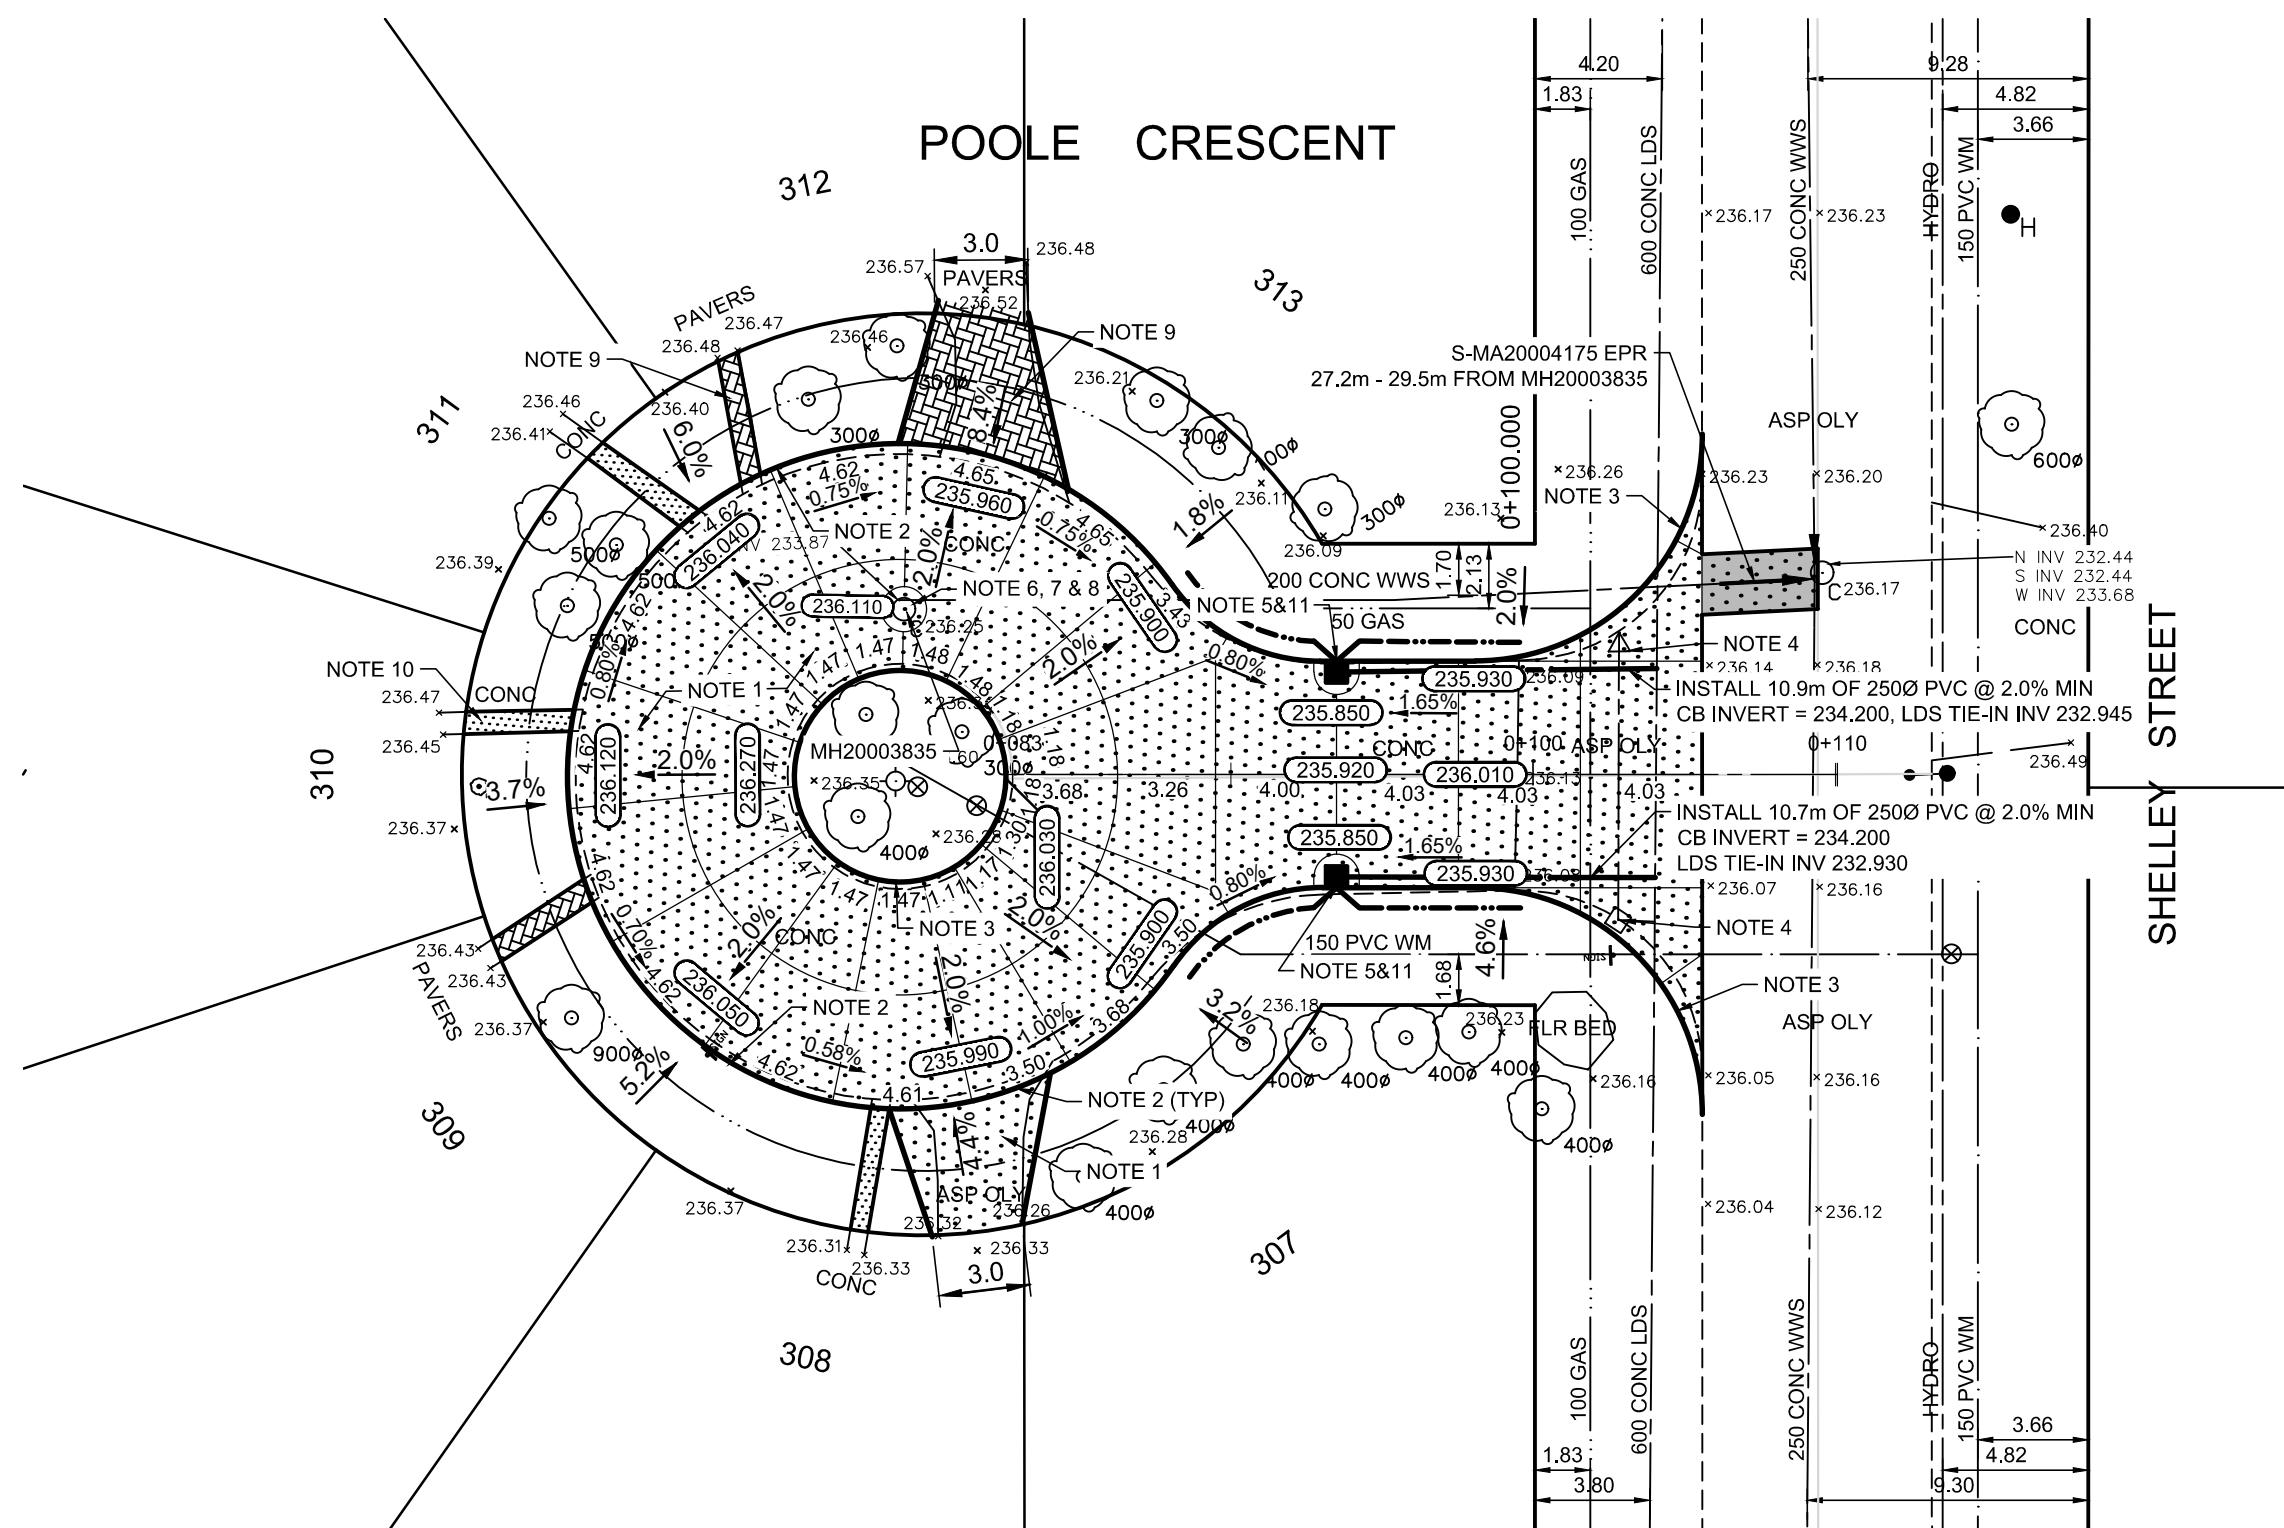
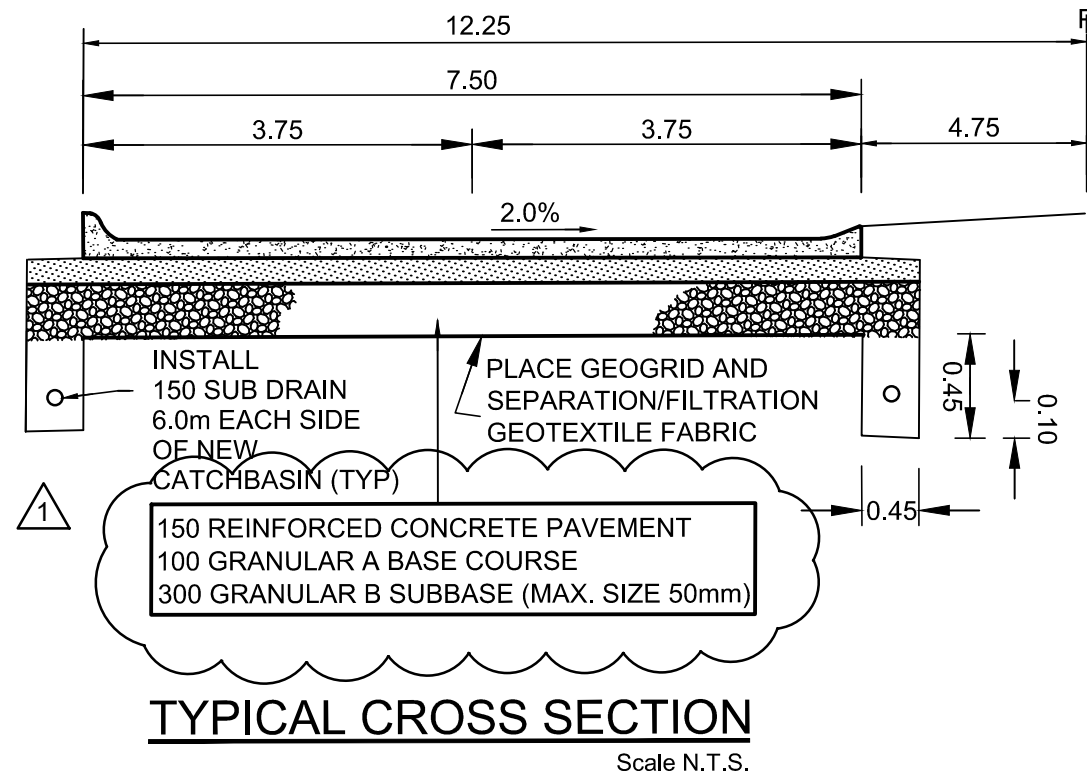


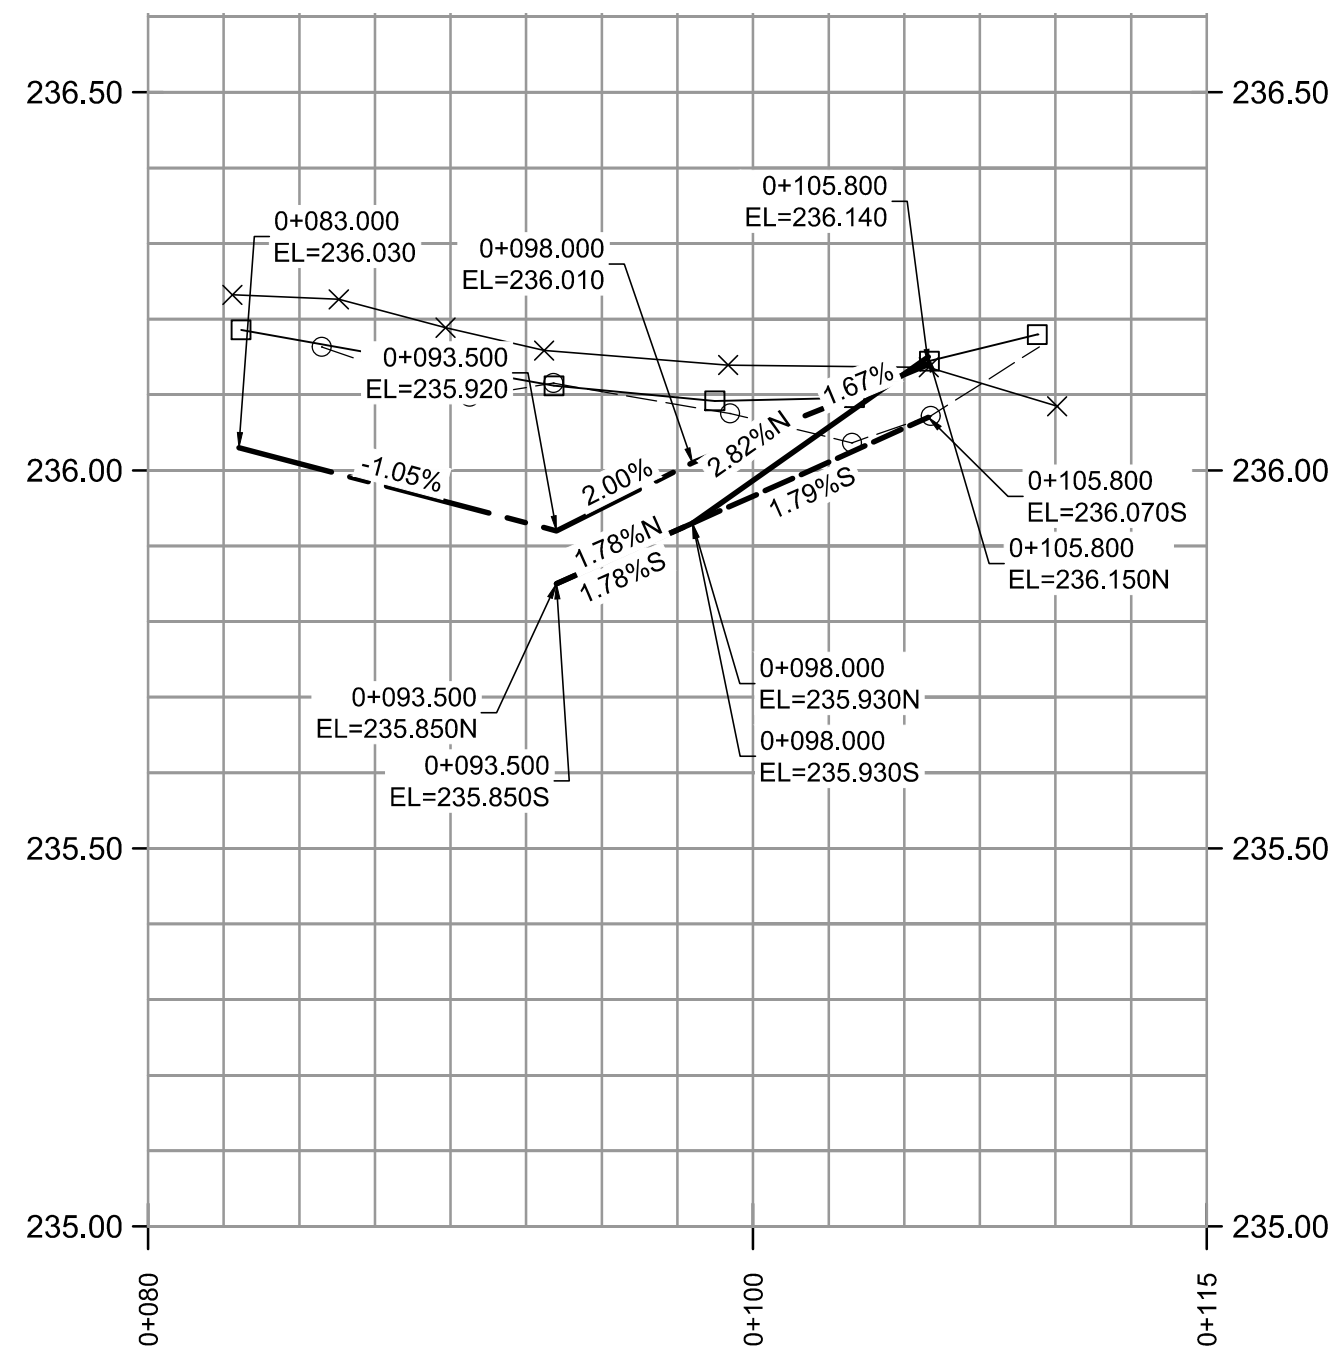

- REFERENCE NOTES:**
- A. PAVEMENT DIMENSIONS ARE TO BACK OF CURB
 - B. PROPERTY LINES OBTAINED FROM CITY OF WINNIPEG L.B.I.S., AND NO SCALE FACTOR WAS APPLIED
 - C. REFER TO AECOM FIELD BOOK NO. 5181
- CONSTRUCTION NOTES:**
- 1. REMOVE EXISTING PAVEMENT AND CONSTRUCT NEW 150mm REINFORCED CONCRETE PAVEMENT
 - 2. CONSTRUCT NEW CONCRETE MOUNTABLE CURB (120mm HT. INTEGRAL)
 - 3. CONSTRUCT NEW CONCRETE MODIFIED BARRIER CURB (180mm HT. INTEGRAL)
 - 4. REMOVE EXISTING CATCH BASIN / CATCH PIT / CURB INLET AND ABANDON LEAD
 - 5. INSTALL NEW CURB AND GUTTER INLET c/w 1800mm CATCH BASIN (SD-024) AND CONNECT NEW 250mm LEAD TO EXISTING 600 CONCRETE LDS
 - 6. ADJUST MANHOLE / CATCH BASIN TO GRADE
 - 7. INSTALL NEW CAST IRON RISER RING
 - 8. REMOVE EXISTING FRAME AND COVER AND PLACE NEW STANDARD FRAME AND SOLID COVER (AP-006 / AP-007)
 - 9. ADJUST EXISTING PAVING STONES / PATIO BLOCKS TO GRADE
 - 10. RENEW EXISTING 100mm PRIVATE CONCRETE SIDEWALK
 - 11. INSTALL NEW SUBDRAINS 6.0m EACH SIDE OF CATCH BASIN

**ENGINEERS
GEOSCIENTISTS
MANITOBA**

Certificate of Authorization
AECOM Canada ULC
No. 4671 Date: 04/03/2025

METRIC
WHOLE NUMBERS INDICATE MILLIMETRES
DECIMALIZED NUMBERS INDICATE METRES

150 mm W.M.	WATERMAIN	150 mm W.M.	HYDRO	HYDRO	HYDRO	HYDRO	HYDRO	HYDRO
◇	HYDRANT	◆	M.T.S.	---	---	---	---	---
⊙	VALVE	⊙	CONCRETE	---	---	---	---	---
300mm L.D.S.	LAND DRAINAGE SEWER	300mm L.D.S.	ASPHALT	---	---	---	---	---
250mm W.W.S.	WASTEWATER SEWER	250mm W.W.S.	PROPERTY LINE	---	---	---	---	---
○	MANHOLE	●	SURVEY BAR	---	---	---	---	---
□	CATCH BASIN	■	ELEVATION	---	---	---	---	---
▽	CATCH PIT	▼	TREE	---	---	---	---	---
↑	TRAFFIC SIGNAL POLE	---	SIDEWALK RAMP	---	---	---	---	---
↑	STREET LIGHT	---	CONCRETE SIDEWALK	---	---	---	---	---
---	GAS	---	FENCE	---	---	---	---	---
EXISTING	LEGEND - PLAN	PROPOSED	EXISTING	LEGEND - PLAN	PROPOSED	EXISTING	LEGEND - PROFILE	PROPOSED

LOCATION APPROVED UNDERGROUND STRUCTURES	DATE
SUPV. U/G STRUCTURES COMMITTEE	
NOTE: LOCATION OF UNDERGROUND STRUCTURES AS SHOWN ARE BASED ON THE BEST INFORMATION AVAILABLE. BUT NO GUARANTEE IS GIVEN THAT ALL EXISTING UTILITIES ARE SHOWN OR THAT THE GIVEN LOCATIONS ARE EXACT. CONFIRMATION OF EXISTENCE AND EXACT LOCATION OF ALL SERVICES MUST BE OBTAINED FROM THE INDIVIDUAL UTILITIES BEFORE PROCEEDING WITH CONSTRUCTION.	

B.M. Zone: 41, # 15 - N. side Sansome Ave. E. of Bedson Str., Tolt. in S. Concr. Foundation of Sansome Junior High School, 1.5m E. & ELEV. 0.1m below brick of S.W. Corn. of most Sty. Conc. Foundation of school.					
ELEVATION: 237.802					
1 ISSUED FOR ADDENDUM 2	04/03/2025	BC			
0 ISSUED FOR TENDER	03/20/2025	BC			
A ISSUED FOR REVIEW	01/31/2025	BC			
NO. REVISIONS	DATE	BY			

AECOM	
DESIGNED BY	BC
CHECKED BY	RC
DRAWN BY	RAM
APPROVED BY	RC
HOR. SCALE:	1:250
VERTICAL:	1:10
RELEASED FOR CONSTRUCTION BY:	
DATE	01/31/2025
DATE	

ENGINEER'S SEAL	THE CITY OF WINNIPEG PUBLIC WORKS DEPARTMENT ENGINEERING DIVISION	
CONSULTANT DRAWING NO. CT-08	2025 LOCAL STREET RENEWAL PROGRAM	CITY DRAWING NUMBER SHEET 08 OF 33
	POOLE CRESCENT - END TO SHELLEY STREET PAVEMENT RECONSTRUCTION END TO SHELLEY STREET	