
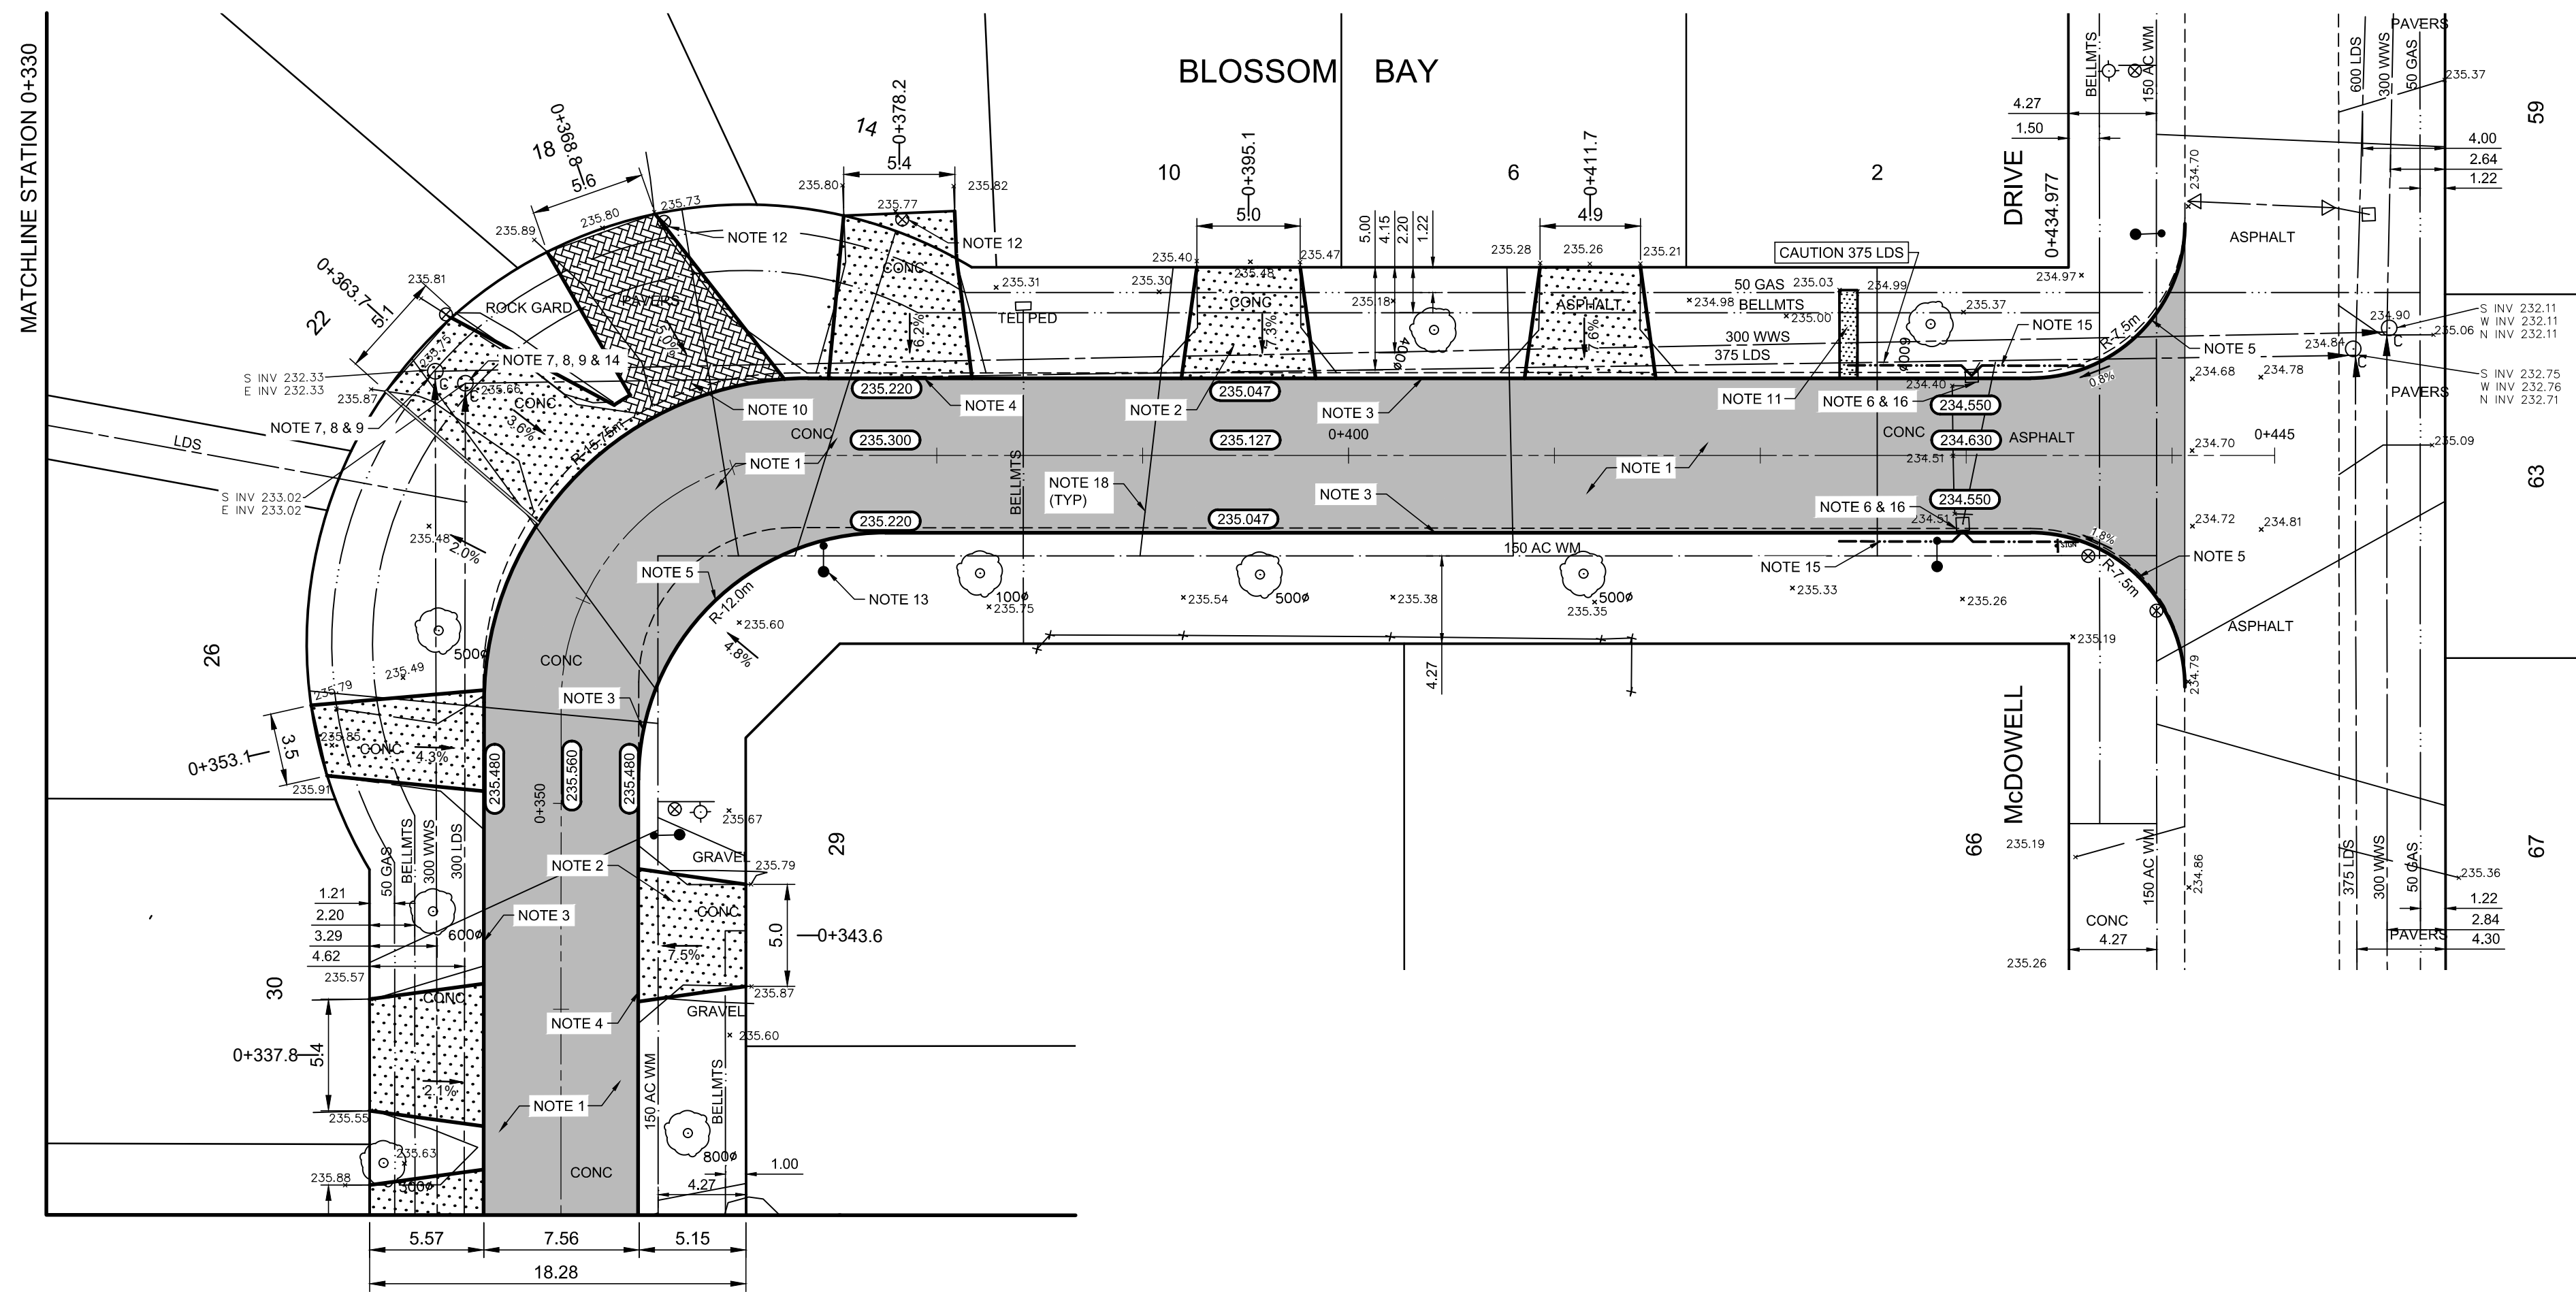
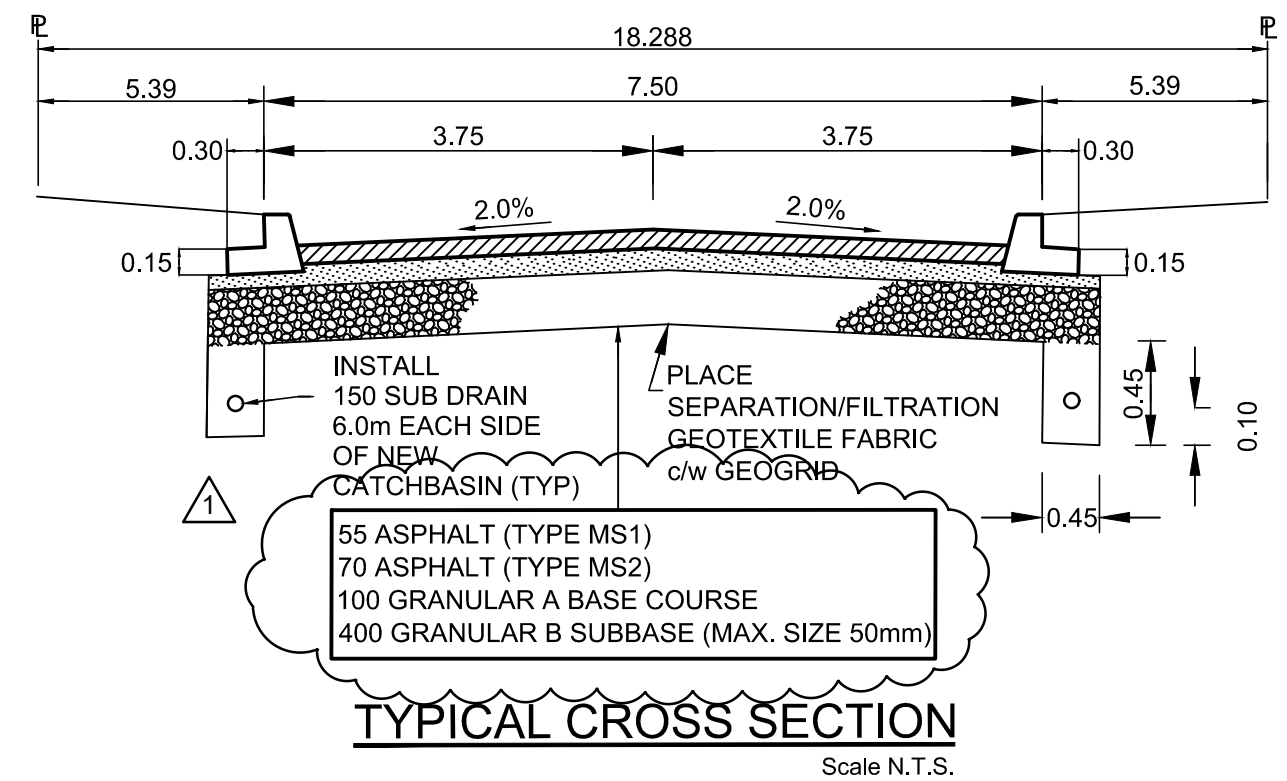


REFERENCE NOTES:

- A. PAVEMENT DIMENSIONS ARE TO BACK OF CURB
- B. PROPERTY LINES OBTAINED FROM CITY OF WINNIPEG L.B.I.S., AND NO SCALE FACTOR WAS APPLIED
- C. REFER TO AECOM FIELD BOOK NO. 5185

CONSTRUCTION NOTES:

1. REMOVE EXISTING PAVEMENT AND PLACE NEW ASPHALT PAVEMENT OVERLAY (65mm TYPE MS1 & 70m TYPE MS2)
2. REMOVE EXISTING PAVEMENT AND CONSTRUCT NEW 150mm REINFORCED CONCRETE PAVEMENT
3. CONSTRUCT NEW CONCRETE BARRIER CURB AND REVERSED GUTTER FOR ASPHALT PAVEMENT (180mm HT.)
4. CONSTRUCT NEW CONCRETE BARRIER CURB AND REVERSED GUTTER FOR ASPHALT PAVEMENT (180mm HT.)
5. CONSTRUCT NEW CONCRETE MODIFIED BARRIER CURB AND REVERSED GUTTER FOR ASPHALT PAVEMENT (180mm HT.)
6. REMOVE EXISTING MOUNTABLE CURB FRAME AND COVER AND PLACE NEW BARRIER CURB FRAME AND COVER INLET
7. ADJUST MANHOLE / CATCH BASIN / CATCH PIT TO GRADE
8. INSTALL NEW CAST IRON RISER RING
9. REMOVE EXISTING FRAME AND COVER AND PLACE NEW STANDARD FRAME AND SOLID COVER
10. ADJUST EXISTING PAVING STONES / PATIO BLOCKS TO GRADE
11. RENEW EXISTING PRIVATE 100mm CONCRETE SIDEWALK
12. ADJUST EXISTING WATER VALVE TO GRADE
13. REMOVE EXISTING STREET LIGHT POLES
14. S-MH60001784 - REPLACE RISER DOWN TO 0.7m
15. INSTALL NEW 150mm SUB DRAIN 6.0m ON EACH SIDE OF EXISTING CATCH BASIN
16. INSTALL 2.7m X 1.5m SECTION OF PAVEMENT REPAIR FABRIC AT EXISTING CATCH BASIN
17. ADJUST EXISTING WATER SERVICE SHUT OFF VALVE
18. INSULATE EXISTING WATER SERVICE UNDER ROADWAY (2.7m IN WIDTH)

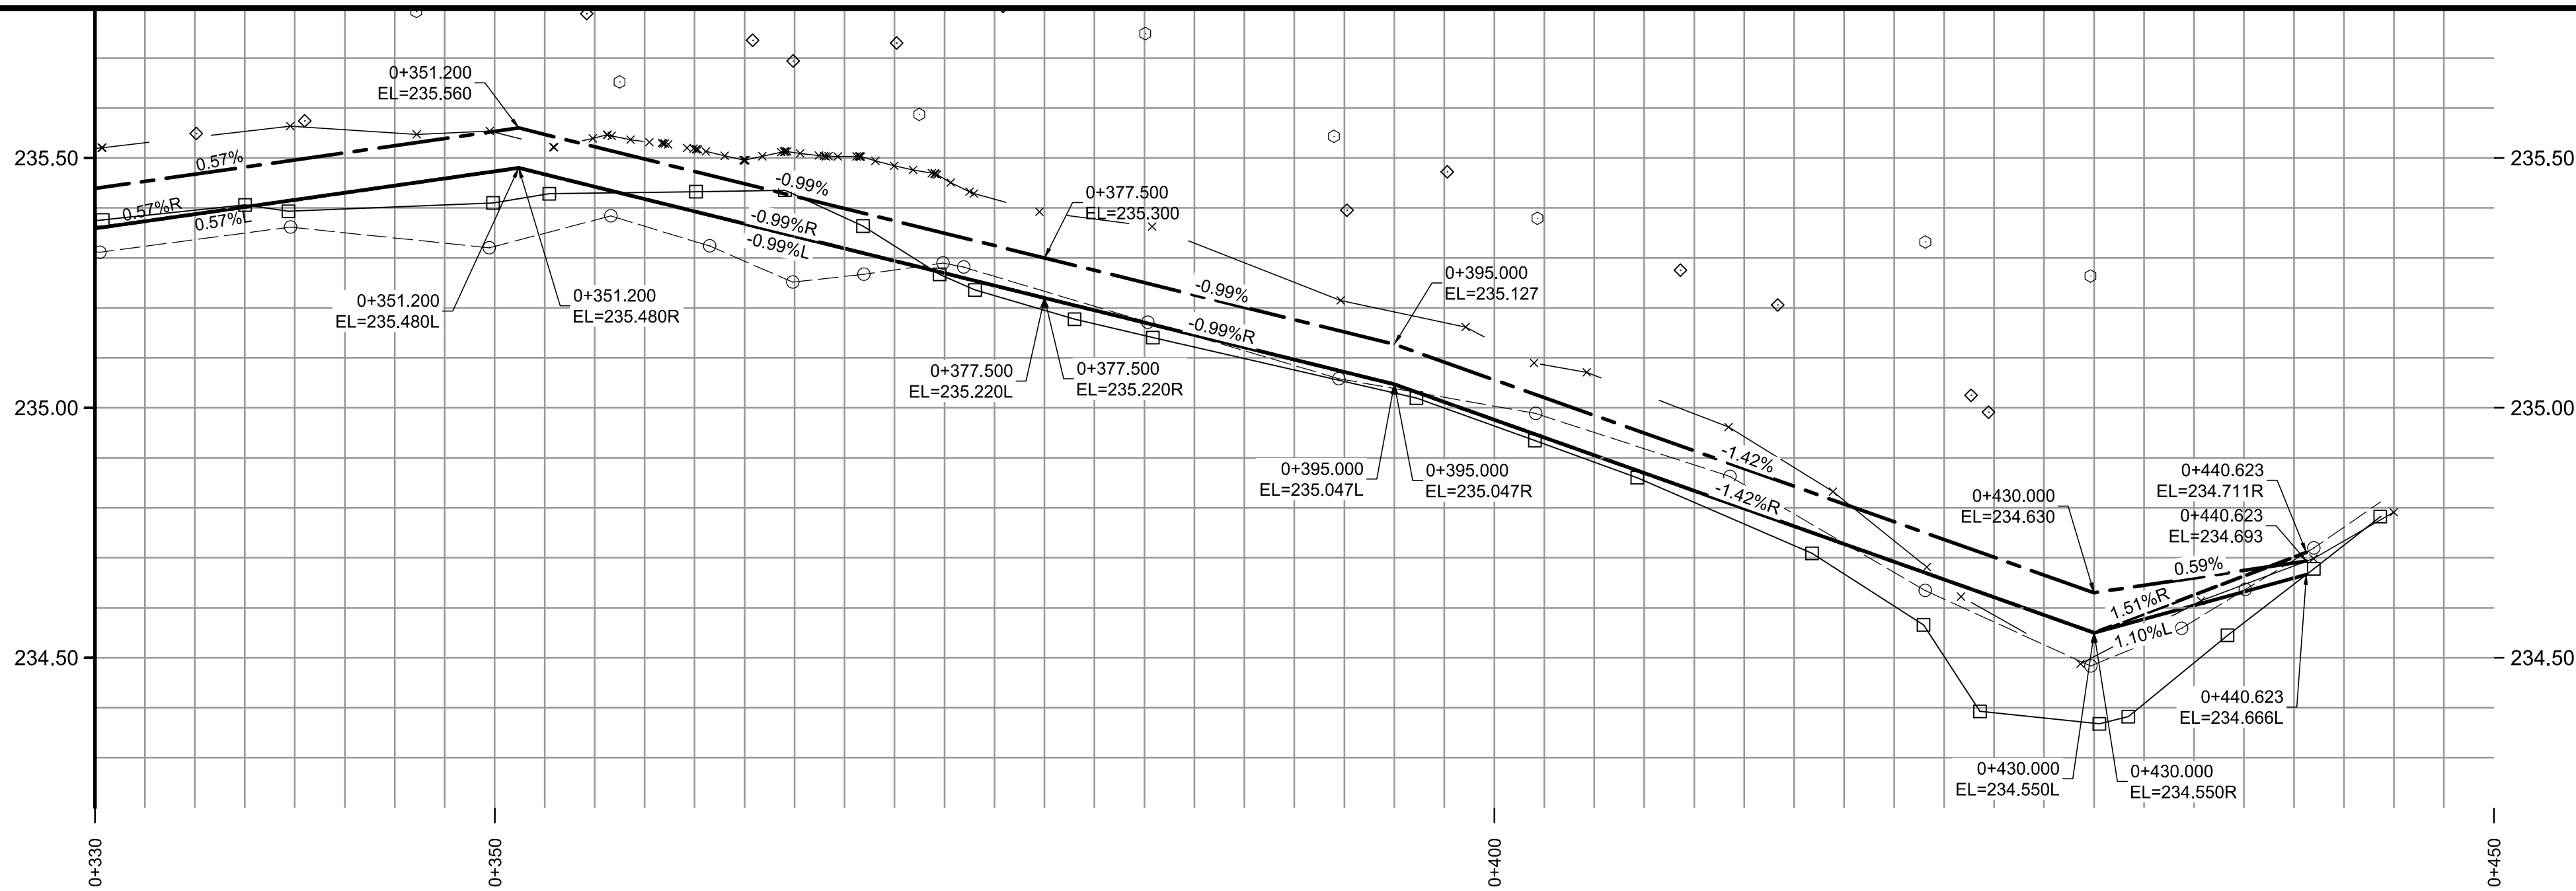

Certificate of Authorization

AECOM Canada ULC

No. 4671 Date: 04/03/2025

METRIC

WHOLE NUMBERS INDICATE MILLIMETRES
DECIMALIZED NUMBERS INDICATE METRES

150 mm W.M.	WATERMAIN	150 mm W.M.	HYDRO	HYDRO	PROFILE	PROFILE
◇	HYDRANT	◇	M.T.S.	— — — — —	— — — — —	— — — — —
⊙	VALVE	⊙	CONCRETE	— — — — —	— — — — —	— — — — —
300mm L.D.S.	LAND DRAINAGE SEWER	300mm L.D.S.	ASPHALT	— — — — —	— — — — —	— — — — —
250mm W.W.S.	WASTEWATER SEWER	250mm W.W.S.	PROPERTY LINE	— — — — —	— — — — —	— — — — —
○	MANHOLE	○	SURVEY BAR	— — — — —	— — — — —	— — — — —
□	CATCH BASIN	□	ELEVATION	— — — — —	— — — — —	— — — — —
▽	CATCH PIT	▽	TREE	— — — — —	— — — — —	— — — — —
↑	TRAFFIC SIGNAL POLE	↑	SIDEWALK RAMP	— — — — —	— — — — —	— — — — —
↑	STREET LIGHT	↑	CONCRETE SIDEWALK	— — — — —	— — — — —	— — — — —
↑	GAS	↑	FENCE	— — — — —	— — — — —	— — — — —
EXISTING	LEGEND - PLAN	PROPOSED	EXISTING	LEGEND - PLAN	PROPOSED	EXISTING

LOCATION APPROVED UNDERGROUND STRUCTURES

SUPV. U/G STRUCTURES COMMITTEE DATE

NOTE:
LOCATION OF UNDERGROUND STRUCTURES AS SHOWN ARE BASED ON THE BEST INFORMATION AVAILABLE, BUT NO GUARANTEE IS GIVEN THAT ALL EXISTING UTILITIES ARE SHOWN OR THAT THE GIVEN LOCATIONS ARE EXACT. CONFIRMATION OF EXISTENCE AND EXACT LOCATION OF ALL SERVICES MUST BE OBTAINED FROM THE INDIVIDUAL UTILITIES BEFORE PROCEEDING WITH CONSTRUCTION.

B.M. Zone 49, # 18 - E. side Haney Str., N. of Ridgewood Ave., Tbt. in N. Concr. Foundation No. 863 Haney Str., 1.0m E. of N.W. Corn. of house & 0.3m below stucco.

ELEVATION: 235.910

NO.	REVISIONS	DATE	BY
1	ISSUED FOR ADDENDUM 2	04/03/2025	BC
0	ISSUED FOR TENDER	03/20/2025	BC
A	ISSUED FOR REVIEW	01/31/2025	BC

AECOM

DESIGNED BY	BC	CHECKED BY	RC
DRAWN BY	RAM	APPROVED BY	RC
HOR. SCALE:	1:250	RELEASED FOR CONSTRUCTION BY:	
VERTICAL:	1:10		
DATE	01/31/2025	DATE	

ENGINEER'S SEAL

CONSULTANT DRAWING NO. CT-16



PUBLIC WORKS DEPARTMENT
ENGINEERING DIVISION

2025 LOCAL STREET
RENEWAL PROGRAM

BLOSSOM BAY - McDOWELL DRIVE TO McDOWELL DRIVE
PAVEMENT RECONSTRUCTION

STATION 0+330 TO McDOWELL DRIVE

CITY DRAWING NUMBER

SHEET 16 OF 33