
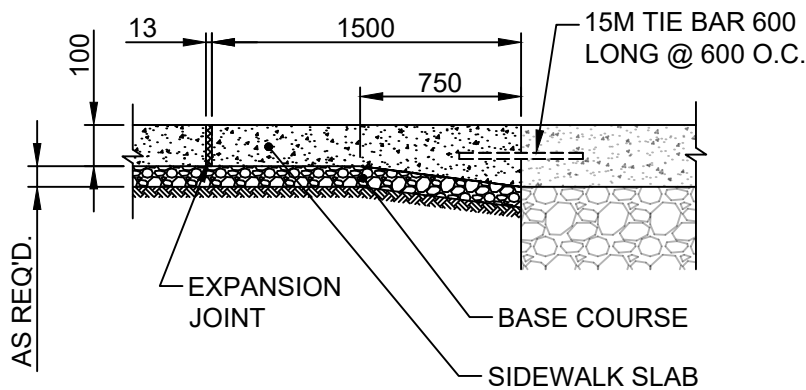
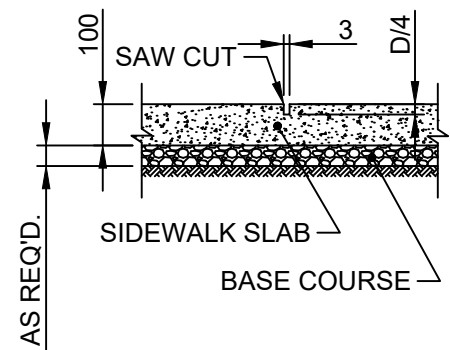
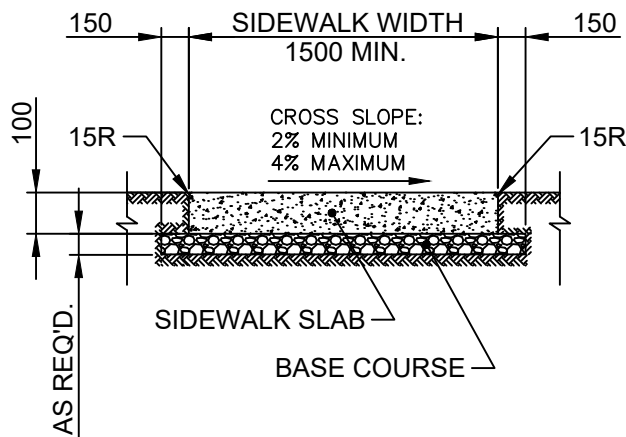


# **APPENDIX 'J'**

## **APPLICABLE STANDARD DETAILS**

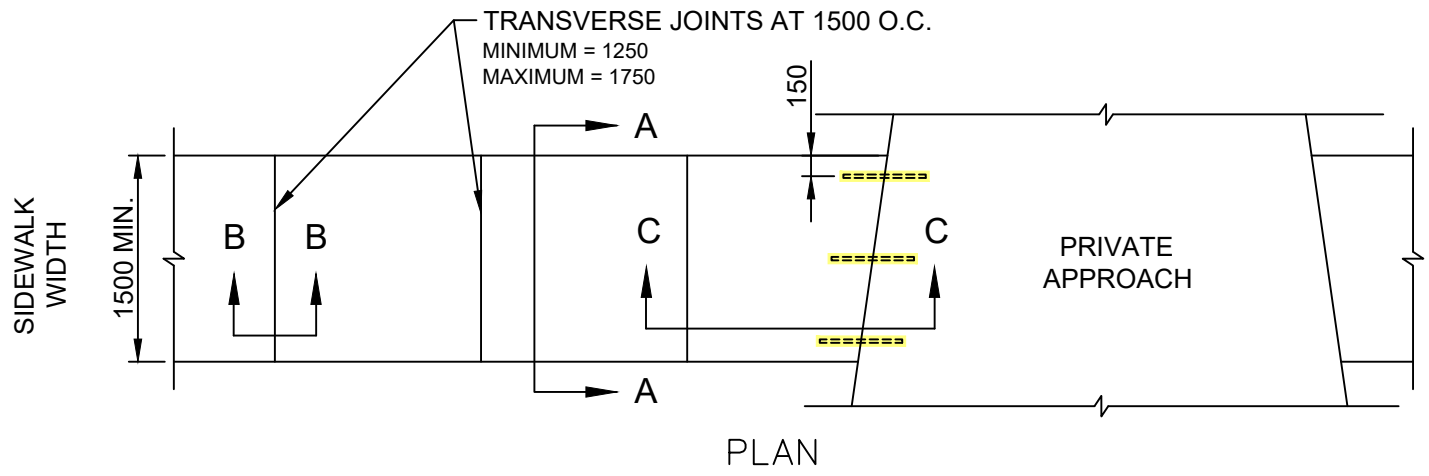

#### NOTE:

1. SIDEWALK SLAB SURFACE WILL BE GIVEN A TEXTURED BROOM FINISH. NO EDGER MARKS WILL BE LEFT
2. LONGITUDINAL JOINTS AT 1500 O.C. MAXIMUM
3. FOR PRIVATE APPROACHES WITH CURBS, CURB RAMPS SHALL BE INSTALLED

DIMENSIONS IN MILLIMETRES




## THE CITY OF WINNIPEG

### PUBLIC WORKS DEPARTMENT

Reference Spec. No.  
CW 3235, CW 3310, CW 3325

## CONCRETE SIDEWALK

Revisions			
1.	OCT 24	ADDED TIE BARS	R.B.
No.	Date	Description	By
Designed By:		Drawn By:	Scale :
A.G.		R.B.	N.T.S.
Checked By:		Date:	Drawing No.
B.K.		2024-10-01	
Approved:			SD-228A
PAVEMENT MANAGEMENT BRANCH			

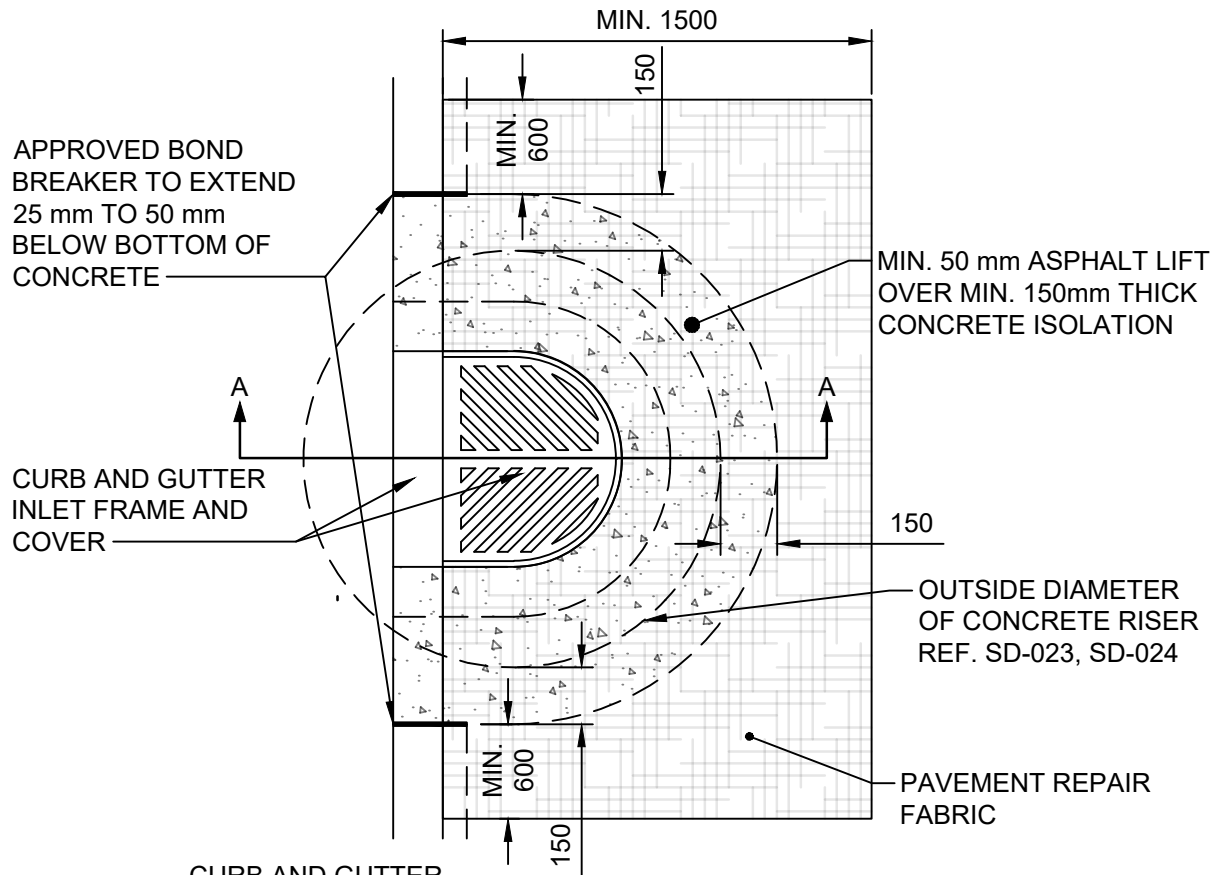

CURB AND GUTTER INLET FRAME AND COVER

CONCRETE RISER OR ONE LAYER OF BRICKS

PAVEMENT REPAIR FABRIC

ASPHALT PAVEMENT

150  
BASE COURSE

REDUCER

CATCH BASIN OR CATCH PIT

MIN. 40  
MIN. 150

**NOTE:**

CURB FOR ASPHALT PAVEMENTS SHALL BE CONSTRUCTED CONTINUOUSLY THROUGH ISOLATION. SAW CUT AND REMOVE CURB FOR ISOLATION.

**SECTION A-A**

DIMENSIONS IN MILLIMETRES



**THE CITY OF WINNIPEG**  
PUBLIC WORKS DEPARTMENT

Reference Spec. No.  
CW 3325

**Revisions**

No.	Date	Description	By
1.	FEB 25	ADDED ROUNDED FRAME	T.K.

**CURB AND GUTTER INLET ISOLATION DETAIL FOR ASPHALT PAVEMENTS**

Designed By:  
A.G.

Drawn By:  
R.B.

Scale :  
N.T.S.

Checked By:  
B.K.


Date:  
2024-10-01

Drawing No.  
SD-220D  
DRAFT



Approved:  
PAVEMENT MANAGEMENT BRANCH

NOTE #1:  
SAW CUT AND REMOVE  
BARRIER CURB & PAV'T.

EXTENT OF  
BARRIER CURB

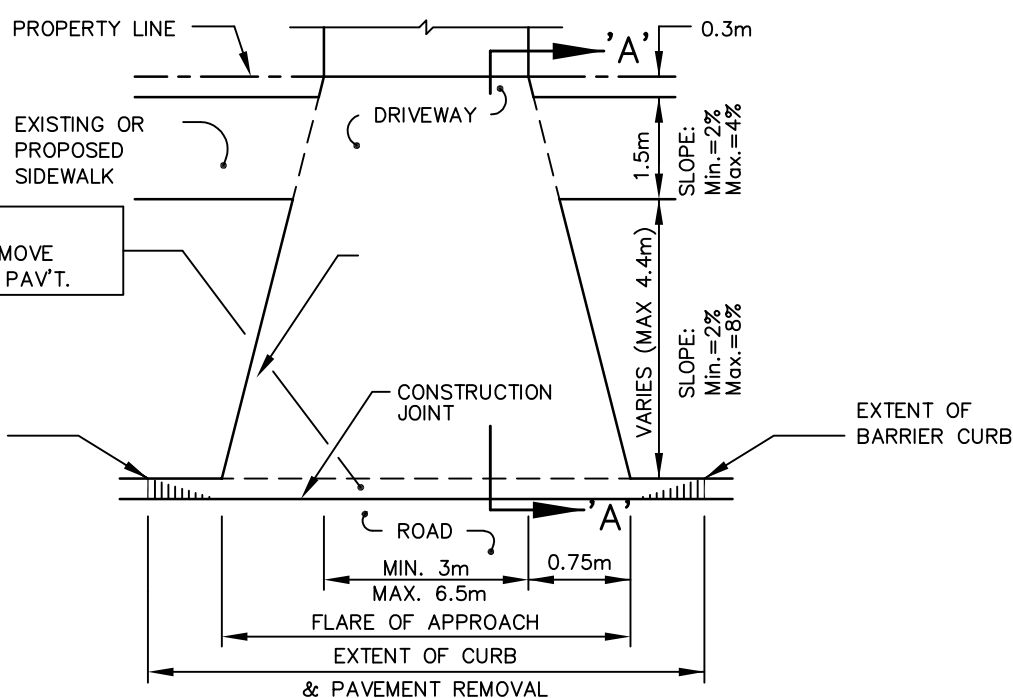


REINFORCING REF.  
SD-237

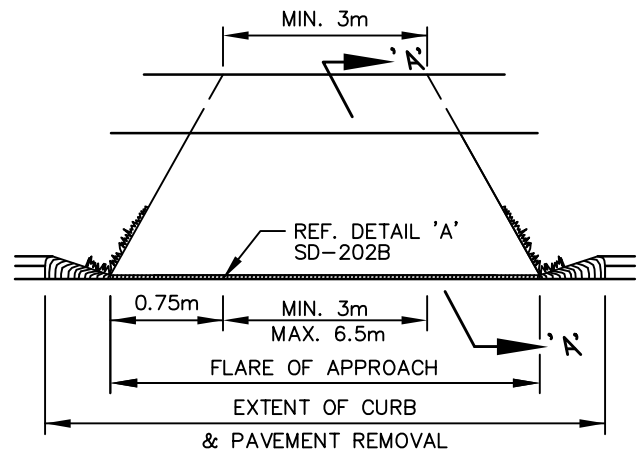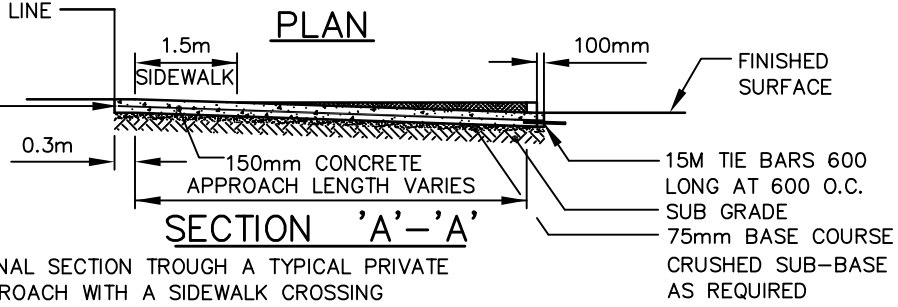


FRONTAL PERSPECTIVE OF  
FINISHED PRIVATE APPROACH

- NOTES:
1. EXISTING SIDEWALK SHALL BE REMOVED, THE APPROACH EXTENDED BACK TO THE PROPERTY LINE AND THE SIDEWALK RESTORED TO THE EDGE OF THE APPROACH AS SHOWN.
  2. M.H. ISOLATIONS TO BE APPROVED BY CONTRACT ADMINISTRATOR.
  3. CONTRACTION JOINT AS REQUIRED TO MATCH STREET TRANSVERSE JOINTS.

DIMENSIONS IN MILLIMETRES

 <b>THE CITY OF WINNIPEG</b> PUBLIC WORKS DEPARTMENT		Revisions			
Reference Spec. No. CW 3230, CW3240, CW 3310		1.	JAN 15	CHANGED FLARE TO 0.75m	T.K.
		No.	Date	Description	By
<b>RESIDENTIAL APPROACH—CONCRETE</b> (WITH EXISTING BARRIER CURB)		Designed By: A.G.		Drawn By: R.B.	Scale : <b>N.T.S.</b>
		Checked By: B.K.		Date: 2024-10-01	Drawing No.
		Approved: PAVEMENT MANAGEMENT BRANCH			<b>SD-235</b>

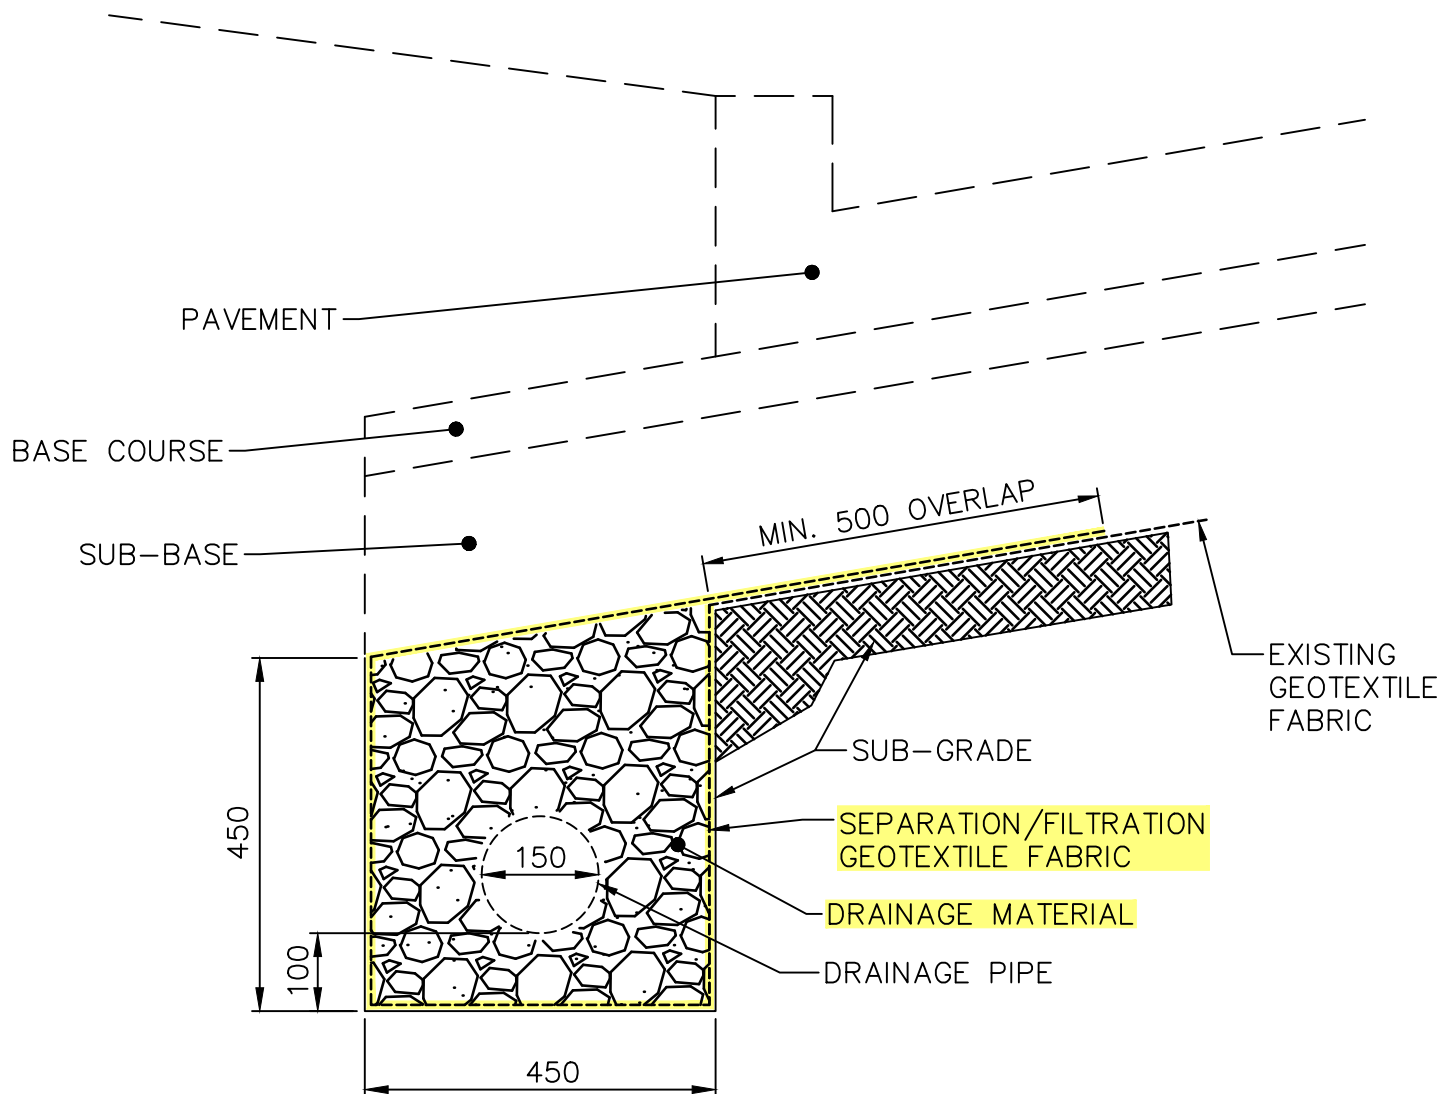

DIMENSIONS IN MILLIMETRES



**THE CITY OF WINNIPEG**  
PUBLIC WORKS DEPARTMENT

Reference Spec. No.  
CW 3110, CW 3120, CW 3130

Revisions

No.	Date	Description	By
1.	OCT 24	GENERAL REVISION	R.B.

SUBDRAIN INSTALLATION  
DETAIL

Designed By:  
A.G.

Drawn By:  
R.B.

Scale :  
N.T.S.

Checked By:  
B.K.

Date:  
2024-10-01

Drawing No.

Approved:  
PAVEMENT MANAGEMENT BRANCH

SD-245