



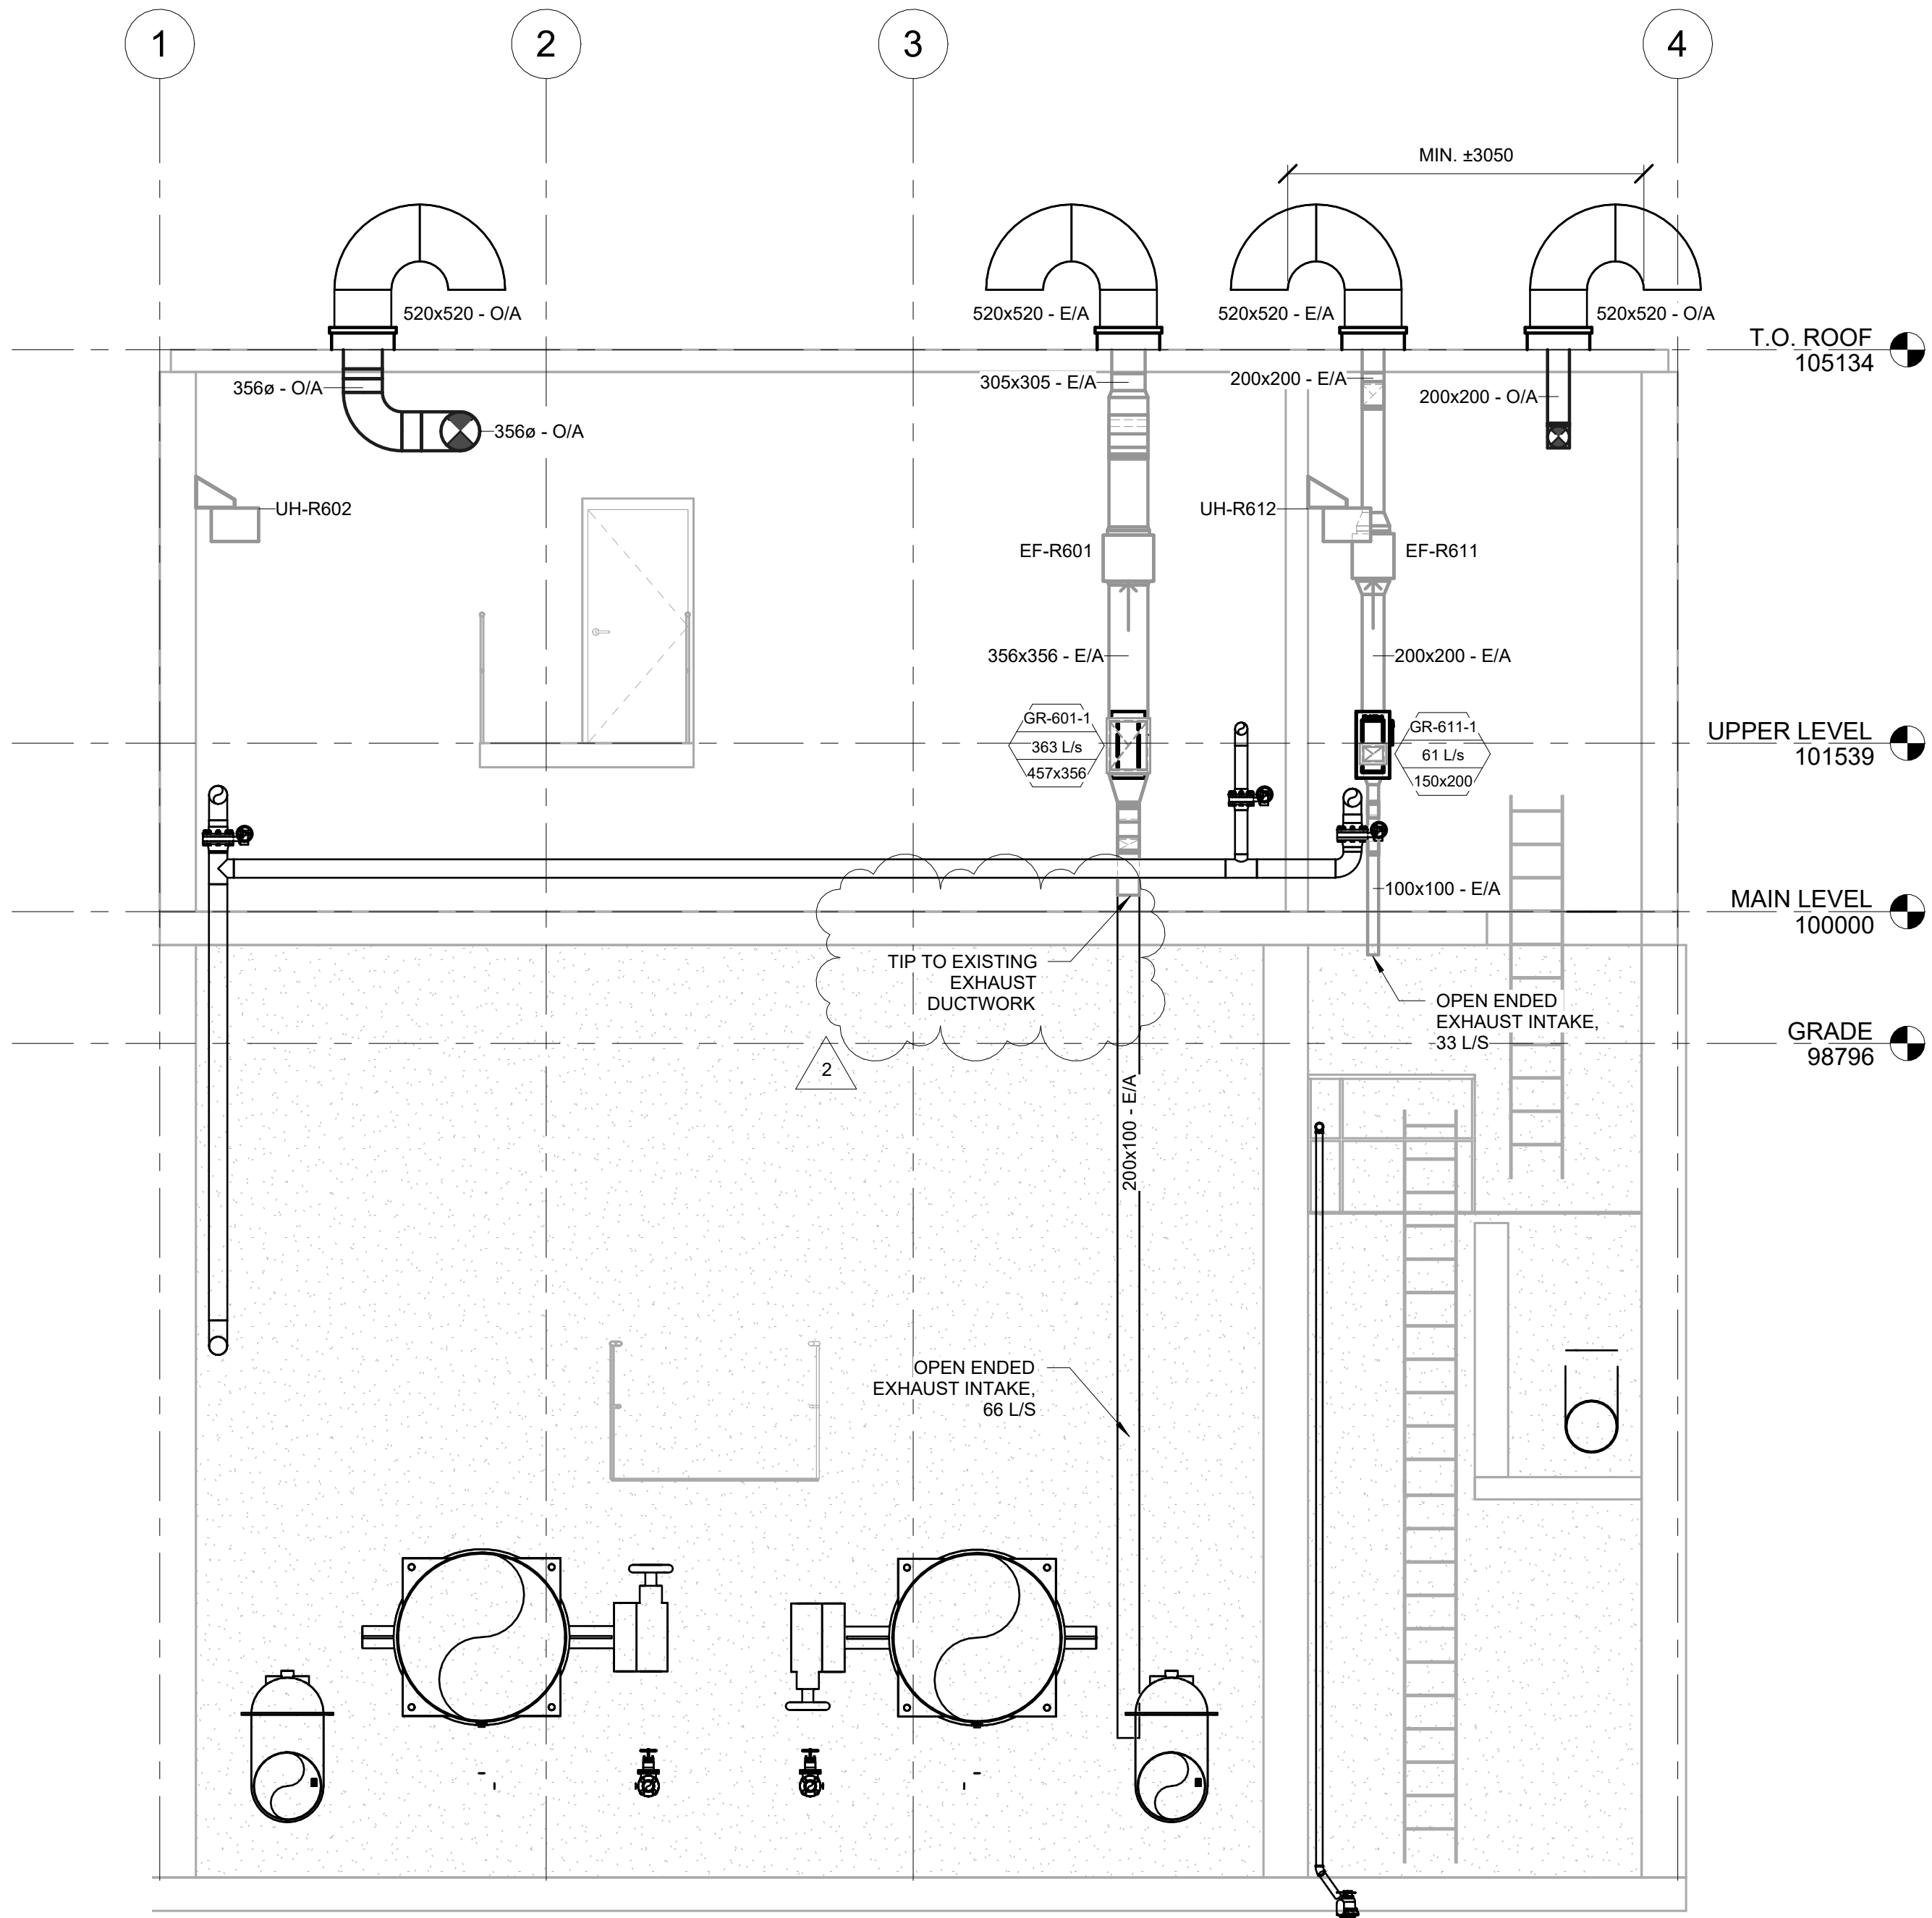

1 NEW CONDITIONS - SECTION 1
SCALE: 1 : 50 594mmx841mm SHEET

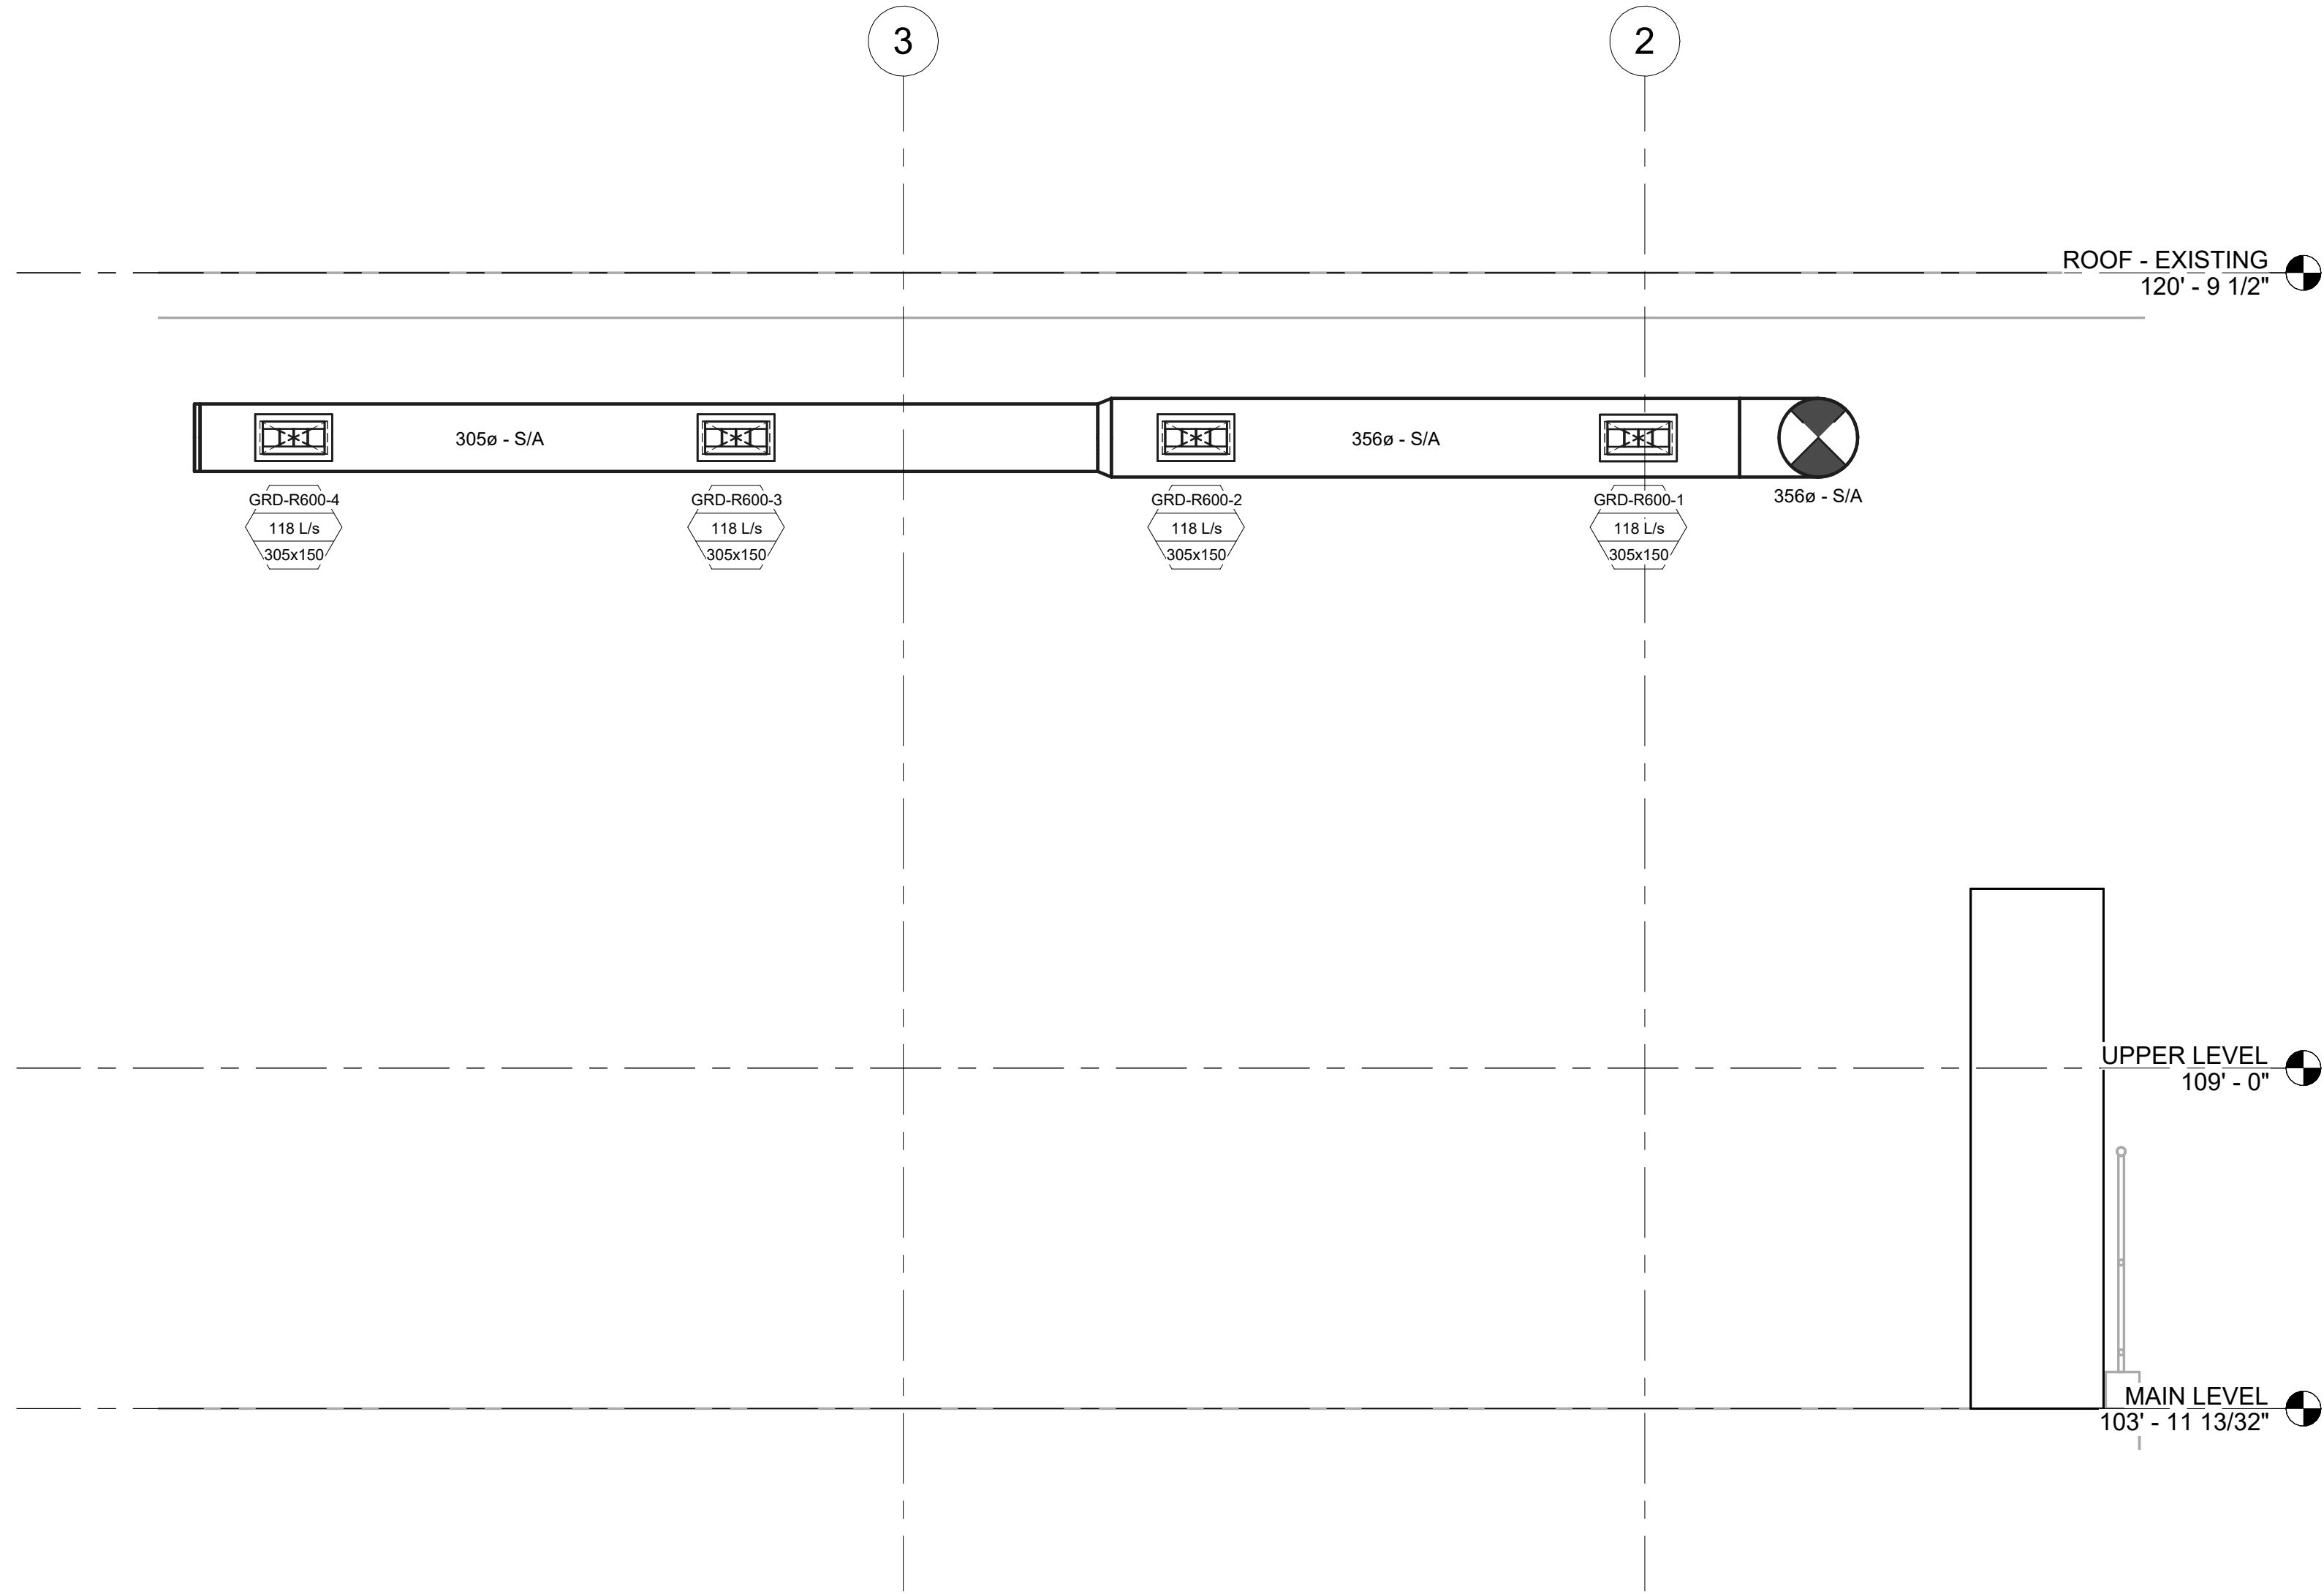

2 NEW CONDITIONS - SECTION 2
SCALE: 1 : 25 594mmx841mm SHEET

Alliance
ENGINEERING SERVICES INC.

DESIGNED BY: A.M.
DRAWN BY: A.M.
SCALE: HORIZONTAL AS NOTED
VERTICAL: AS NOTED

CHECKED BY: B.M.
APPROVED BY: J.C.
RELEASED FOR CONSTRUCTION: 2025/08/27
DATE: YYYY/MM/DD

ENGINEER: B.W.J. McKAY
Member 31262
2025-09-17
REGISTERED PROFESSIONAL ENGINEER

CONSULTANT DRAWING NUMBER: M2.2

THE CITY OF WINNIPEG
WATER AND WASTE DEPARTMENT
ENGINEERING SERVICES DIVISION

MACLEAN RESERVOIR VALVE HOUSE
VENTILATION UPGRADE
SECTIONS - NEW CONDITIONS

NO.	REVISIONS	DATE (YYYY/MM/DD)	BY
2	ISSUED FOR ADDENDUM 1	25-09-17	B.M.
1	RE-ISSUED FOR CONSTRUCTION	25-08-27	B.M.
0	ISSUED FOR CONSTRUCTION	25-07-02	B.M.

ENGINEERS
GEOSCIENTISTS
MANITOBA
Certificate of Authorization
Alliance Engineering Services Inc.
No.2906

CITY FILE NUMBER: W-938
SHEET 1 of 1
CITY DRAWING NUMBER: 1-0630R-M0006-001

BID OPP: 808-2025
CONTRACT NUMBER: #

FILE PATH:
FILE NAME: