



BRIDGE PLAN
1:75

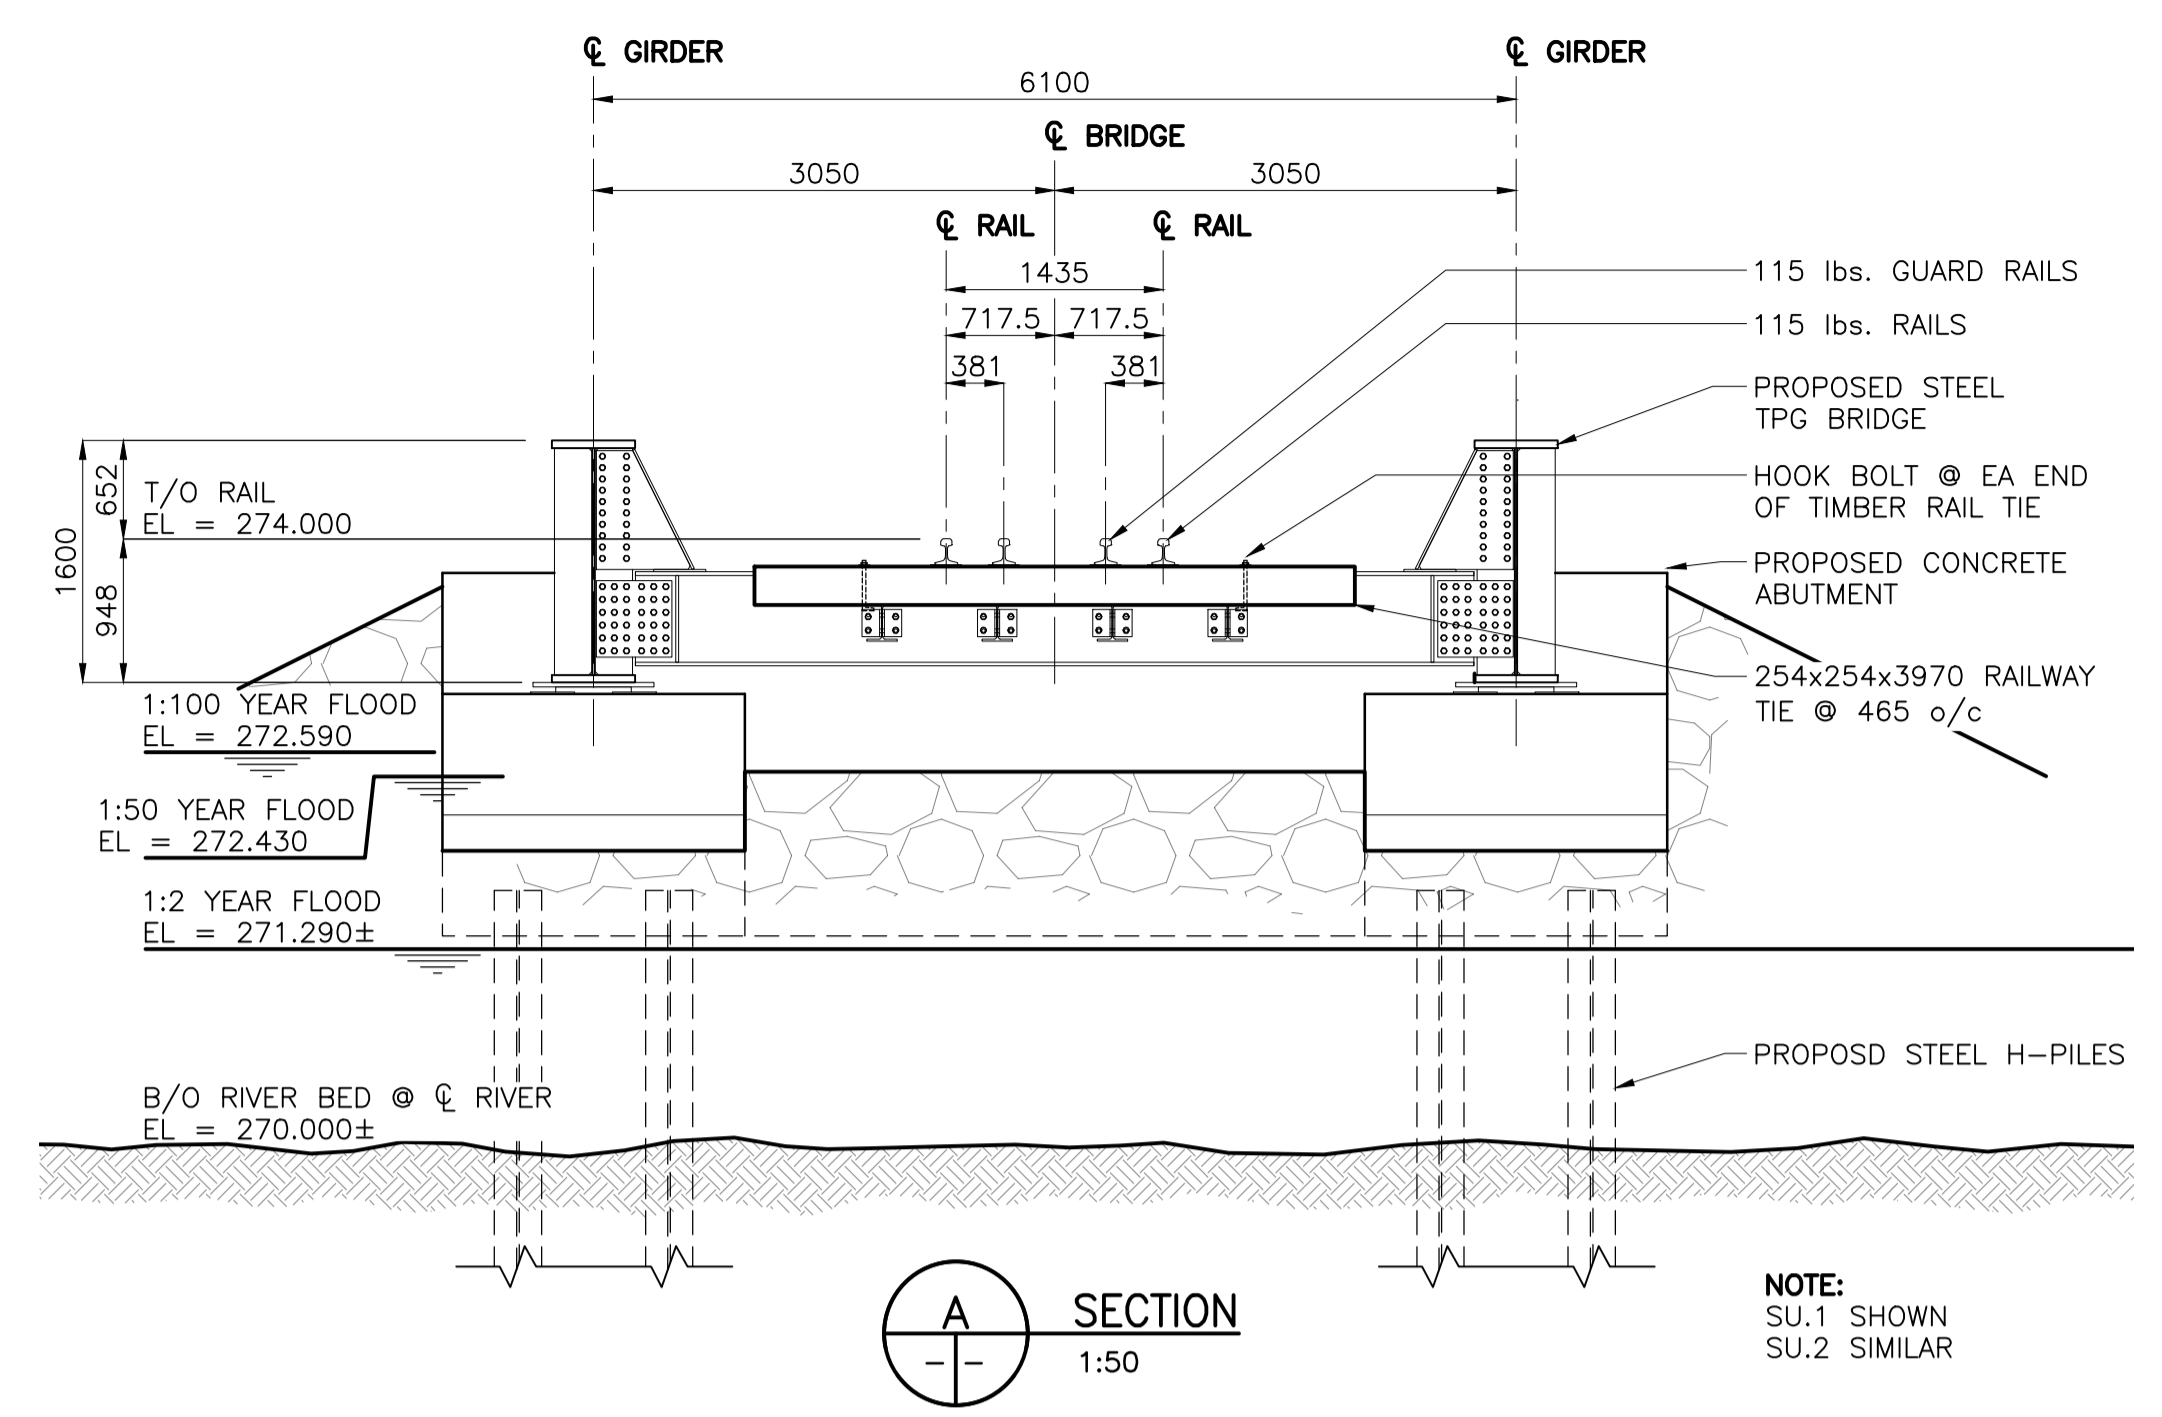


SECTION A
1:50


NOTE:
SU.1 SHOWN
SU.2 SIMILAR

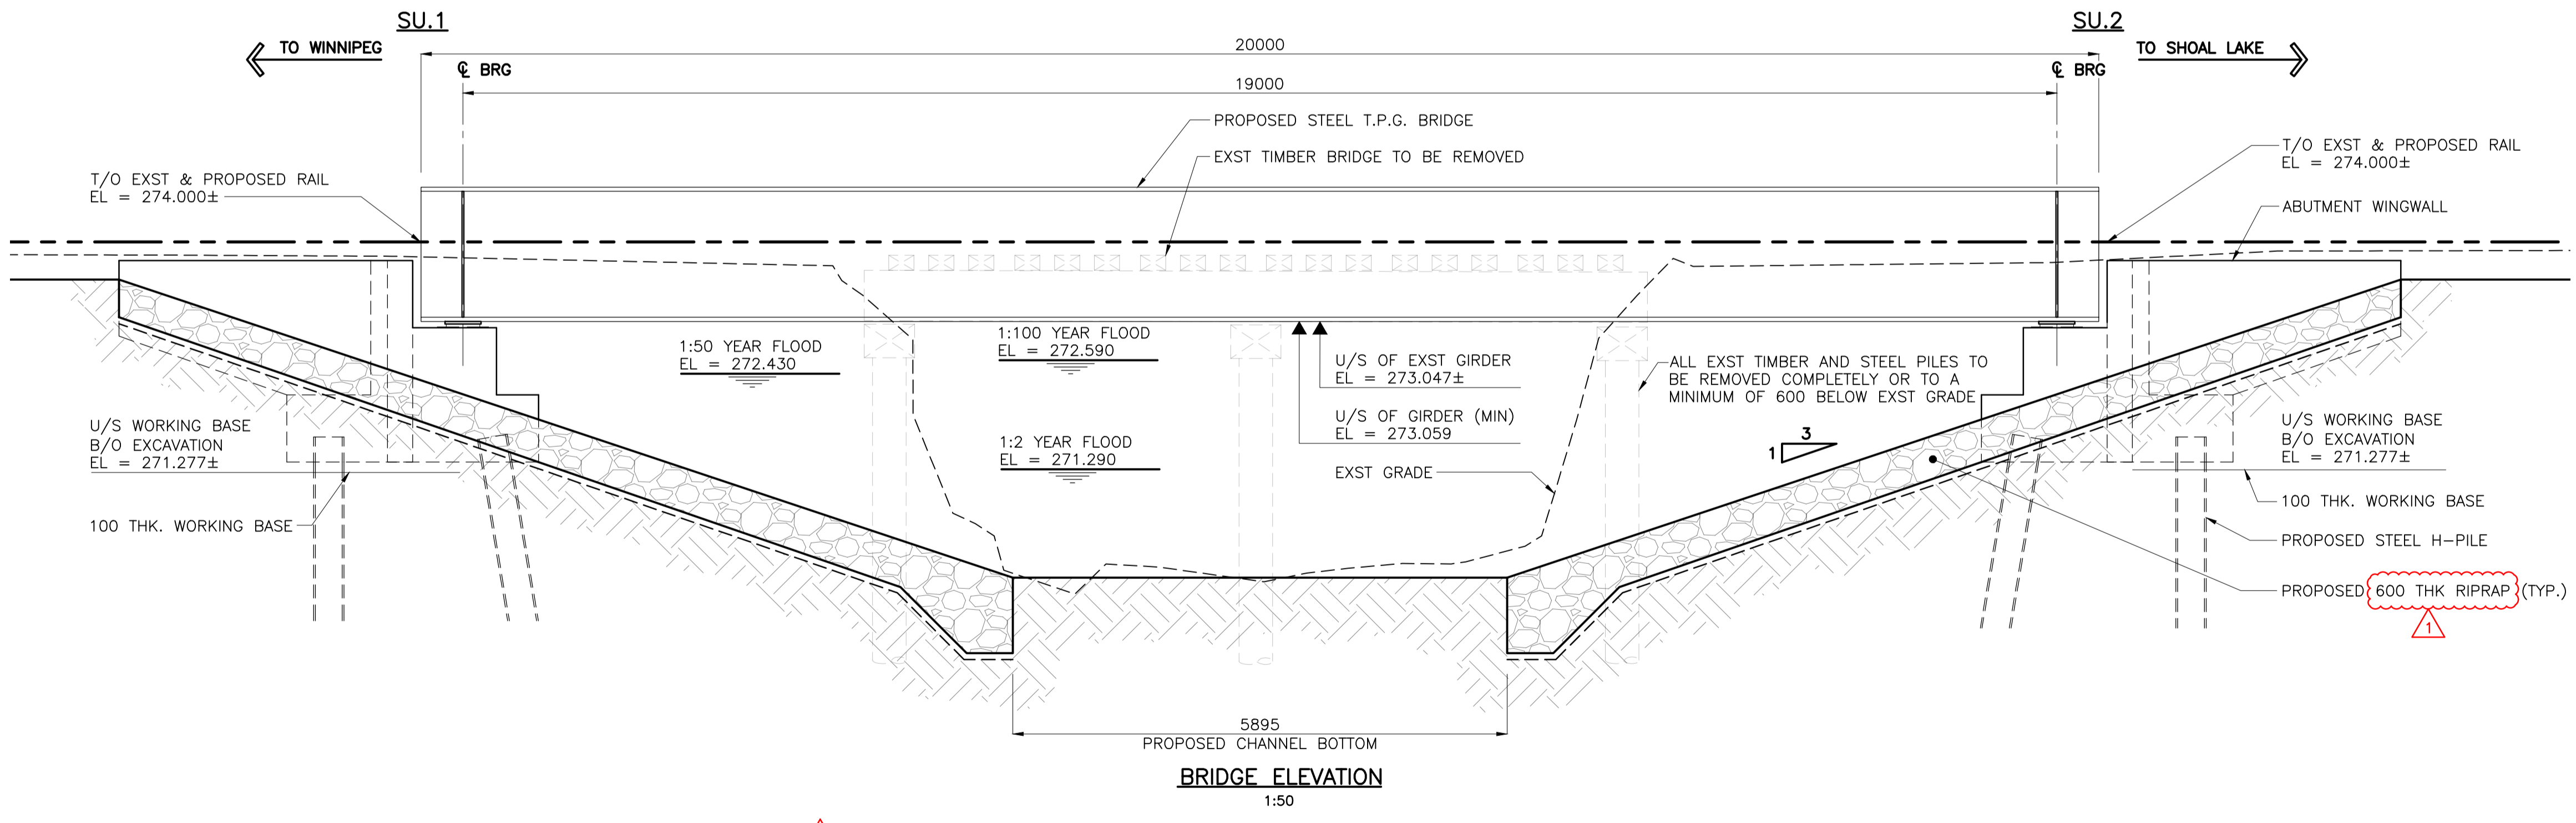

BRIDGE ELEVATION
1:50

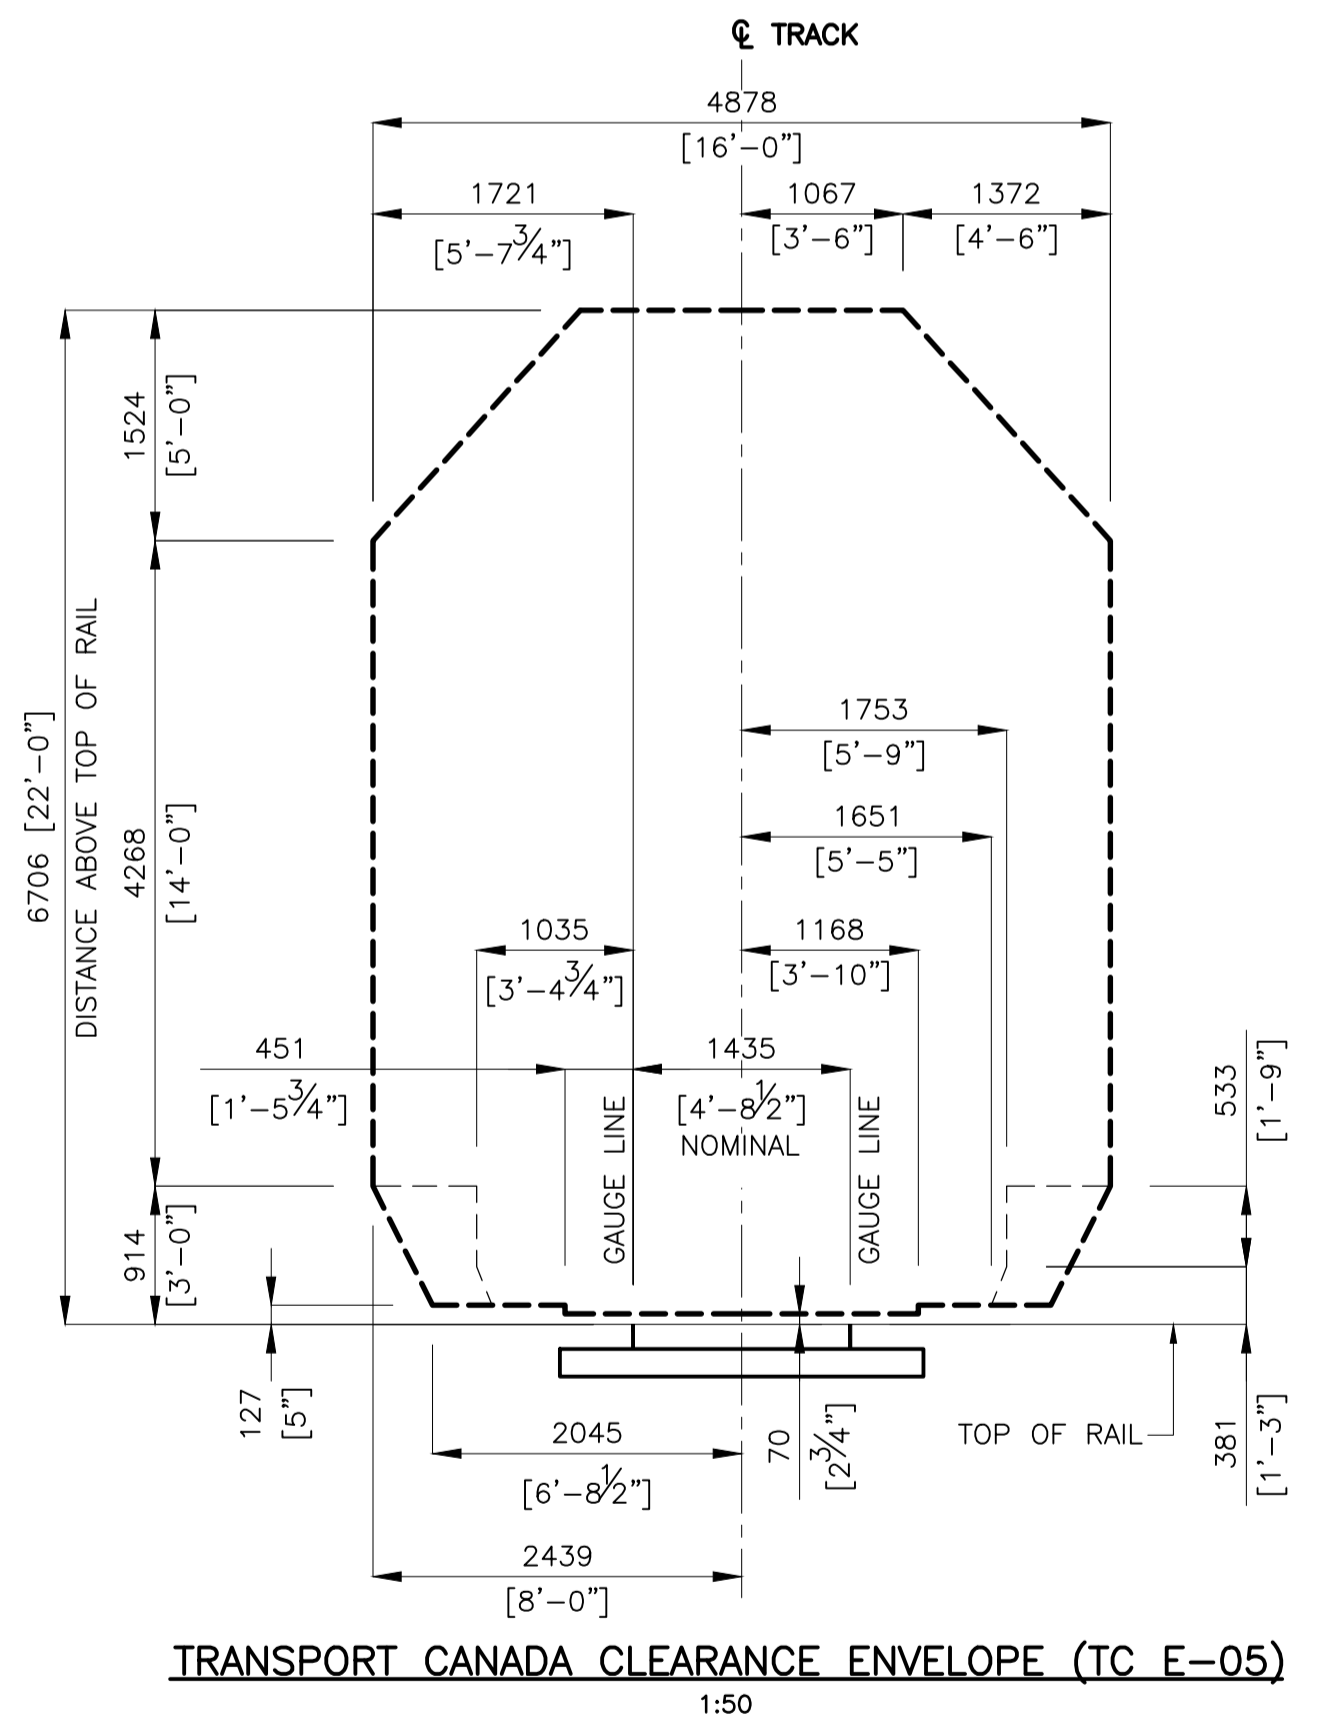

TRANSPORT CANADA CLEARANCE ENVELOPE (TC E-05)
1:50

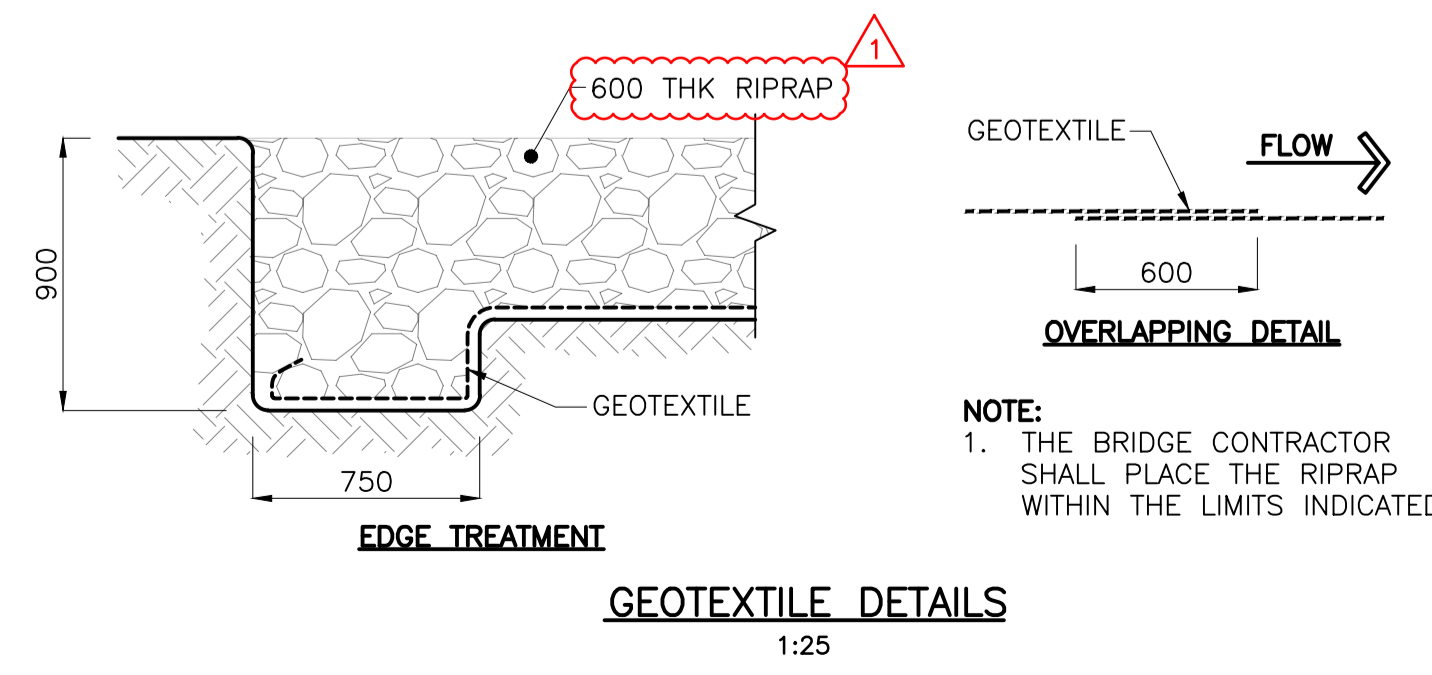

GEOTEXTILE DETAILS
1:25

METRIC
WHOLE NUMBERS INDICATE MILLIMETRES
DECIMALIZED NUMBERS INDICATE METRES

B.M. ELEV.					
DESIGNED BY	S.S.Y.	CHECKED BY	Y.M.S.		
DRAWN BY	J.M.B.	APPROVED BY	E.R.T.		
NO. REVISIONS		DATE	2026-03-23	DATE	

ENGINEER'S SEAL

CONSULTANT DRAWING NO.
S-104

THE CITY OF WINNIPEG
WATER AND WASTE DEPARTMENT
ENGINEERING DIVISION

GREATER WINNIPEG WATER DISTRICT
RAILWAY BRIDGE REPLACEMENT AT MILE 41.3
GENERAL ARRANGEMENT

SHEET 7 OF 17
CAD FILE DRAWING NUMBER
33942s-104-m41.3.dwg
CITY DRAWING NUMBER
1-0754R-S0005-001

U:\11272942\0200_drawing\0202_sheets\Sheet_Rev03_structural\0202s-104-m41.3.dwg
2026/03/23 3:47 PM By: E:\m41.3\jmb