


INCONSISTENCIES:
I-1 P401-SY & P501-SY ARE LABELED AS P401-SI AND P501-SI RESPECTIVELY.

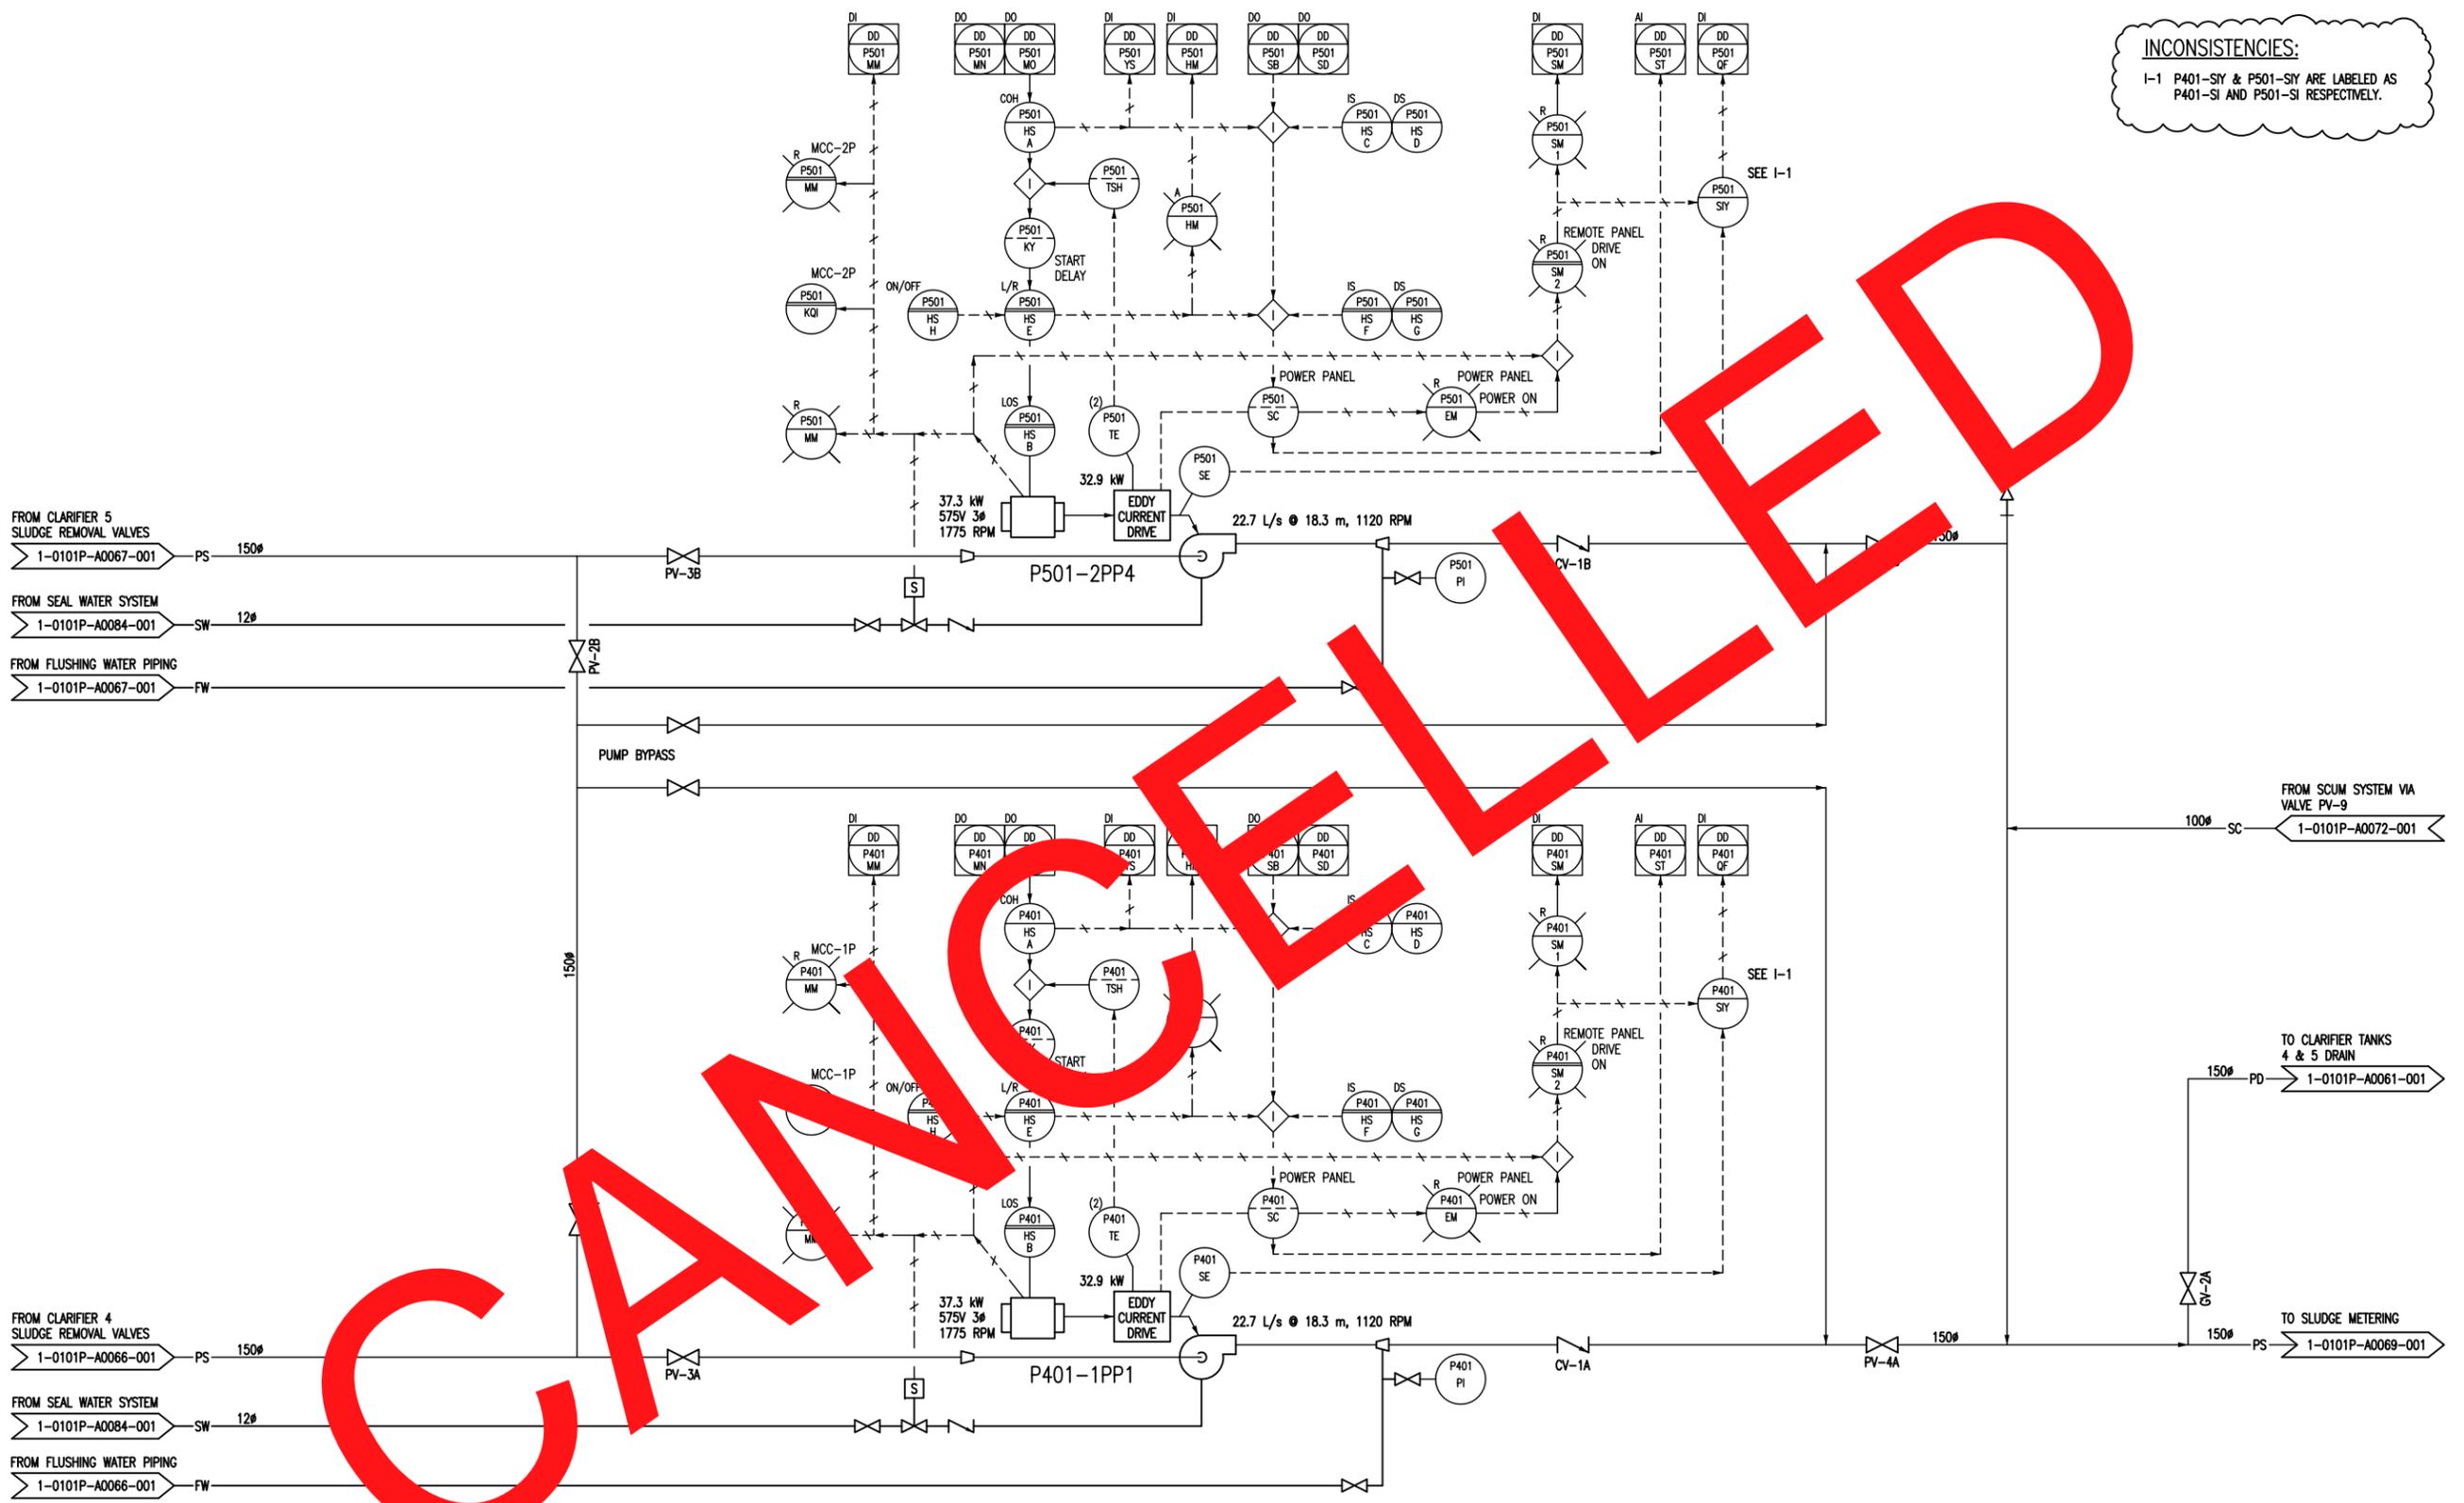

DRAWING CANCELLED

NOTES:
1. ALL INSTRUMENTS SHOWN IN AN AUXILIARY LOCATION ARE IN THE LOCAL CONTROL PANEL CORRESPONDING TO THE PUMP, UNLESS OTHERWISE NOTED.

DRAWING CANCELLED

B.M. ELEV.	FIELD BOOK #:	SNC-LAVALIN Engineers & Constructors		SNC-LAVALIN 200-1600 Main Avenue Winnipeg, Manitoba Canada R3J 3K7	
POSTED TO LBIS		DESIGNED BY	EXISTING	CHECKED BY	CJR
		DRAWN BY	CJR	APPROVED BY	EMR
08	ORIG # WAS 1-0101P-G-A0068-001-02D.dwg	2010/12/08	SPH	RELEASED FOR CONSTRUCTION	
02	RENUMBERED FACILITY CODE	2005/10/06	CJR		
01	ISSUED FOR C.O.W. USE	2005/09/15	CJR		
00	RELEASED FOR REVIEW	2004/10/14	CJR	DATE	2004/07/26
NO. REVISIONS	DATE	BY	FILENAME:	1-0101P-A0068-001.dwg	

ENGINEER'S SEAL

THE CITY OF WINNIPEG
WATER AND WASTE DEPARTMENT

~~WATER POLLUTION CONTROL CENTRE
PRIMARY CLARIFIERS
PROCESS & INSTRUMENTATION DIAGRAM
SLUDGE PUMPS
CLARIFIERS 4 & 5~~

CITY DRAWING NUMBER: 1-0101P-A0068

SHEET: 001

REV: 04


SIZE:

LAST SAVE: 2010/12/09 - 11:11am
PATH: C:\SHORDECK\Corrected Drawings-Vold\AutoCad\CORRECTED\1-0101P-A0068-001.dwg

1-0101A-A0001	PROCESS AND INSTRUMENT DIAGRAMS LEGEND AND DETAILS
DRAWING NUMBER	REFERENCE DRAWINGS

INCONSISTENCIES:
I-1 P401-SY & P501-SY ARE LABELED AS
P401-SI AND P501-SI RESPECTIVELY.

SUPERSEDED

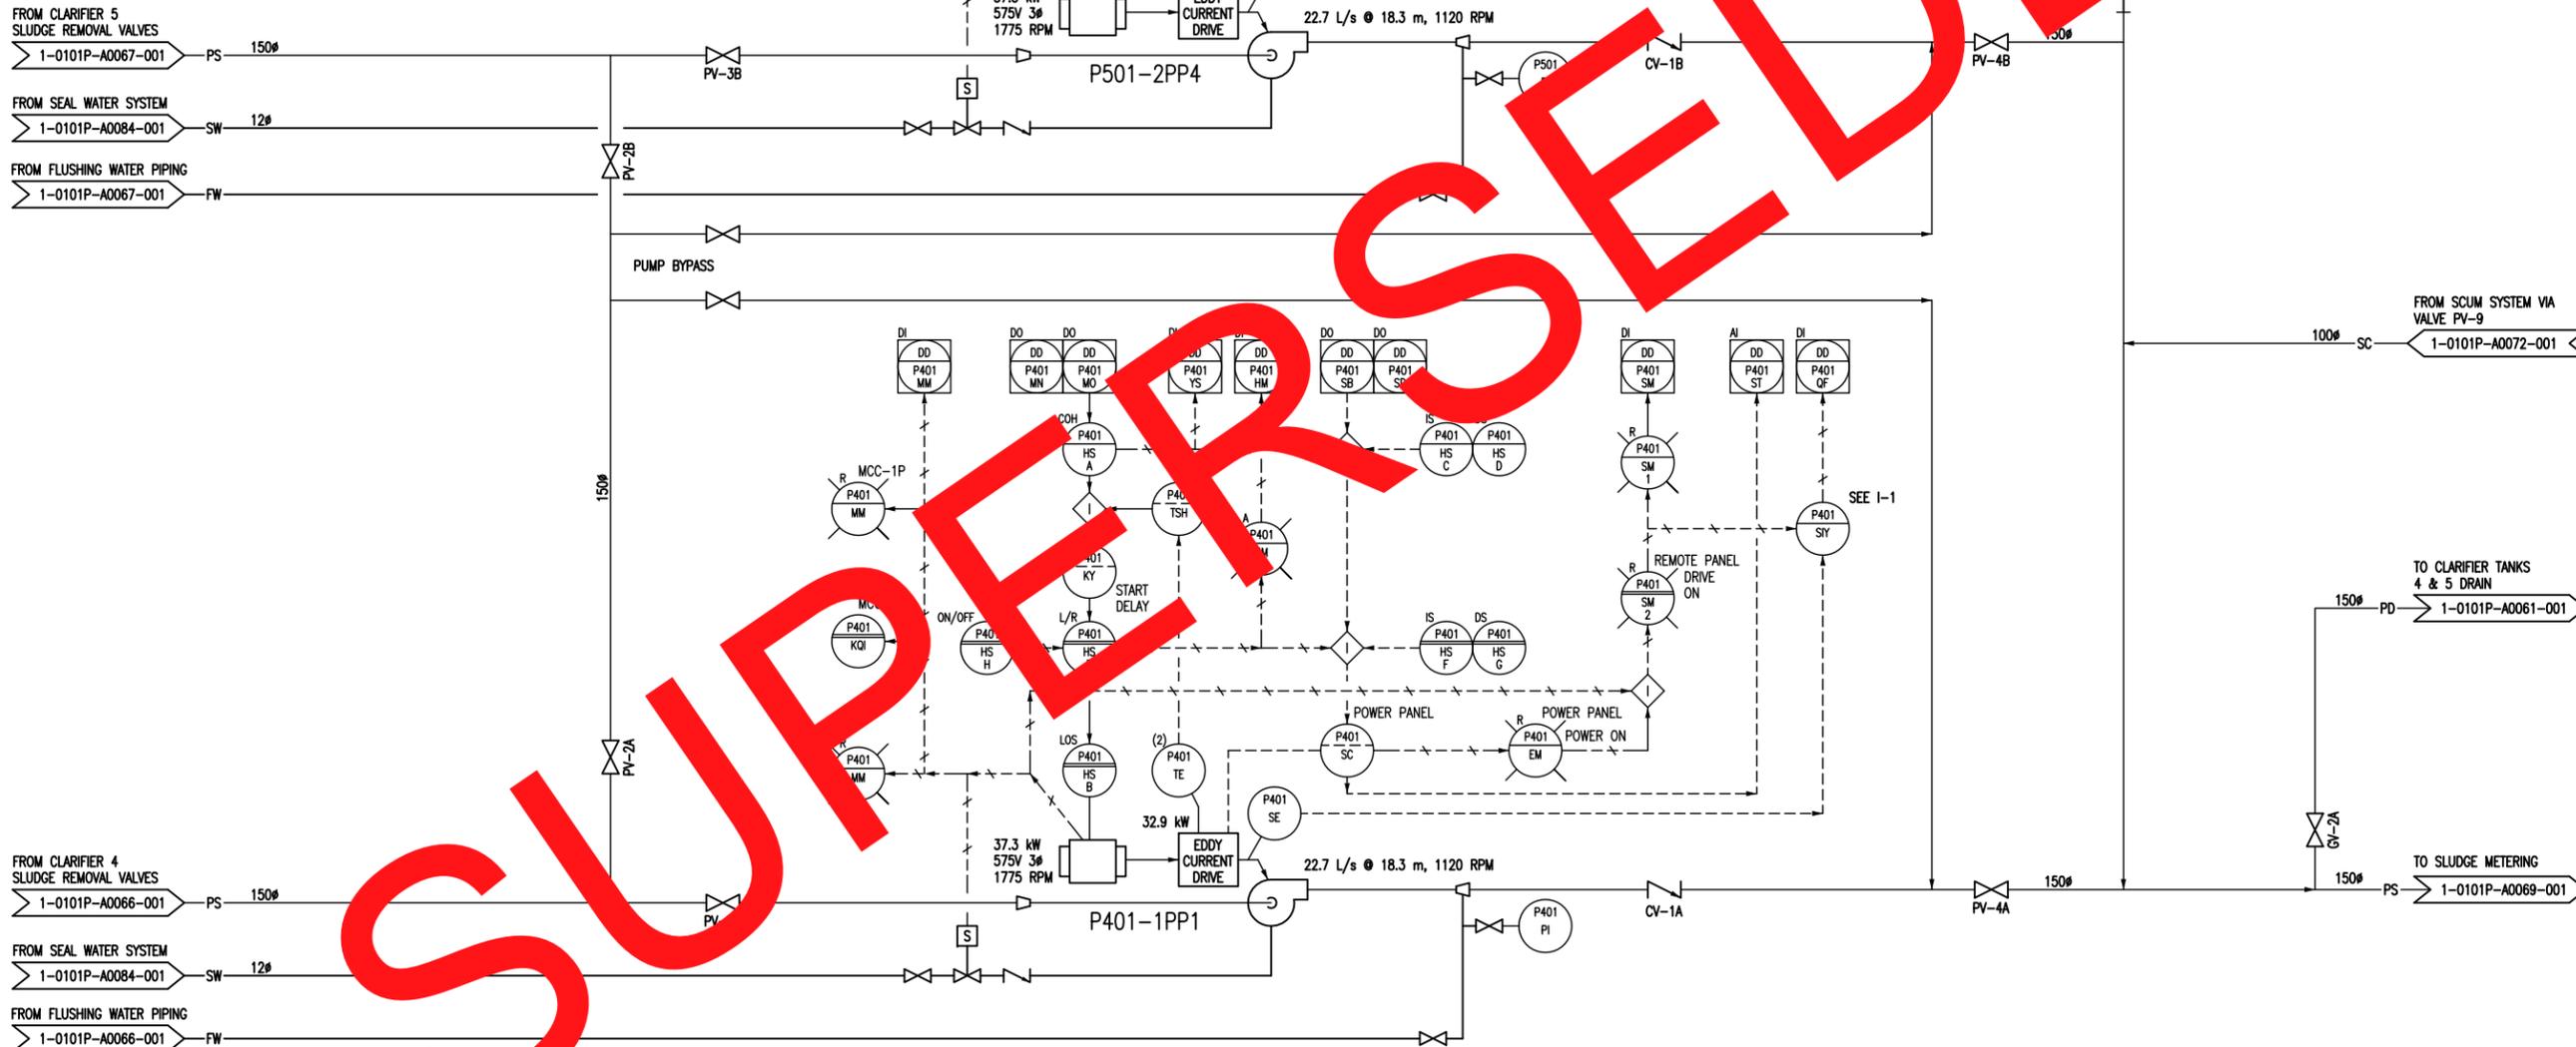

NOTES:
1. ALL INSTRUMENTS SHOWN IN AN AUXILIARY LOCATION ARE IN THE LOCAL CONTROL PANEL CORRESPONDING TO THE PUMP, UNLESS OTHERWISE NOTED.

**KILKENNY LIFT STATION
DEMOLISHED 2032-07-30,
DRAWING SUPERSEDED BY
(NEW CITY DWG #)**

B.M. ELEV.	FIELD BOOK #:	SNC-LAVALIN Engineers & Constructors		SNC-LAVALIN 200-1600 Main Avenue Winnipeg, Manitoba Canada R3J 3B7	
POSTED TO LBS		DESIGNED BY	EXISTING	CHECKED BY	CJR
		DRAWN BY	CJR	APPROVED BY	EMR
08	ORIG # WAS 1-0101P-G-A0068-001-02D.dwg	2010/12/08	SPH	RELEASED FOR CONSTRUCTION	
02	RENUMBERED FACILITY CODE	2005/10/06	CJR		
01	ISSUED FOR C.O.W. USE	2005/09/15	CJR		
00	RELEASED FOR REVIEW	2004/10/14	CJR	DATE	2004/07/26
NO. REVISIONS	DATE	BY	FILENAME	1-0101P-A0068-001.dwg	

ENGINEER'S SEAL

Winnipeg THE CITY OF WINNIPEG
WATER AND WASTE DEPARTMENT

~~WATER END WATER POLLUTION CONTROL CENTRE
PRIMARY CLARIFIERS
PROCESS & INSTRUMENTATION DIAGRAM
SLUDGE PUMPS
CLARIFIERS 4 & 5~~

CITY DRAWING NUMBER: 1-0101P-A0068
SHEET: 001
REV: 04
SIZE:

LAST SAVE: 2010/12/09 - 11:11am
PATH: C:\SHORDECK\Corrected Drawings-Vold\AutoCad\CORRECTED\1-0101P-A0068-001.dwg

1-0101A-A0001	PROCESS AND INSTRUMENT DIAGRAMS LEGEND AND DETAILS
DRAWING NUMBER	REFERENCE DRAWINGS