A1 SIZE – 594mm x 841mm

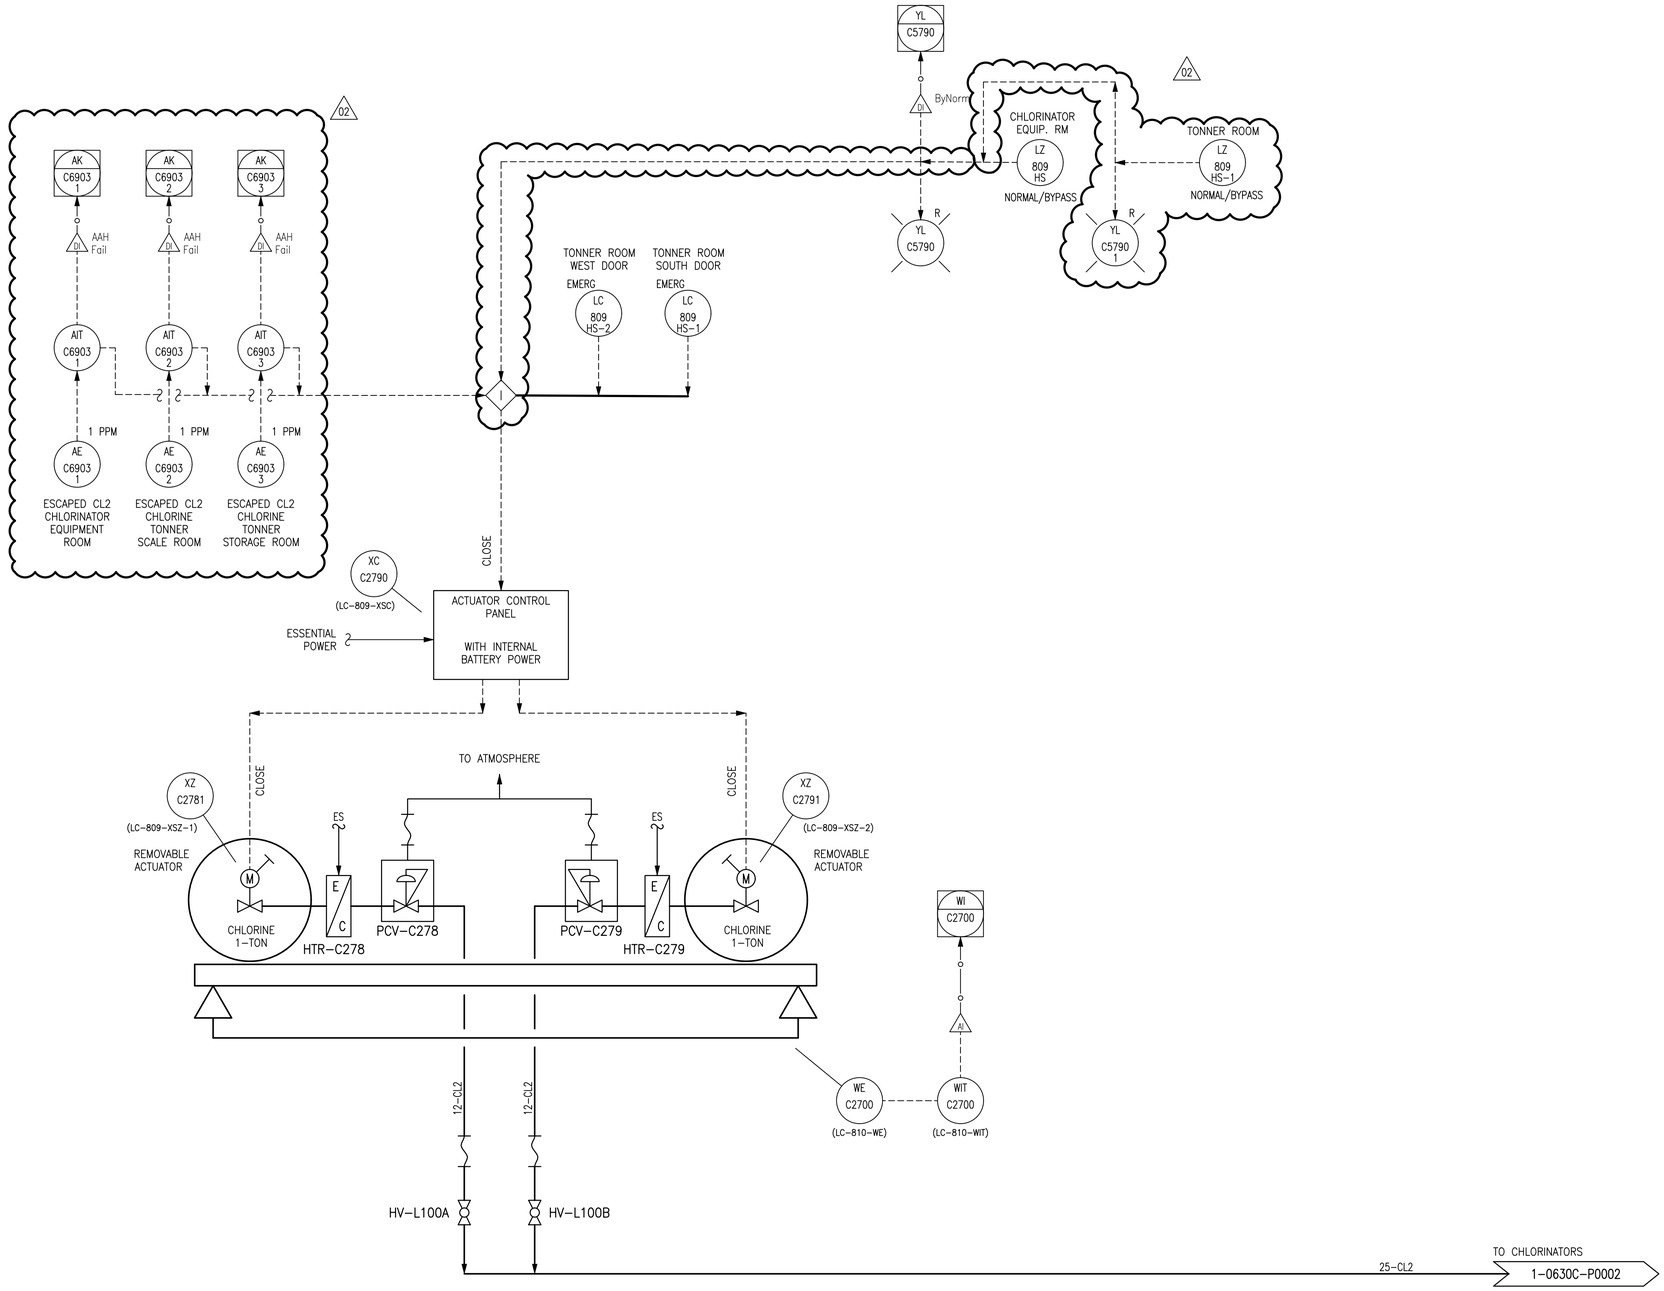

NOTES:

1. DRAWING 1-0630M-A0024 REPRESENTS THE PREVIOUS P&ID. MOST EXISTING DOCUMENTATION IS BASED ON THE IDENTIFICATION SHOWN IN PREVIOUS P&ID.

1-0630A-P0001	PROCESS & INSTRUMENTATION DIAGRAM LEGEND & DETAILS
DRAWING NUMBER	REFERENCE DRAWINGS

ENGINEERS GEOSCIENTISTS MANITOBA
Certificate of Authorization
AtkinsRéalis Canada Inc.
No. 4489

NO.	REVISIONS	DATE	DESIGN	CHECK
02	ISSUED FOR TENDER AND CONSTRUCTION	2025/04/30	VE	VE
01	REVISED DWG	2019/08/23	–	TL
00	ISSUED FOR CITY USE	2013/11/29	EFB	TMC

AtkinsRéalis
148 Nature Park Way, Winnipeg, Manitoba
Canada R3P 0X7 204-786-8080

DESIGNED BY: EXISTING	CHECKED BY: T. CHURCH
DRAWN BY: S. FUNK	APPROVED BY: E. RYCZKOWSKI
SCALE: NTS	ISSUED FOR CONSTRUCTION
DATE: 2012/12/12	BY: M. SKINNER
CONSULTANT NO.:	DATE: 2025/04/30

ENGINEER'S SEAL
PROVINCE OF MANITOBA
V.V. ELIBAN
Member
34636
REGISTERED PROFESSIONAL ENGINEER
2025-05-02

THE CITY OF WINNIPEG
WATER AND WASTE DEPARTMENT

MACLEAN PUMPING STATION

PROCESS & INSTRUMENTATION DIAGRAM
CHLORINE CYLINDER SHUTOFF VALVES

CITY DRAWING NUMBER	SHEET	REV.	SIZE
1-0630C-P0001	001	02	A1

LAST SAVE: 2025/05/01 – 2:31pm
PATH: M:\694715\4ENG\49PRC\DD – General DWG\Maclean\1-0630C-P0001-001-02.dwg