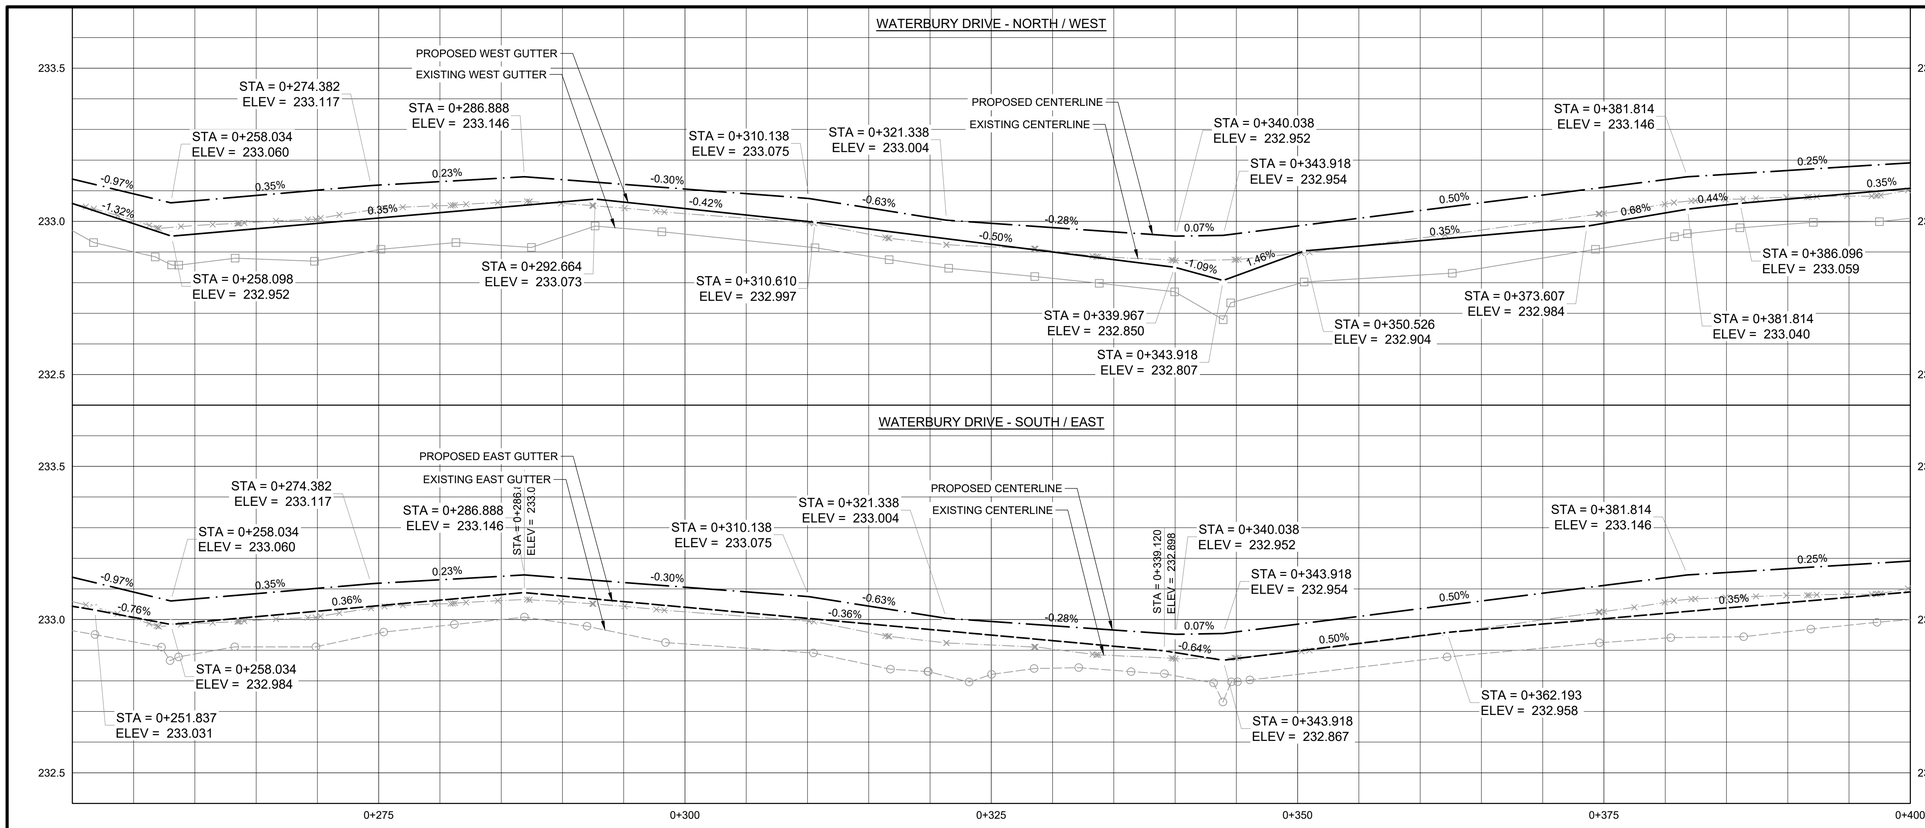

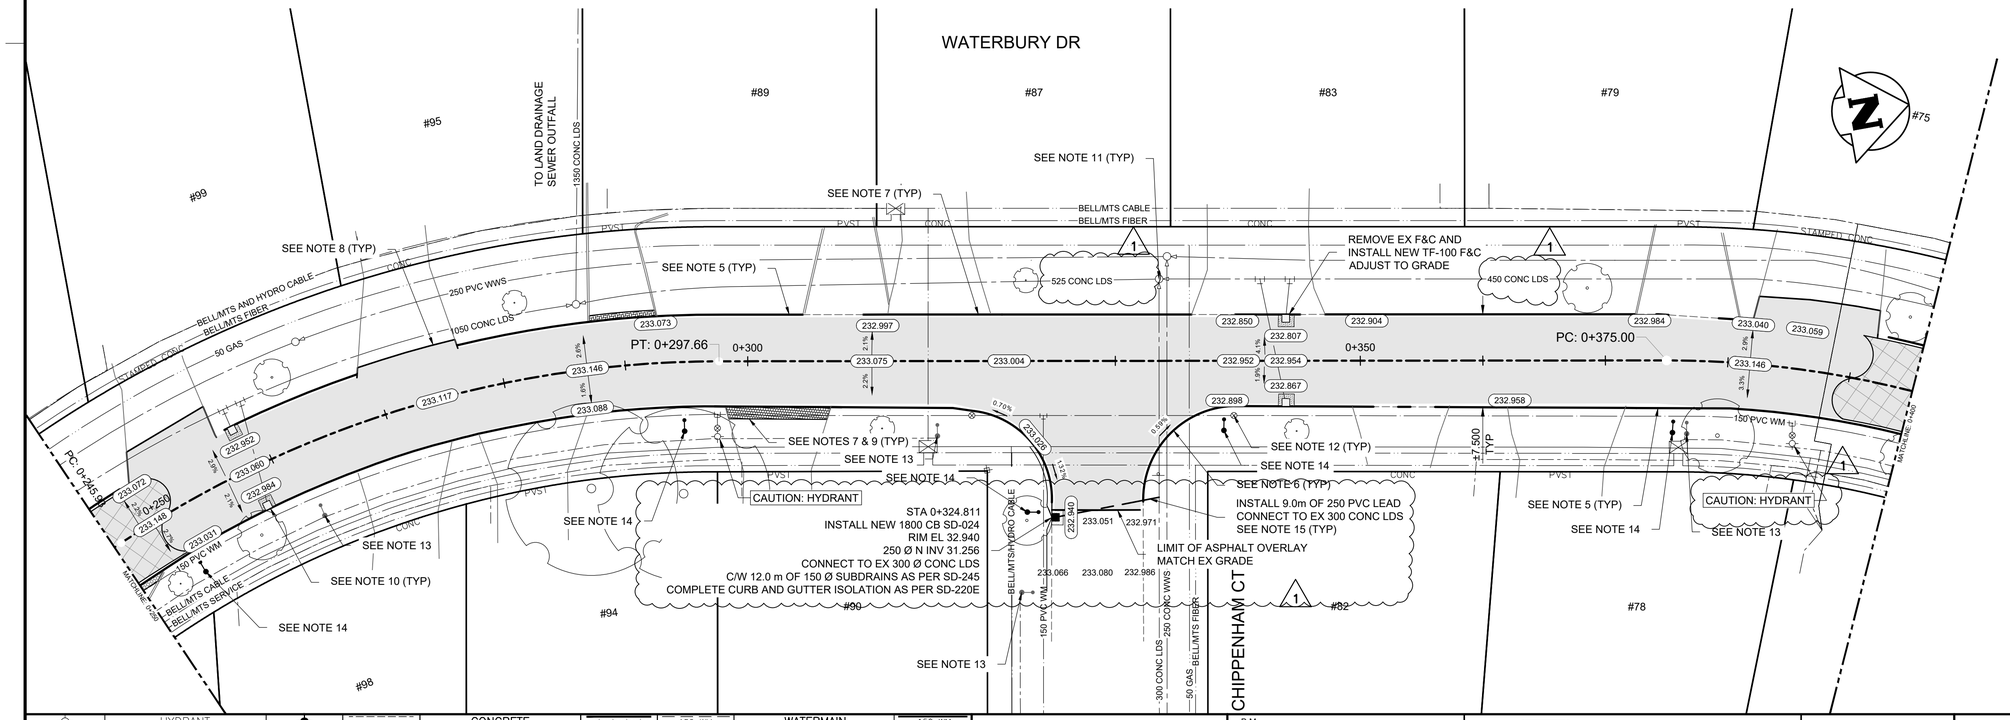

CONSTRUCTION NOTES:

1. ALL WORK AND MATERIALS TO BE IN ACCORDANCE WITH LATEST REVISION OF THE CITY OF WINNIPEG STANDARD CONSTRUCTION SPECIFICATIONS.
2. LEGAL PLAN AND UNDERGROUND INFORMATION FROM CITY OF WINNIPEG LBIS.
3. LOCATION OF EXISTING UTILITIES/SERVICES TO BE CONFIRMED IN THE FIELD BY THE CONTRACTOR.
4. CONTRACTOR TO TAKE PRECAUTIONARY STEPS TO AVOID DAMAGE FROM CONSTRUCTION ACTIVITIES TO TREES WITHIN THE LIMITS OF CONSTRUCTION. REFER TO SPECIFICATION E5-PROTECTION OF EXISTING TREES.
5. MILL EXIST MOUNTABLE CURB AND CONSTRUCT BARRIER CURB DOWELED SD-205 (100 mm REVEAL).
6. REMOVE EXISTING CURB AND CONSTRUCT MODIFIED BARRIER CURB SD-203B (100 mm REVEAL).
7. CONSTRUCT 75 mm LIP CURB SD-202B.
8. OVERLAY EXISTING CURB AND APPROACH WITH ASPHALT TO LIMITS SHOWN.
9. REGRADE EXISTING PAVING STONES.
10. REMOVE MOUNTABLE CURB AND GUTTER FRAME AND COVER AP-015, AP-016, AND INSTALL BARRIER CURB FRAME AND COVER AP-011, AP-012. ADJUST TO GRADE. COMPLETE CATCH BASIN/CATCH PIT CURB ISOLATIONS IN ACCORDANCE WITH SD-220E.
11. ADJUST MANHOLE AND CATCH BASIN RIMS TO NEW GRADES.
12. ADJUST WATER VALVES AND CURB STOPS TO NEW GRADES.
13. REMOVE EXISTING STREET LIGHT POLE AND BASE.
14. INSTALL NEW STREET LIGHT BASE AND POLE.
15. CB AND CP LEADS TO BE INSTALLED TO INVERT ELEVATIONS AS SHOWN. ALL CB AND CP LEADS TO BE INSTALLED AT MIN 2.0% SLOPE AND AS DIRECTED BY CONTRACT ADMINISTRATOR.
16. LIMITS OF BOULEVARD GRADING TO BE FINALIZED IN THE FIELD BY THE CONTRACT ADMINISTRATOR.
17. LAMP STANDARDS, HYDRO POLES AND ANCHORS THAT REQUIRE TEMPORARY SUPPORT, REMOVAL OR REPLACEMENT, TO BE DONE AT THE EXPENSE OF THE CONTRACTOR, AS NECESSARY. REFER TO SPECIFICATION E30-WORKING AROUND MANITOBA HYDRO POLES.
18. ALL DIMENSIONS ARE TO BACK OF CURB.

METRIC

WHOLE NUMBERS INDICATE MILLIMETRES
DECIMALIZED NUMBERS INDICATE METRES

WARNING

IF POWER EQUIPMENT OR EXPLOSIVES ARE TO BE USED FOR EXCAVATION ON THIS PROJECT THE CONTRACTOR MUST:

1. NOTIFY THE GAS COMPANY OF THE PROPOSED LOCATION OF EXCAVATION.
2. TAKE PRECAUTION TO AVOID DAMAGE TO GAS COMPANY INSTALLATIONS SEE PROVINCIAL REGULATION 210/72 FOR DETAILS.
3. OBTAIN EXCAVATION PERMITS PRIOR TO CONSTRUCTION.

ENGINEERS GEOSCIENTISTS MANITOBA
Certificate of Authorization
Tetra Tech Canada Inc.
No. 6499

EXISTING	LEGEND—PLAN	PROPOSED	EXISTING	LEGEND—PLAN	PROPOSED	EXISTING	LEGEND—PROFILE	PROPOSED
☼	HYDRANT	✦		CONCRETE		150 WM	WATERMAIN	150 WM
⊗	VALVE	⊗		ASPHALT		300 LDS	LAND DRAINAGE SEWER	300 LDS
○	MANHOLE	●		SIDEWALK		250 WWS	WASTE WATER SEWER	250 WWS
□	CATCH BASIN	■		PAVING STONES			HYDRANT	
▽	CATCH PIT	▼		PAVEMENT REPAIR FABRIC			VALVE	
150 WM	WATERMAIN	150 WM		PARTIAL DEPTH REPAIR			℄ PROFILE	
300 LDS	LAND DRAINAGE SEWER	300 LDS		PROPERTY LINE			NORTH/WEST GUTTER	
250 WWS	WASTE WATER SEWER	250 WWS	232.000	ELEVATION	(232.000)		SOUTH/EAST GUTTER	
HYDRO	HYDRO	HYDRO		CURB RAMP			NORTH/WEST DITCH	
MTS	M.T.S.	MTS		DETECTABLE TILE			SOUTH/EAST DITCH	
100 GAS	GAS	100 GAS						

UNDERGROUND STRUCTURES

LOCATION OF UNDERGROUND STRUCTURES AS SHOWN ARE BASED ON THE BEST INFORMATION AVAILABLE, BUT NO GUARANTEE IS GIVEN THAT ALL EXISTING UTILITIES ARE SHOWN OR THAT THE GIVEN LOCATIONS ARE EXACT. CONFIRMATION OF EXISTENCE AND EXACT LOCATION OF ALL SERVICES MUST BE OBTAINED FROM THE INDIVIDUAL UTILITIES BEFORE PROCEEDING WITH CONSTRUCTION.

NO.	REVISIONS	DATE	BY
	B.M. ELEV.		
1	ISSUED FOR ADDENDUM 1	26.03.27	JNC
0	ISSUED FOR TENDER	26.03.17	JNC

TETRA TECH

DESIGNED BY	KHL	REVIEWED BY	JT/DL/JNC
DRAWN BY	KHL	APPROVED BY	JNC
SCALE:	H = 1:250 V = 1:10	RELEASED FOR CONSTRUCTION	
DATE	26.03.17	STREETS PROJECT ENGINEER	DATE

ORIGINAL DRAWING REVISION " 0 " SEALED BY J.N. CRANG 26.03.17

CONSULTANT DRAWING NO. 704-INF.MBI03048-01-C019

Winnipeg
THE CITY OF WINNIPEG
PUBLIC WORKS DEPARTMENT

2026 LOCAL STREET RENEWAL PROGRAM
26-R-03

CITY DRAWING NUMBER P-3599-19
SHEET 19 OF 28

MAJOR REHABILITATION
WATERBURY DRIVE (STA 0+250 TO STA 0+400)
PLAN AND PROFILE

C019