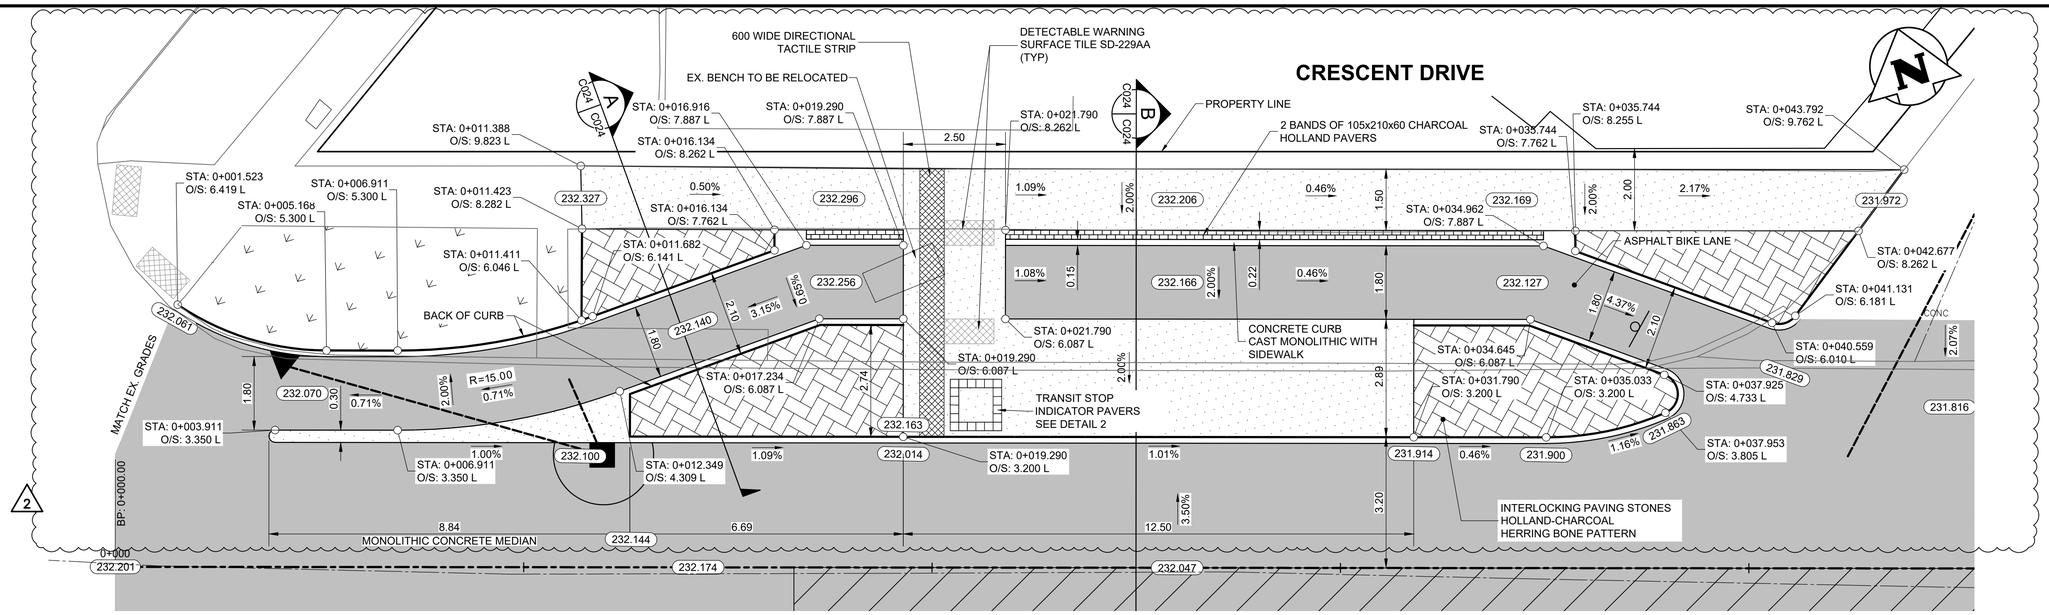

1 BUFFERED BIKE LANE BUS STOP
Scale 1:75

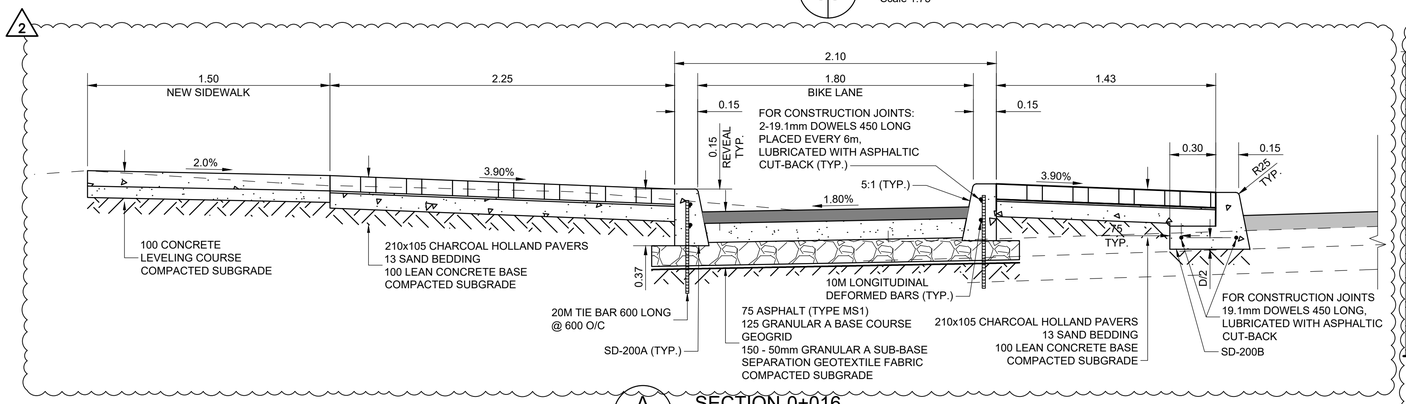

A C024 C024 SECTION-0+016
Scale 1:20

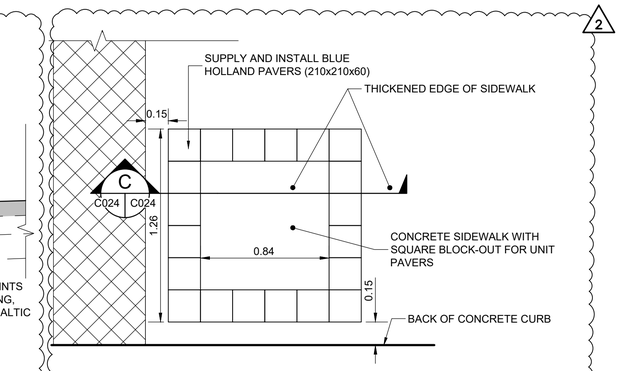

2 TRANSIT STOP INDICATOR PAVERS
Scale 1:75

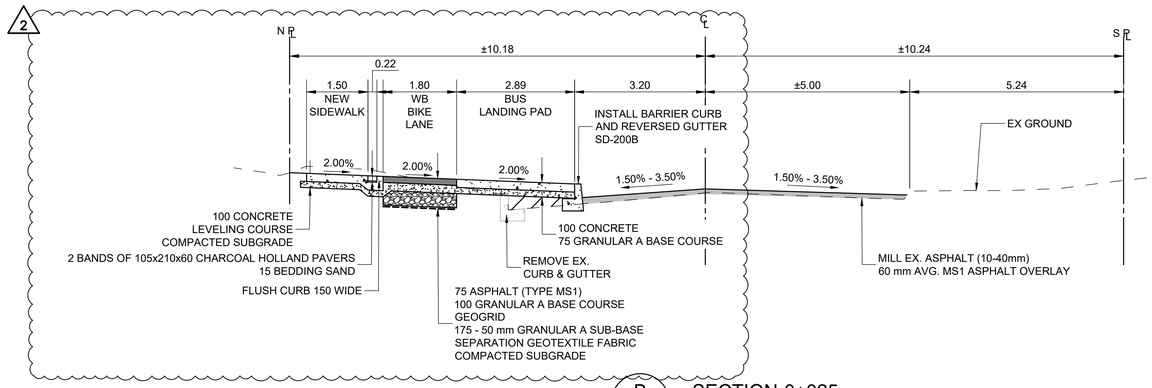

B C024 C024 SECTION-0+025
Scale H=1:75 V=1:37.5

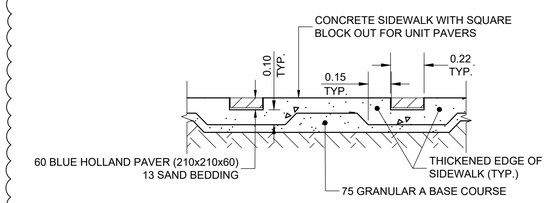

C C024 C024 SECTION
Scale 1:20

METRIC
WHOLE NUMBERS INDICATE MILLIMETRES
DECIMALIZED NUMBERS INDICATE METRES

ENGINEERS GEOSCIENTISTS MANITOBA
Certificate of Authorization
Tetra Tech Canada Inc.
No. 6499

UNDERGROUND STRUCTURES

LOCATION OF UNDERGROUND STRUCTURES AS SHOWN ARE BASED ON THE BEST INFORMATION AVAILABLE, BUT NO GUARANTEE IS GIVEN THAT ALL EXISTING UTILITIES ARE SHOWN OR THAT THE GIVEN LOCATIONS ARE EXACT. CONFIRMATION OF EXISTENCE AND EXACT LOCATION OF ALL SERVICES MUST BE OBTAINED FROM THE INDIVIDUAL UTILITIES BEFORE PROCEEDING WITH CONSTRUCTION.

B.M. ELEV.

NO.	REVISIONS	DATE	BY
2	ISSUED FOR ADDENDUM 2	26.04.02	JNC
1	ISSUED FOR ADDENDUM 1	26.03.27	JNC
0	ISSUED FOR TENDER	26.03.17	JNC

TETRA TECH

DESIGNED BY	CF	REVIEWED BY	JT/DL/JNC
DRAWN BY	DD	APPROVED BY	JNC
SCALE:	AS SHOWN	RELEASED FOR CONSTRUCTION	STREETS PROJECT ENGINEER
DATE	26.03.17	DATE	

ORIGINAL DRAWING REVISION " 0 " SEALED BY J.N. CRANG 26.03.17

CONSULTANT DRAWING NO.
704-INF.MBI03048-01-DWG-C024

Winnipeg
THE CITY OF WINNIPEG
PUBLIC WORKS DEPARTMENT

2026 LOCAL STREET RENEWAL PROGRAM
26-R-03

CITY DRAWING NUMBER P-3599-24
SHEET 24 OF 28

STANDARD DETAILS
SHEET 1 OF 2

C024