



NOTE: CHAINAGES SHOWN ARE ALONG S. R. OF ST. MARY AVE

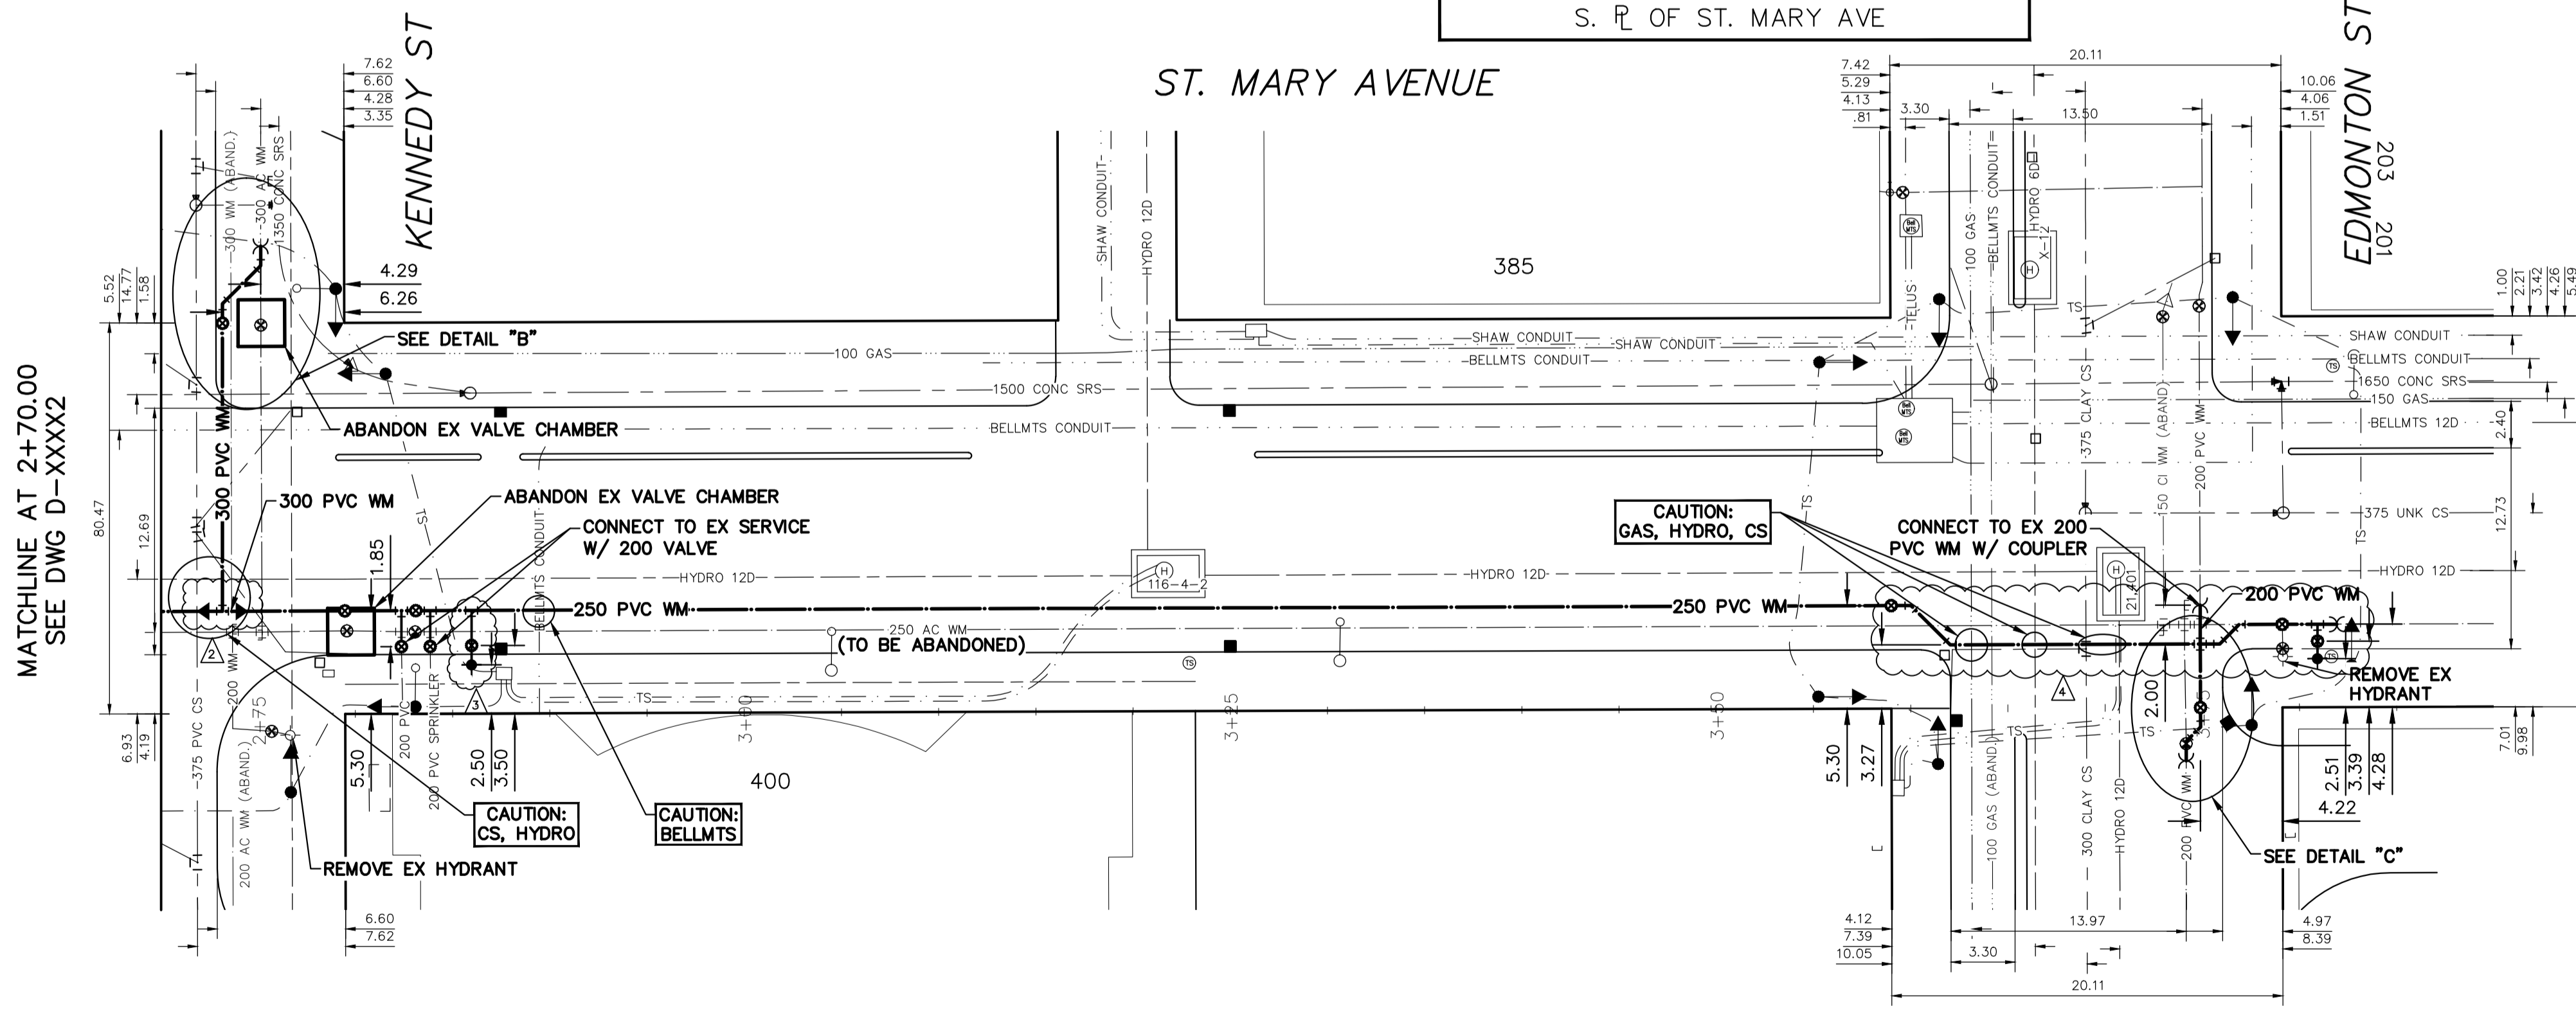


WATER SERVICE INFORMATION

| ADDRESS | SIZE (mm) MATERIAL (STREET) | SIZE (mm) MATERIAL (PROP.) | SHORT & LONG MEASUREMENT | CORP. LOCATION | REMARKS |
|-----------------------------|-----------------------------|----------------------------|--------------------------|----------------|-------------------|
| 400 ST. MARY AVE COMMERCIAL | 200 PVC | 200 PVC | 0.47 EWL BLDG | OPP VALVE | RECONNECT SERVICE |
| 400 ST. MARY AVE SPRINKLER | 200 PVC | 200 PVC | 2.890 EEL KENNEDY ST | OPP VALVE | RECONNECT SERVICE |
| | | | 1.94 EWL BLDG | | |
| | | | 4.368 EEL KENNEDY ST | | |

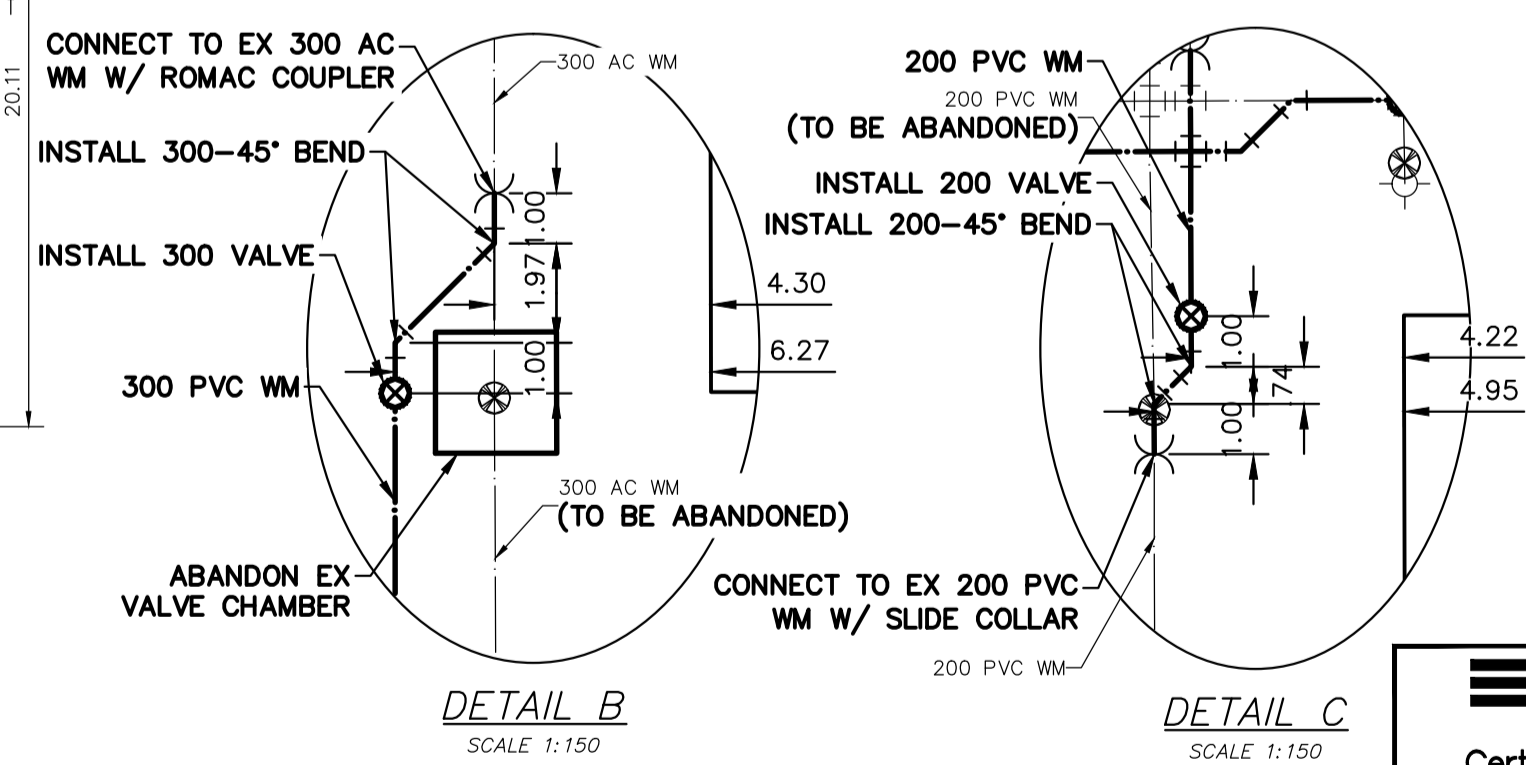

ENGINEERS GEOSCIENTISTS MANITOBA
 Certificate of Authorization
 WSP Canada Inc.
 No. 5750

NOTE: ALL VALVES TO BE INSTALLED COUNTERCLOCKWISE TO CLOSE

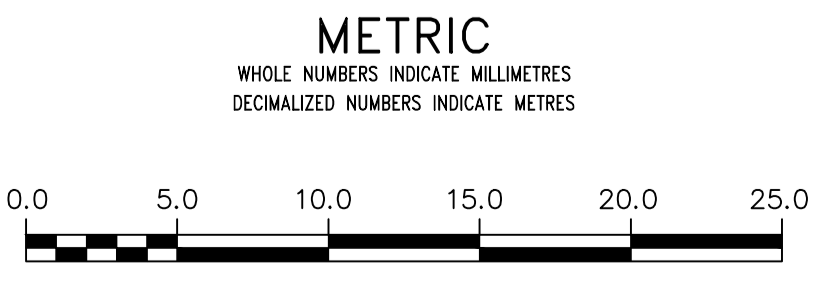

WARNING
 IF POWER EQUIPMENT OR EXPLOSIVES ARE TO BE USED FOR EXCAVATION ON THIS PROJECT THE CONTRACTOR MUST:
 1) NOTIFY THE GAS COMPANY OF THE PROPOSED LOCATION OF EXCAVATION.
 2) TAKE PRECAUTION TO AVOID DAMAGE TO GAS COMPANY INSTALLATIONS.
 SEE PROVINCIAL REGULATION 210/72 FOR DETAILS

LOCATION APPROVED UNDERGROUND STRUCTURES
 SUPV. U/G STRUCTURES COMMITTEE DATE
 NOTE:
 LOCATION OF UNDERGROUND STRUCTURES AS SHOWN ARE BASED ON THE BEST INFORMATION AVAILABLE BUT NO GUARANTEE IS GIVEN THAT ALL EXISTING UTILITIES ARE SHOWN OR THAT THE GIVEN LOCATIONS ARE EXACT. CONFIRMATION OF EXISTENCE AND EXACT LOCATION OF ALL SERVICES MUST BE OBTAINED FROM THE INDIVIDUAL UTILITIES BEFORE PROCEEDING WITH CONSTRUCTION.

| B.M. ELEV. | NO. | REVISIONS | DATE | BY |
|------------|-----|-------------------|------------|------|
| | 1 | ADDENDUM 1 | 2026/02/18 | N.T. |
| | 0 | ISSUED FOR TENDER | 2026/02/03 | N.T. |

wsp
 1600 Buffalo Place
 Winnipeg, Manitoba
 R3T 6B8 Canada
 Phone: 204-477-6650
 Fax: 204-474-2864
 wsp.com

DESIGNED BY: N.T. CHECKED BY: K.G.
 DRAWN BY: N.T. APPROVED BY: S.M.
 SCALE: HORIZONTAL 1:250 VERTICAL 1:50
 DATE: 2026 02 17

ENGINEER'S SEAL
 CONSULTANT DRAWING NUMBER
CA0051531.7175-20

THE CITY OF WINNIPEG
 WATER AND WASTE DEPARTMENT
 ENGINEERING DIVISION
 2026 WATERMAIN RENEWALS - CONTRACT 10
 SHEET 20 OF 36
 CITY DRAWING NUMBER
D-17405
 ST. MARY AVENUE
 9.477 WEL KENNEDY ST TO EDMONTON ST