


- NOTES**
- ADJUST MH AND CB RIMS TO NEW GRADES.
  - LAMP STANDARDS, HYDRO POLES, AND ANCHORS THAT REQUIRE TEMPORARY SUPPORT, REMOVAL OR REPLACEMENT, TO BE DONE SO AT THE EXPENSE OF THE CONTRACTOR AS NECESSARY.
  - CONTRACTOR TO REGRADE/RENEW EXISTING PRIVATE SIDEWALKS TO LIMITS AS SHOWN. SIDEWALKS TO BE RENEWED WITH CONCRETE UNLESS NOTED OTHERWISE.
  - CONTRACTOR TO TAKE PRECAUTIONARY STEPS TO PROTECT EXISTING TREES WITHIN THE LIMITS OF CONSTRUCTION FROM DAMAGE FROM CONSTRUCTION ACTIVITIES AS OUTLINED IN THE SPECIFICATIONS.
  - CONTRACTOR TO CONFIRM THE LOCATION OF ALL UTILITIES/SERVICES IN THE FIELD PRIOR TO CONSTRUCTION.
  - MODIFIED BARRIER CURB TO BE USED AT ALL INTERSECTION RADII, BACK LANE RADII AND BULLNOSES.
  - CONTRACTOR TO OVERLAY DRIVEWAYS TO ENSURE POSITIVE DRAINAGE TO NEW STREET GRADES. FINAL LIMITS TO BE DETERMINED IN THE FIELD BY CONTRACT ADMINISTRATOR.
  - CB SD-023 & SD-024 OFFSETS ARE DIMENSIONED TO BOC. CB SD-025 OFFSETS ARE DIMENSIONED O/C.
  - REFER TO TENDER FOR DETAILS REGARDING TRAFFIC MANAGEMENT.
  - MATCH EXISTING GRADES AT DOOR SILLS.
  - ADJUST EXISTING WATER VALVES AND WATER SERVICE CURB STOPS TO GRADE.
  - ADD 200.000 m TO ABBREVIATED ELEVATIONS TO OBTAIN GEODETIC ELEVATIONS.

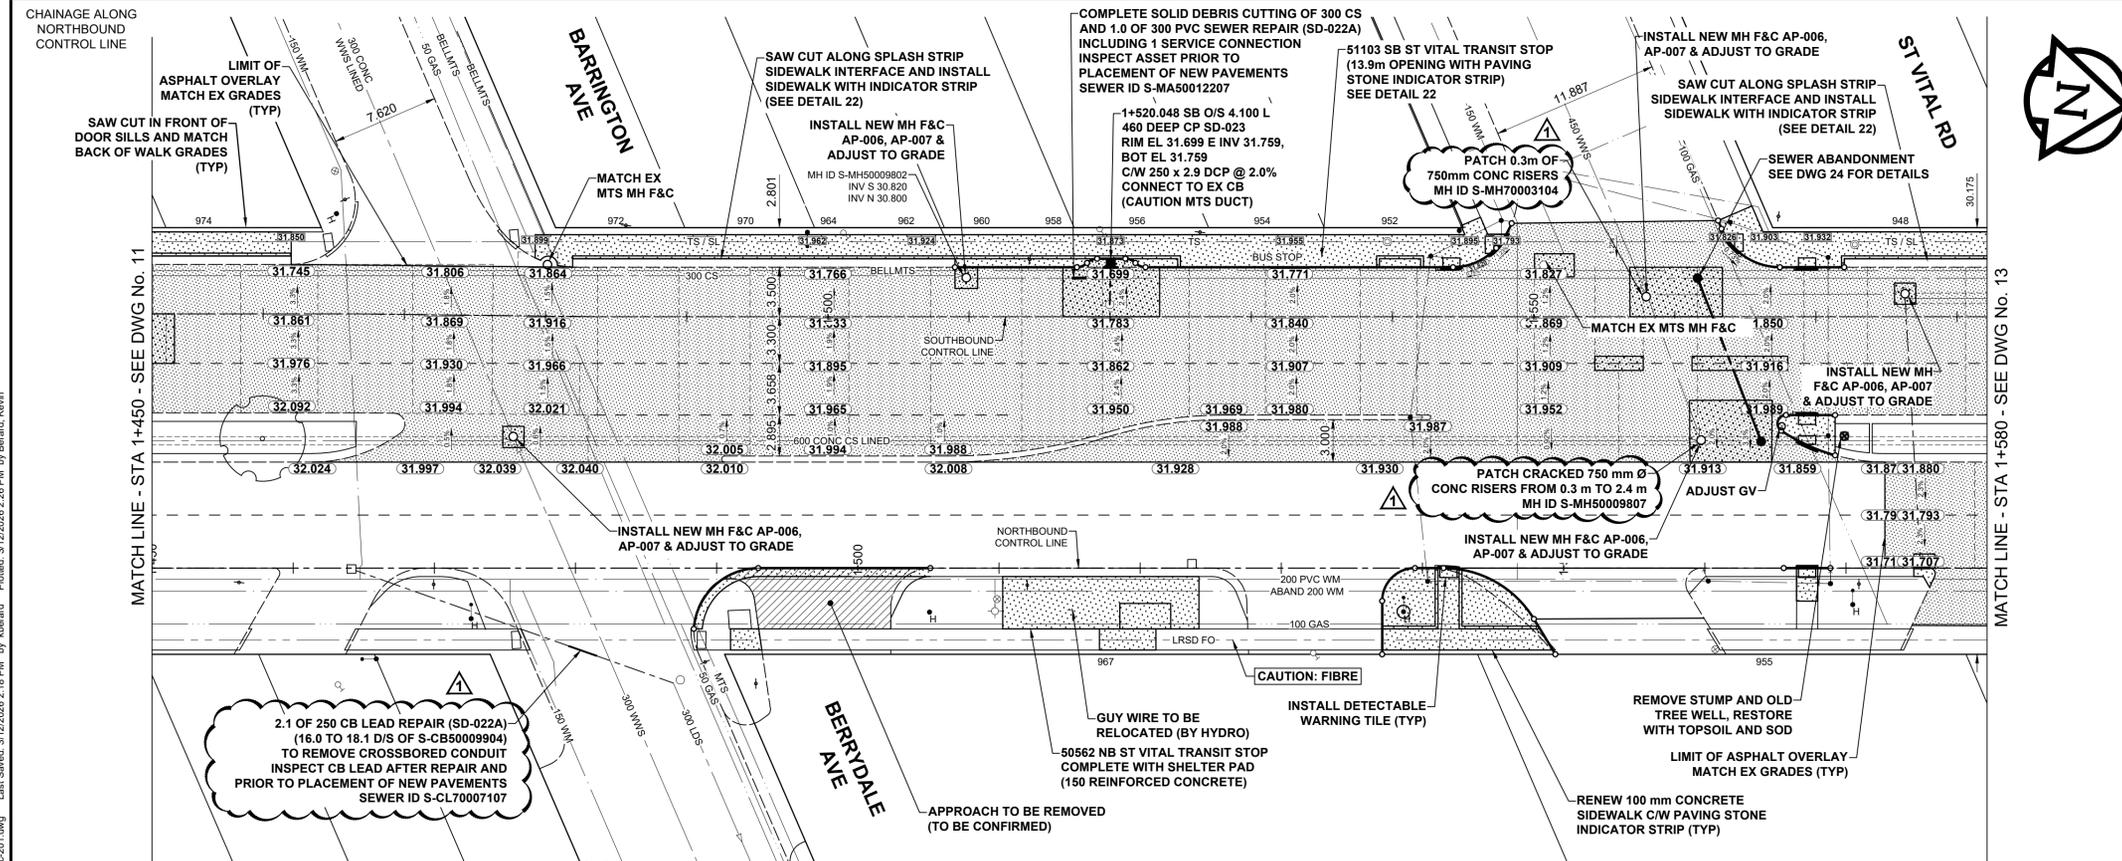

**METRIC**  
WHOLE NUMBERS INDICATE MILLIMETRES  
DECIMAL NUMBERS INDICATE METRES

EXISTING	LEGEND - PLAN	PROPOSED	EXISTING	LEGEND - PLAN	PROPOSED	EXISTING	LEGEND - PLAN	PROPOSED
⊕	HYDRANT	⊕	---	LDS / WWS	---	▒	CONCRETE	▒
⊙	VALVE	⊙	---	WATER MAIN	---	▒	CONC SIDEWALK / MEDIAN	▒
⊚	CURB STOP	⊚	---	GAS	---	▒	ASPHALT	▒
○	MANHOLE	○	---	TRAFFIC SIGNALS	---	▒	PAVING STONE	▒
□	CATCH BASIN / CATCH PIT	□	---	HYDRO / STREET LIGHT	---	▒	GRAVEL	▒
△	CURB INLET	△	---	COMMUNICATIONS	---	▒	PLANING / REMOVAL	▒
+	POLE	+	---	CURB RENEWAL	---	▒	DITCH FLOW	▒
→	LIGHT STANDARD	→	---	PROPERTY LINE	---	▒	TOP OF SLOPE	▒
→	TRAFFIC SIGNAL POLE	→	---	RAMP CURB	---	▒	CULVERT	▒
+	SURVEY BAR	+	---	ELEVATIONS	(33.333)	▒	SEWER FLOW DIRECTION	▒
⊙	GEODETIC BENCH MARK	⊙	---	TREE / TREELINE	---	▒	TEST HOLE / CORE HOLE	▒
⊕	EXISTING	⊕	---	LEGEND - PLAN	---	▒	LEGEND - PLAN	▒

**PLAN**  
SCALE: 1:250

**LOCATION APPROVED UNDERGROUND STRUCTURES**

Tablet in 7.6m Conc. Pile in Median of St Mary's at Portland Ave. Projection of South P Line of Portland Ave & 16.3m West of the East P Line of St Mary's Rd.

DESIGNED BY: GFC  
CHECKED BY: JGK  
DRAWN BY: KMB  
APPROVED BY: RPB

HOR SCALE: 1:250  
VERT SCALE: 1:10

DATE: February 24, 2026

**ENGINEERS GEOSCIENTISTS MANITOBA**  
Certificate of Authorization  
Stantec Consulting Ltd.  
No. 1301

TENDER No. 30-2026

**THE CITY OF WINNIPEG**  
PUBLIC WORKS DEPARTMENT  
ENGINEERING DIVISION

**2026 REGIONAL STREET RENEWALS**  
ST. MARY'S ROAD  
ABINOJI MIKANAH TO FERMOR AVENUE

ASPHALT REHABILITATION  
PAVING AND GRADING  
STA 1+450 TO STA 1+580

CITY DRAWING NUMBER: P-3598-12  
SHEET 12 OF 25  
DRAWING NUMBER: 12