



PROFILE
VERTICAL SCALE: 1:10
0 0.1 0.2 0.3 0.4 0.5m


- NOTES**
- ADJUST MH AND CB RIMS TO NEW GRADES.
 - LAMP STANDARDS, HYDRO POLES, AND ANCHORS THAT REQUIRE TEMPORARY SUPPORT, REMOVAL OR REPLACEMENT, TO BE DONE SO AT THE EXPENSE OF THE CONTRACTOR AS NECESSARY.
 - CONTRACTOR TO TAKE PRECAUTIONARY STEPS TO PROTECT EXISTING TREES WITHIN THE LIMITS OF CONSTRUCTION FROM DAMAGE FROM CONSTRUCTION ACTIVITIES AS OUTLINED IN THE SPECIFICATIONS.
 - CONTRACTOR TO CONFIRM THE LOCATION OF ALL UTILITIES/SERVICES IN THE FIELD PRIOR TO CONSTRUCTION.
 - REFER TO TENDER FOR DETAILS REGARDING TRAFFIC MANAGEMENT.
 - ADD 200.000 m TO ABBREVIATED ELEVATIONS TO OBTAIN GEODETIC ELEVATIONS.

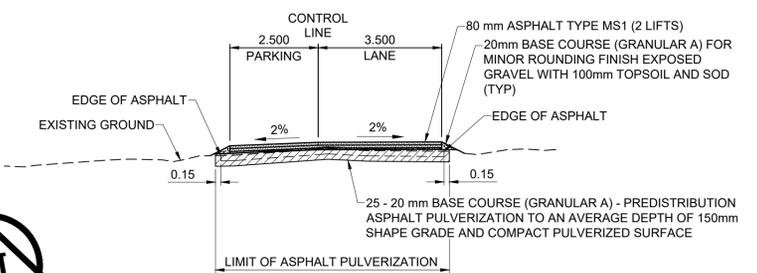


TYPICAL PAVEMENT SECTION
ASPHALT PULVERIZATION
(STA 1+012.035 TO STA 1+518.393)
SCALE: NTS

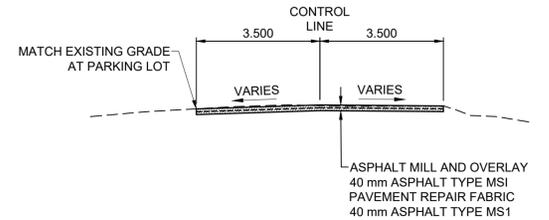


TYPICAL PAVEMENT SECTION
ASPHALT MILL AND FILL
SCALE: NTS

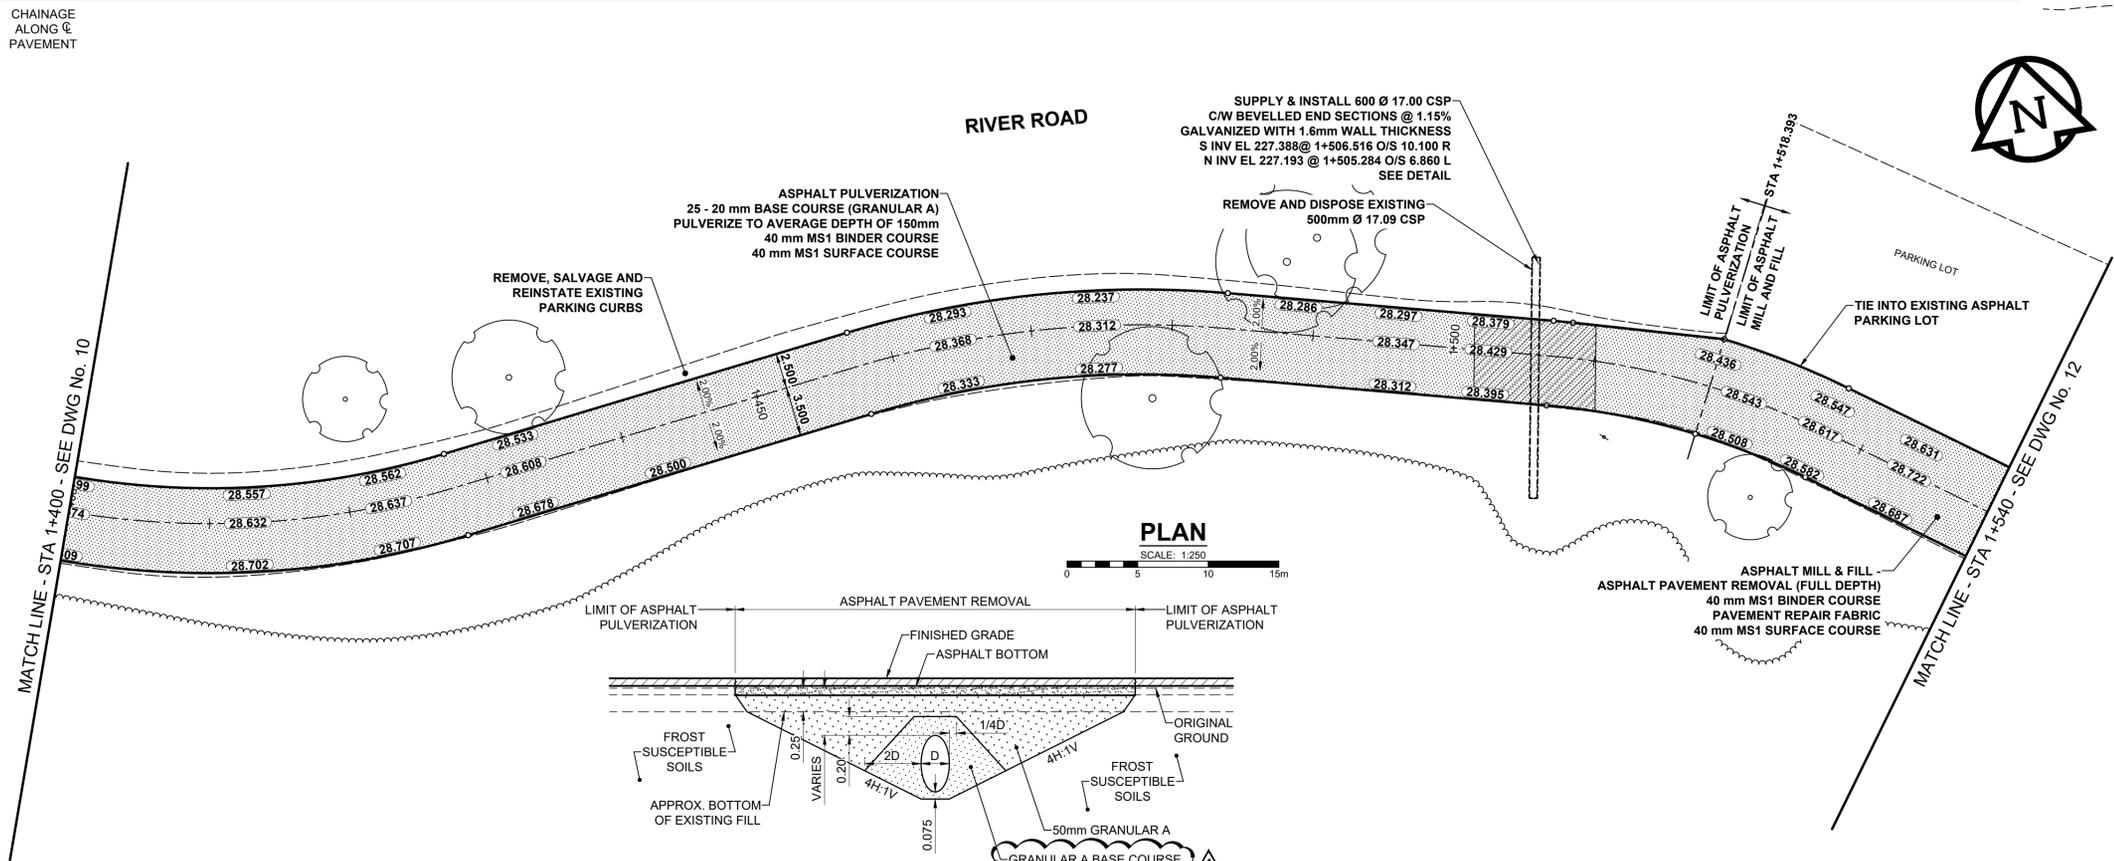

PLAN
SCALE: 1:250
0 5 10 15m

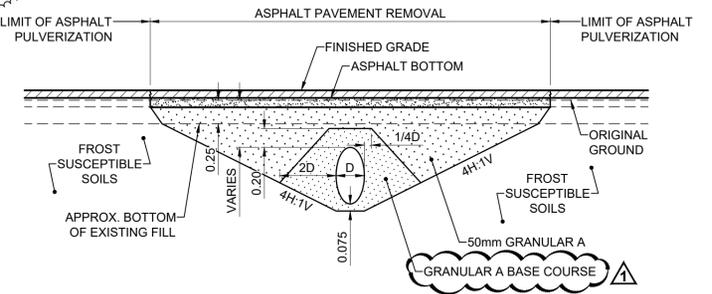

TYPICAL CULVERT INSTALLATION
SCALE: NTS

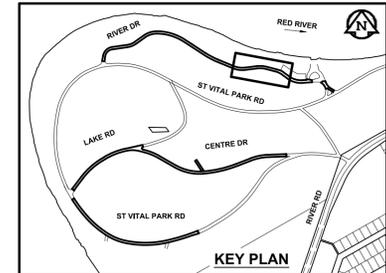

ENGINEERS GEOSCIENTISTS MANITOBA
Certificate of Authorization
Stantec Consulting Ltd.
No. 1301
TENDER No. 32-2026

METRIC
WHOLE NUMBERS INDICATE MILLIMETRES
DECIMALIZED NUMBERS INDICATE METRES

EXISTING	LEGEND - PLAN	PROPOSED	EXISTING	LEGEND - PLAN	PROPOSED	EXISTING	LEGEND - PLAN	PROPOSED
○	HYDRANT	◆	---	LDS / WWS	---	---	CONCRETE	---
○	VALVE	◆	---	WATER MAIN	---	---	CONC SIDEWALK / MEDIAN	---
○	CURB STOP	◆	---	GAS	---	---	ASPHALT	---
○	MANHOLE	◆	---	TRAFFIC SIGNALS	---	---	PAVING STONE	---
□	CATCH BASIN / CATCH PIT	◆	---	HYDRO / STREET LIGHT	---	---	GRAVEL	---
△	CURB INLET	◆	---	COMMUNICATIONS	---	---	PLANING / REMOVAL	---
•	POLE	◆	---	CURB RENEWAL	---	---	DITCH FLOW	---
•	LIGHT STANDARD	◆	---	PROPERTY LINE	---	---	TOP OF SLOPE	---
•	TRAFFIC SIGNAL POLE	◆	---	RAMP CURB	---	---	CULVERT	---
+	SURVEY BAR	◆	---	ELEVATIONS	---	---	SEWER FLOW DIRECTION	---
⊕	GEODETIC BENCH MARK	◆	---	TREE / TREELINE	---	---	TEST HOLE / CORE HOLE	---
⊕	LEGEND - PLAN	◆	---	PROPOSED	---	---	LEGEND - PLAN	---

DESIGNED BY	DATE	CHECKED BY	DATE
MEE <td>26/03/16 <td>JGK <td>26/03/16 </td></td></td>	26/03/16 <td>JGK <td>26/03/16 </td></td>	JGK <td>26/03/16 </td>	26/03/16
KMB <td>26/03/06 <td>JGK <td>26/03/06 </td></td></td>	26/03/06 <td>JGK <td>26/03/06 </td></td>	JGK <td>26/03/06 </td>	26/03/06

LOCATION APPROVED
UNDERGROUND STRUCTURES

DATE: _____

NOTE:
LOCATION OF UNDERGROUND STRUCTURES AS SHOWN ARE BASED ON THE BEST INFORMATION AVAILABLE BUT NO GUARANTEE IS GIVEN THAT ALL EXISTING UTILITIES ARE SHOWN OR THAT THE GIVEN LOCATIONS ARE EXACT. CONFIRMATION OF EXISTENCE AND EXACT LOCATION OF ALL SERVICES MUST BE OBTAINED FROM THE INDIVIDUAL UTILITIES BEFORE PROCEEDING WITH CONSTRUCTION.

Stantec
500 - 311 Portage Avenue, Winnipeg MB Canada R3B 2B9
Tel. 204.489.5900 Fax. 204.453.9012 www.stantec.com

DESIGNED BY	DATE	CHECKED BY	DATE
MEE <td>26/03/16 <td>JGK <td>26/03/16 </td></td></td>	26/03/16 <td>JGK <td>26/03/16 </td></td>	JGK <td>26/03/16 </td>	26/03/16
KMB <td>26/03/06 <td>JGK <td>26/03/06 </td></td></td>	26/03/06 <td>JGK <td>26/03/06 </td></td>	JGK <td>26/03/06 </td>	26/03/06

PROFESSIONAL'S SEAL

ORIGINAL DRAWING REV No. 0

SEALED BY: J.G. KENNEDY Member 22326 2026-03-06

CONSULTANT FILE NAME: 01008c-SVP_River.dwg

THE CITY OF WINNIPEG
PUBLIC WORKS DEPARTMENT
ENGINEERING DIVISION

2026 LOCAL STREET RENEWAL PROGRAM
ST VITAL PARK - RIVER DRIVE
ST VITAL PARK ROAD TO ST VITAL PARK ROAD
PAVEMENT REHABILITATION
PAVING AND GRADING
STA 1+400 TO STA 1+540

CITY DRAWING NUMBER: N/A
SHEET 11 OF 20
DRAWING NUMBER: 11