

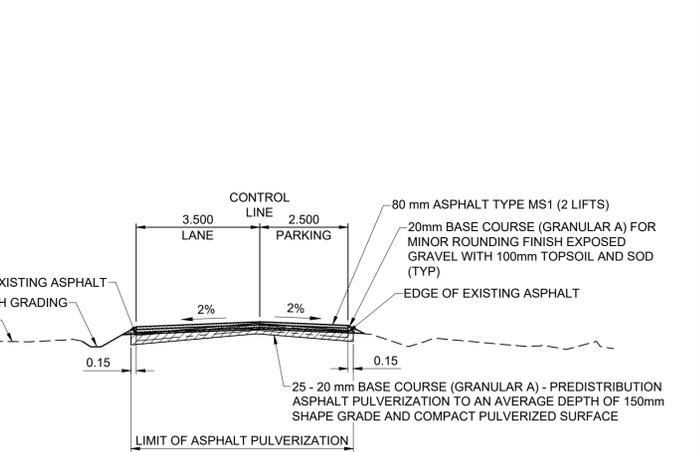



- NOTES**
- ADJUST MH AND CB RIMS TO NEW GRADES.
  - LAMP STANDARDS, HYDRO POLES, AND ANCHORS THAT REQUIRE TEMPORARY SUPPORT, REMOVAL OR REPLACEMENT, TO BE DONE SO AT THE EXPENSE OF THE CONTRACTOR AS NECESSARY.
  - CONTRACTOR TO TAKE PRECAUTIONARY STEPS TO PROTECT EXISTING TREES WITHIN THE LIMITS OF CONSTRUCTION FROM DAMAGE FROM CONSTRUCTION ACTIVITIES AS OUTLINED IN THE SPECIFICATIONS.
  - CONTRACTOR TO CONFIRM THE LOCATION OF ALL UTILITIES/SERVICES IN THE FIELD PRIOR TO CONSTRUCTION.
  - REFER TO TENDER FOR DETAILS REGARDING TRAFFIC MANAGEMENT.
  - ADD 200.000 m TO ABBREVIATED ELEVATIONS TO OBTAIN GEODETIC ELEVATIONS.

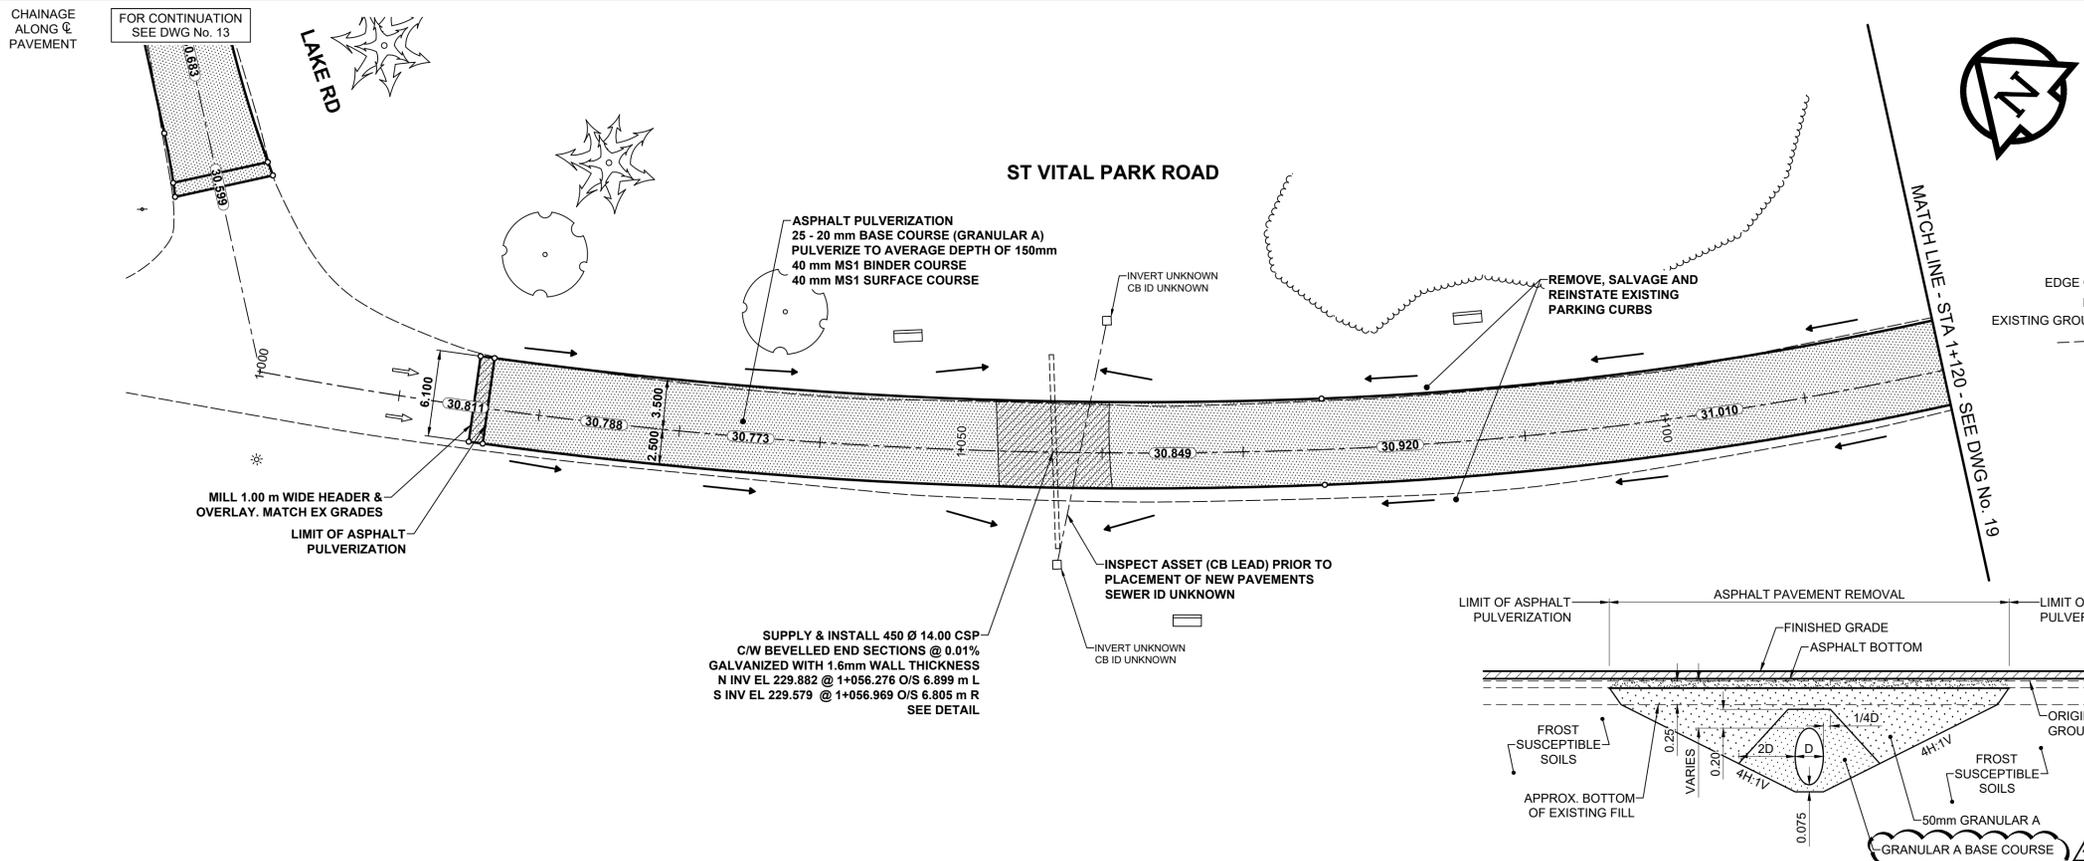

**TYPICAL PAVEMENT SECTION**  
ASPHALT PULVERIZATION  
SCALE: NTS

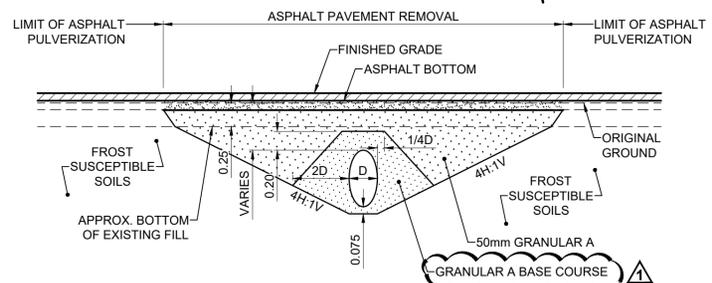

**TYPICAL CULVERT INSTALLATION**  
SCALE: NTS

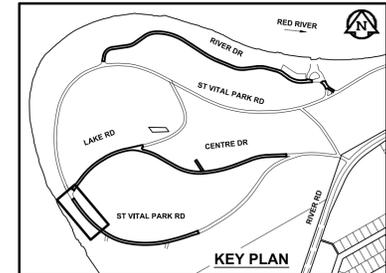

**ENGINEERS GEOSCIENTISTS MANITOBA**  
Certificate of Authorization  
Stantec Consulting Ltd.  
No. 1301  
TENDER No. 32-2026

**METRIC**  
WHOLE NUMBERS INDICATE MILLIMETRES  
DECIMALIZED NUMBERS INDICATE METRES

**PLAN**  
SCALE: 1:250

EXISTING	LEGEND - PLAN	PROPOSED	EXISTING	LEGEND - PLAN	PROPOSED	EXISTING	LEGEND - PLAN	PROPOSED
⊕	HYDRANT	⊕	---	LDS / WWS	---	---	CONCRETE	---
⊙	VALVE	⊙	---	WATER MAIN	---	---	CONC SIDEWALK / MEDIAN	---
⊖	CURB STOP	⊖	---	GAS	---	---	ASPHALT	---
○	MANHOLE	●	---	TRAFFIC SIGNALS	---	---	PAVING STONE	---
□	CATCH BASIN / CATCH PIT	■	---	HYDRO / STREET LIGHT	---	---	GRAVEL	---
△	CURB INLET	▲	---	COMMUNICATIONS	---	---	PLANING / REMOVAL	---
•	POLE	•	---	CURB RENEWAL	---	---	DITCH FLOW	---
→	LIGHT STANDARD	→	---	PROPERTY LINE	---	---	TOP OF SLOPE	---
→	TRAFFIC SIGNAL POLE	→	---	RAMP CURB	---	---	CULVERT	---
+	SURVEY BAR	+	---	ELEVATIONS	(33.333)	---	SEWER FLOW DIRECTION	---
⊕	GEODETIC BENCH MARK	⊕	---	TREE / TREELINE	---	---	TEST HOLE / CORE HOLE	---

**LOCATION APPROVED UNDERGROUND STRUCTURES**

DATE: \_\_\_\_\_

**NOTE:** LOCATION OF UNDERGROUND STRUCTURES AS SHOWN ARE BASED ON THE BEST INFORMATION AVAILABLE BUT NO GUARANTEE IS GIVEN THAT ALL EXISTING UTILITIES ARE SHOWN OR THAT THE GIVEN LOCATIONS ARE EXACT. CONFIRMATION OF EXISTENCE AND EXACT LOCATION OF ALL SERVICES MUST BE OBTAINED FROM THE INDIVIDUAL UTILITIES BEFORE PROCEEDING WITH CONSTRUCTION.

No.	REVISIONS	DATE	BY
1	REVISED FOR ADDENDUM 1	26/03/16	JGK
0	ISSUED FOR TENDER	26/03/06	JGK

PROFESSIONAL'S SEAL

DESIGNED BY: MEE  
DRAWN BY: KMB

CHECKED BY: JGK  
APPROVED BY: RPB

RELEASED FOR CONSTRUCTION

HOR SCALE: 1:250  
VERT SCALE: 1:10

DATE: March 6, 2026

**Stantec**  
500 - 311 Portage Avenue, Winnipeg MB Canada R3B 2B9  
Tel. 204.489.5900 Fax. 204.453.9012 www.stantec.com

**THE CITY OF WINNIPEG**  
PUBLIC WORKS DEPARTMENT  
ENGINEERING DIVISION

**2026 LOCAL STREET RENEWAL PROGRAM**  
**ST VITAL PARK ROAD**  
**LAKE ROAD TO EAST LIMIT**  
**PAVING AND GRADING**  
LAKE ROAD TO STA 1+120

CITY DRAWING NUMBER: N/A  
SHEET OF: 18 OF 20  
DRAWING NUMBER: 18

DESIGNED BY: MEE  
DRAWN BY: KMB  
CHECKED BY: JGK  
APPROVED BY: RPB  
RELEASED FOR CONSTRUCTION

ORIGINAL DRAWING REV No. 0  
SEALED BY: J.G. KENNEDY  
Member 22326  
2026-03-06

CONSULTANT FILE NAME: 01008c-SVP\_Park\_road.dwg