

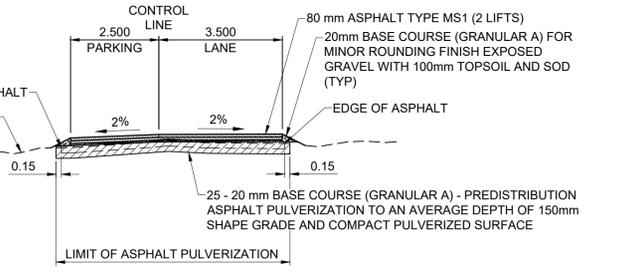


- NOTES**
- ADJUST MH AND CB RIMS TO NEW GRADES.
 - LAMP STANDARDS, HYDRO POLES, AND ANCHORS THAT REQUIRE TEMPORARY SUPPORT, REMOVAL OR REPLACEMENT, TO BE DONE SO AT THE EXPENSE OF THE CONTRACTOR AS NECESSARY.
 - CONTRACTOR TO TAKE PRECAUTIONARY STEPS TO PROTECT EXISTING TREES WITHIN THE LIMITS OF CONSTRUCTION FROM DAMAGE FROM CONSTRUCTION ACTIVITIES AS OUTLINED IN THE SPECIFICATIONS.
 - CONTRACTOR TO CONFIRM THE LOCATION OF ALL UTILITIES/SERVICES IN THE FIELD PRIOR TO CONSTRUCTION.
 - REFER TO TENDER FOR DETAILS REGARDING TRAFFIC MANAGEMENT.
 - ADD 200.000 m TO ABBREVIATED ELEVATIONS TO OBTAIN GEODETIC ELEVATIONS.

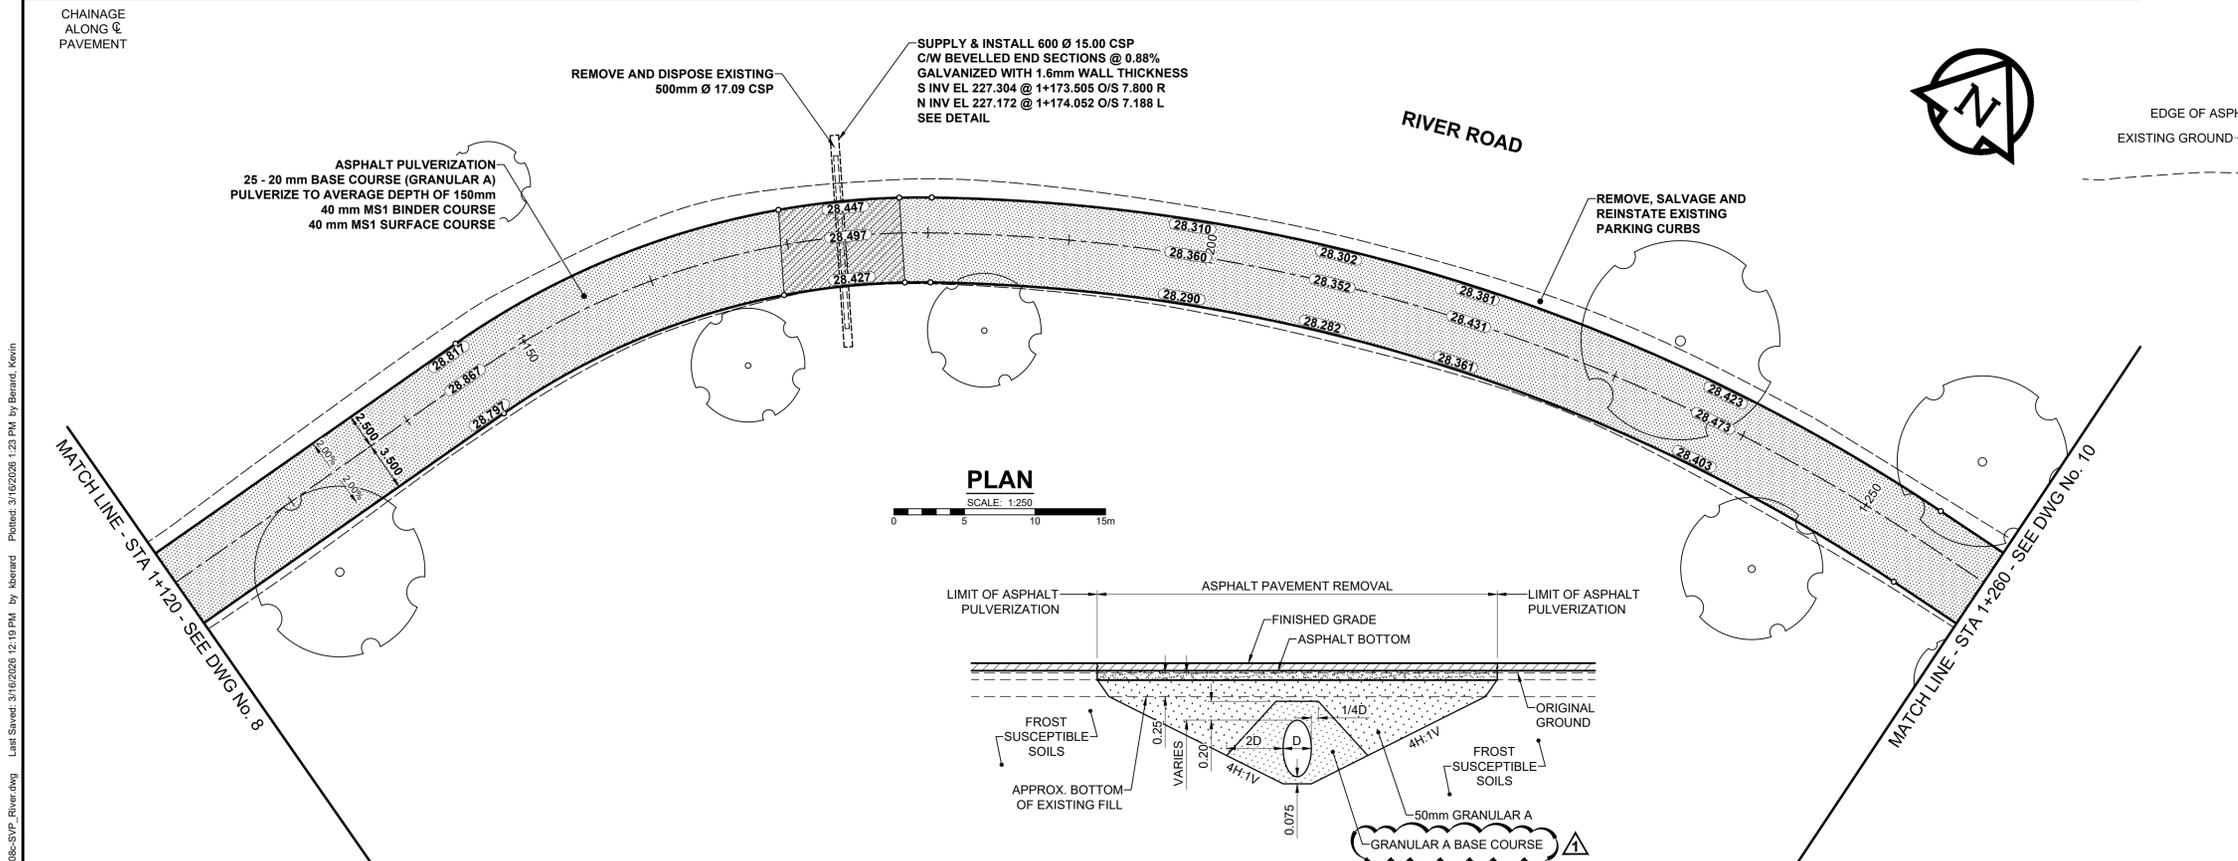

TYPICAL PAVEMENT SECTION
 ASPHALT PULVERIZATION
 (STA 1+012.035 TO STA 1+518.393)
 SCALE: NTS

TYPICAL CULVERT INSTALLATION
 SCALE: NTS

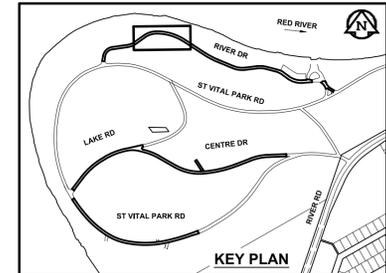

ENGINEERS GEOSCIENTISTS MANITOBA
 Certificate of Authorization
 Stantec Consulting Ltd.
 No. 1301
 TENDER No. 32-2026

METRIC
 WHOLE NUMBERS INDICATE MILLIMETRES
 DECIMALIZED NUMBERS INDICATE METRES

EXISTING	LEGEND - PLAN	PROPOSED	EXISTING	LEGEND - PLAN	PROPOSED	EXISTING	LEGEND - PLAN	PROPOSED
○	HYDRANT	◆	---	LDS / WWS	---	▨	CONCRETE	▨
⊙	VALVE	⊙	---	WATER MAIN	---	▨	CONC SIDEWALK / MEDIAN	▨
⊙	CURB STOP	⊙	---	GAS	---	▨	ASPHALT	▨
○	MANHOLE	●	---	TRAFFIC SIGNALS	---	▨	PAVING STONE	▨
□	CATCH BASIN / CATCH PIT	■	---	HYDRO / STREET LIGHT	---	▨	GRAVEL	▨
△	CURB INLET	▲	---	COMMUNICATIONS	---	▨	PLANING / REMOVAL	▨
•	POLE	•	---	CURB RENEWAL	---	▨	DITCH FLOW	▨
•	LIGHT STANDARD	•	---	PROPERTY LINE	---	▨	TOP OF SLOPE	▨
•	TRAFFIC SIGNAL POLE	•	---	RAMP CURB	---	▨	CULVERT	▨
+	SURVEY BAR	+	33.000	ELEVATIONS	(33.333)	▨	SEWER FLOW DIRECTION	▨
⊙	GEODETIC BENCH MARK	⊙	⊙	TREE / TREELINE	⊙	◆	TEST HOLE / CORE HOLE	◆
⊙	LEGEND - PLAN	⊙	PROPOSED	LEGEND - PLAN	PROPOSED	▨	LEGEND - PLAN	PROPOSED

LOCATION APPROVED
 UNDERGROUND STRUCTURES

DATE: _____

NOTE:
 LOCATION OF UNDERGROUND STRUCTURES AS SHOWN ARE BASED ON THE BEST INFORMATION AVAILABLE BUT NO GUARANTEE IS GIVEN THAT ALL EXISTING UTILITIES ARE SHOWN OR THAT THE GIVEN LOCATIONS ARE EXACT. CONFIRMATION OF EXISTENCE AND EXACT LOCATION OF ALL SERVICES MUST BE OBTAINED FROM THE INDIVIDUAL UTILITIES BEFORE PROCEEDING WITH CONSTRUCTION.

No.	REVISIONS	DATE	BY
1	REVISED FOR ADDENDUM 1	26/03/16	JGK
0	ISSUED FOR TENDER	26/03/06	JGK

Stantec
 500 - 311 Portage Avenue, Winnipeg MB Canada R3B 2B9
 Tel. 204.489.5900 Fax. 204.453.9012 www.stantec.com

DESIGNED BY: MEE
 DRAWN BY: KMB

CHECKED BY: JGK
 APPROVED BY: RPB

RELEASED FOR CONSTRUCTION

HOR SCALE: 1:250
 VERT SCALE: 1:10

DATE: March 6, 2026

PROFESSIONAL'S SEAL

ORIGINAL DRAWING
 REV No. 0

SEALED BY:
 J.G. KENNEDY
 Member 22326
 2026-03-06

CONSULTANT FILE NAME
 01008c-SVP_River.dwg

THE CITY OF WINNIPEG
 PUBLIC WORKS DEPARTMENT
 ENGINEERING DIVISION

2026 LOCAL STREET RENEWAL PROGRAM
ST VITAL PARK - RIVER DRIVE
ST VITAL PARK ROAD TO ST VITAL PARK ROAD
PAVEMENT REHABILITATION
PAVING AND GRADING
 STA 1+120 TO STA 1+260

CITY DRAWING NUMBER: N/A
 SHEET 9 OF 20
 DRAWING NUMBER: 9