

1 A3.3 ENLARGED RENOVATION PLAN - DIVE TOWER STAIR TILE LAYOUT
SCALE: 1:10

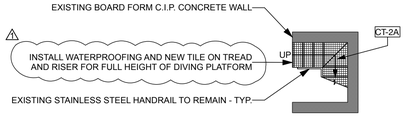

2 A3.3 ENLARGED RENOVATION PLAN - DIVING PLATFORM STAIR A
1:75

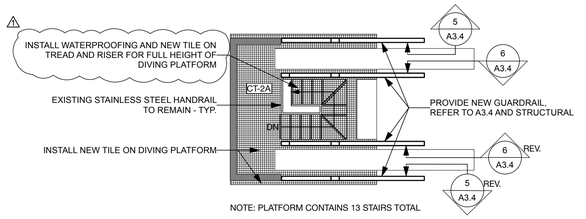

3 A3.3 ENLARGED RENOVATION PLAN - DIVING PLATFORM STAIR A
1:75

TILE SCHEDULE

CODE	MANUFACTURER	PRODUCT	DESCRIPTION	LOCATION
CT-2A	DALTILE	KEYSTONES	51mm x 51mm (2"x 2"), PEPPER WHITE D037	DIVE TOWER STAIRS AND PLATFORM
CT-2B	DALTILE	KEYSTONES	51mm x 51mm (2"x 2"), BLACK D311	DIVE TOWER STAIR NOSING
RM-1	MALMSTEN	ROUGH-TEX 2-PLY	ANTI-SLIP RUBBER MATTING	DIVE TOWER PLATFORMS

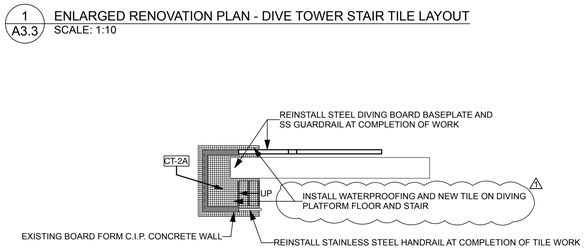

4 A3.3 ENLARGED RENOVATION PLAN - DIVING PLATFORM STAIR C & D
1:75

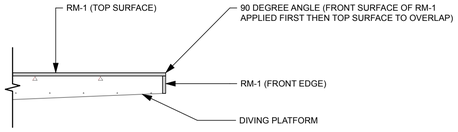

11 A3.3 DIVING PLATFORM - RUBBER MATTING DETAIL
1:25

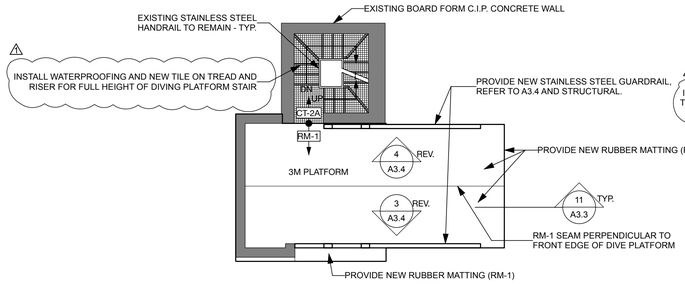

6 A3.3 ENLARGED RENOVATION PLAN - DIVING PLATFORM STAIR B
1:75

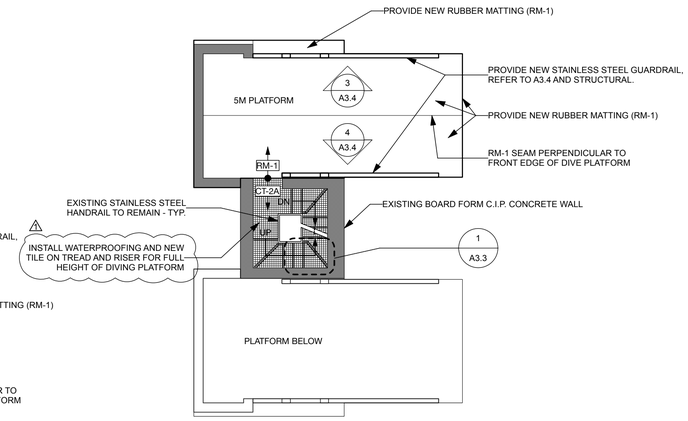

7 A3.3 ENLARGED RENOVATION PLAN - DIVING PLATFORM STAIR B
1:75

5 A3.3 ENLARGED RENOVATION PLAN - DIVING PLATFORM STAIR B
1:75

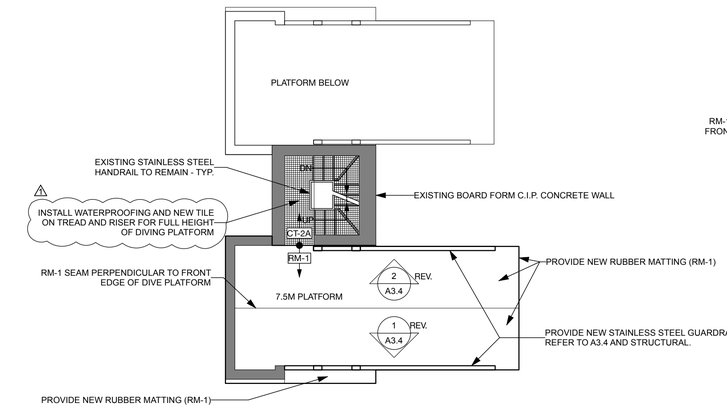

8 A3.3 ENLARGED RENOVATION PLAN - DIVING PLATFORM STAIR B
1:75

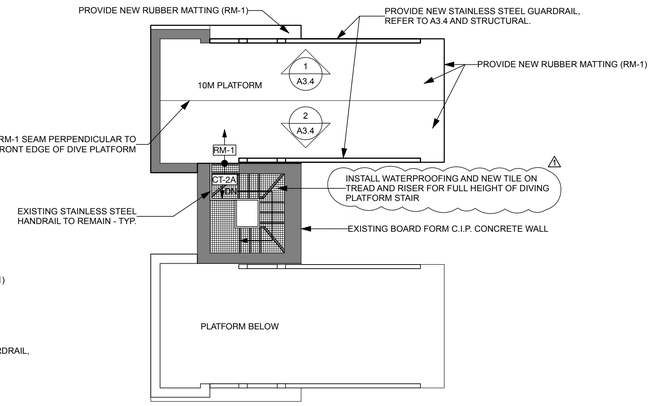

9 A3.3 ENLARGED RENOVATION PLAN - DIVING PLATFORM STAIR B
1:75

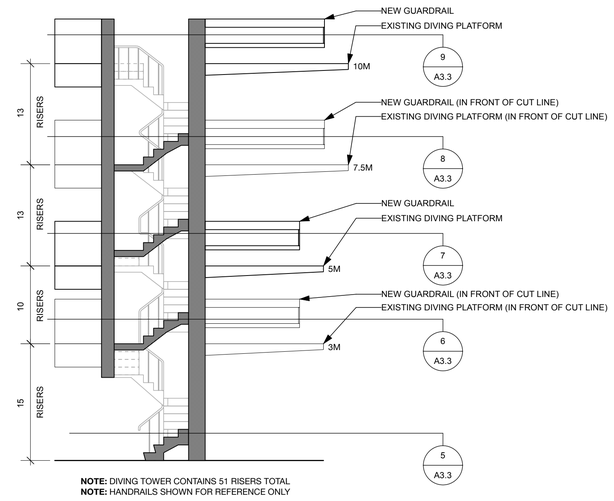

NOTE: DIVING TOWER CONTAINS 51 RISERS TOTAL
NOTE: HANDRAILS SHOWN FOR REFERENCE ONLY

10 A3.3 SECTION - DIVING TOWER PLATFORMS STAIR B
1:75

| x | architecture inc.
330 Main Street, Suite 310 Winnipeg Manitoba R3C 1A8 204 318 2010

3			
2			
1	ISSUED FOR ADDENDUM 03		2026-09-25
0	ISSUED FOR CONSTRUCTION		2026-07-28

SEAL

2026-07-28 DATE	ES DESIGNED	ES DRAWN	TC CHECKED	TC APPROVED

Winnipeg
THE CITY OF WINNIPEG
ASSETS & PROJECT MANAGEMENT DEPARTMENT
MUNICIPAL ACCOMMODATIONS DIVISION
3-65 GARRY STREET, R3C 4K4

PROJECT
PAN AM POOL
MAIN TANK RENEWAL

25 POSEIDON BAY

SHEET TITLE
DIVING PLATFORM STAIR RENOVATION PLAN

SCALE	PROJECT No:	SHEET No:
AS SHOWN	2024-0660	A3.3

DRAWING SHEET SIZE: A1 (594x841) PLOT 1:1