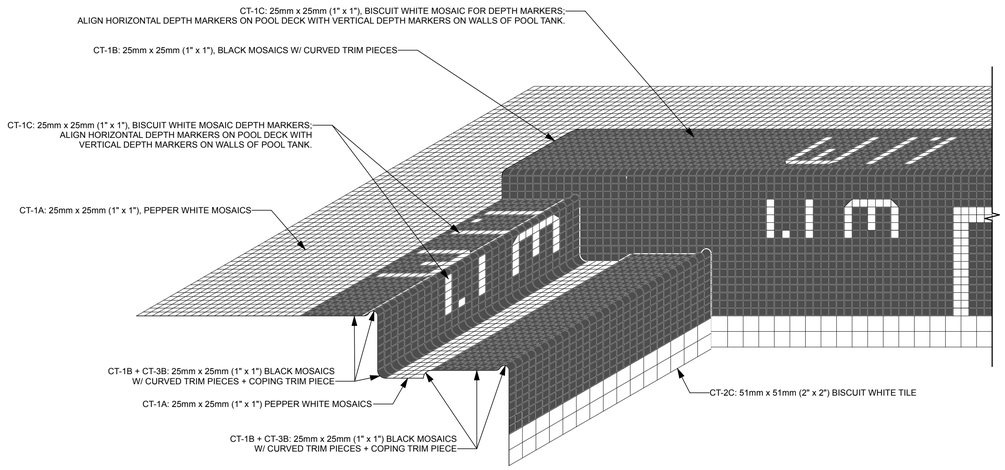

NOTE: SCHEMATIC DRAWING ONLY, LOCATIONS OF DEPTH MARKERS REPRESENTATIVE ONLY

1 / A4.3 MOSAIC TILES AT PERIMETER OF POOL TANK
SCALE: 1:10

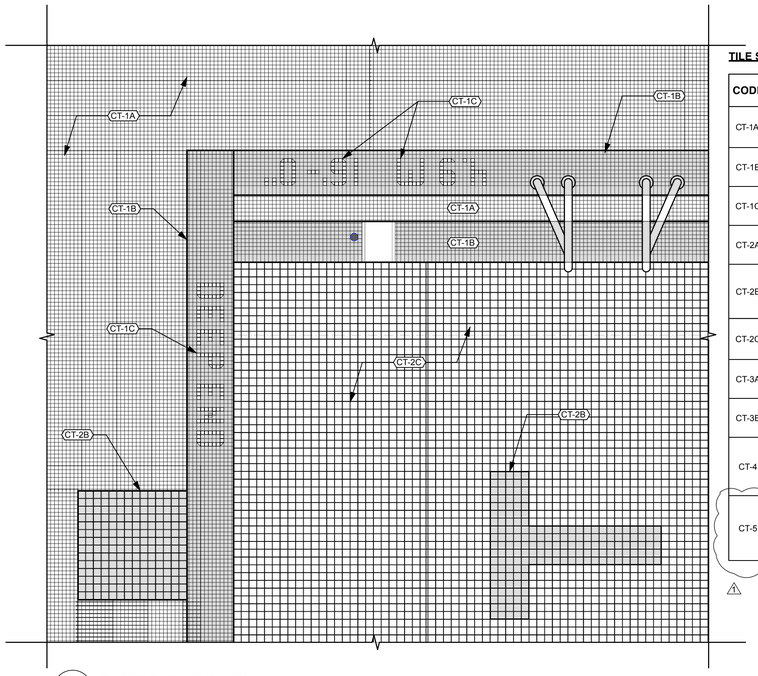

2 / A4.3 FLOOR TILE SCHEMATIC
SCALE: 1:20

TILE SCHEDULE

CODE	SUPPLIER	PRODUCT	DESCRIPTION	LOCATION
CT-1A	DALTILE	KEYSTONES	25mm x 25mm (1" X 1"), PEPPER WHITE D037	POOL DECK
CT-1B			25mm x 25mm (1" X 1"), BLACK D311	POOL HEADWALLS AND POOL EDGE
CT-1C			25mm x 25mm (1" X 1"), BISCUIT D317	DEPTH MARKERS + LETTERING ON POOL EDGE
CT-2A			51mm x 51mm (2" X 2"), PEPPER WHITE D037	DIVE TOWER STAIRS AND PLATFORM
CT-2B			51mm x 51mm (2" X 2"), BLACK D311	POOL TANK LANE MARKINGS, DIVE TOWER STAIR NOSING, SECCHI DISK, DEPTH MARKER
CT-2C			51mm x 51mm (2" X 2"), BISCUIT D317	POOL TANK WALLS + FLOOR, SECCHI DISK
CT-3A			51mm x 25mm (2" X 1"), TRIM PIECE, BISCUIT C701	POOL COPING w/ GRASPABLE EDGE
CT-3B			51mm x 25mm (2" X 1"), TRIM PIECE, BLACK C701	POOL COPING w/ GRASPABLE EDGE
CT-4			51mm x 51mm (2" X 2"), BUILD-UP COVE BASE MB5B, BLACK D311 127mm x 305mm (5" X 12" SHEET)	PERIMETER WALL BASE
CT-5	DALTILE INLAYS INC.	CUSTOM	NO DIVING W/ INTERNATIONAL SYMBOL (RED) 9999488693 W/ ENGLISH AND FRENCH TEXT	POOL EDGE - NO DIVING SYMBOL

⚠

COPING TRIM PIECE (GRASPABLE) AT EDGE
NORTH + SOUTH: CONCAVE RADIUS TILE AT EDGE OF GUTTER/WATER LINE; EAST + WEST: FLAT TILE

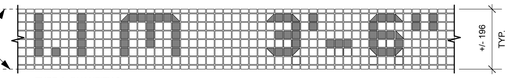

TYPE 1: QUANTITY 9

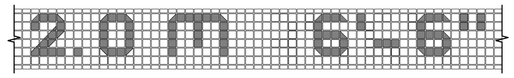

TYPE 2: QUANTITY 12

COPING TRIM PIECE (GRASPABLE) AT EDGE
NORTH + SOUTH: CONCAVE RADIUS TILE AT EDGE OF GUTTER/WATER LINE; EAST + WEST: FLAT TILE

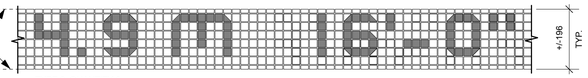

TYPE 3: QUANTITY 6

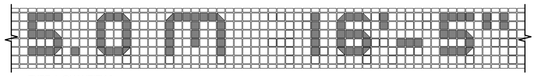

TYPE 4: QUANTITY 3

3 / A4.3 TILE MARKINGS - VERTICAL APPLICATIONS
SCALE: 1:10

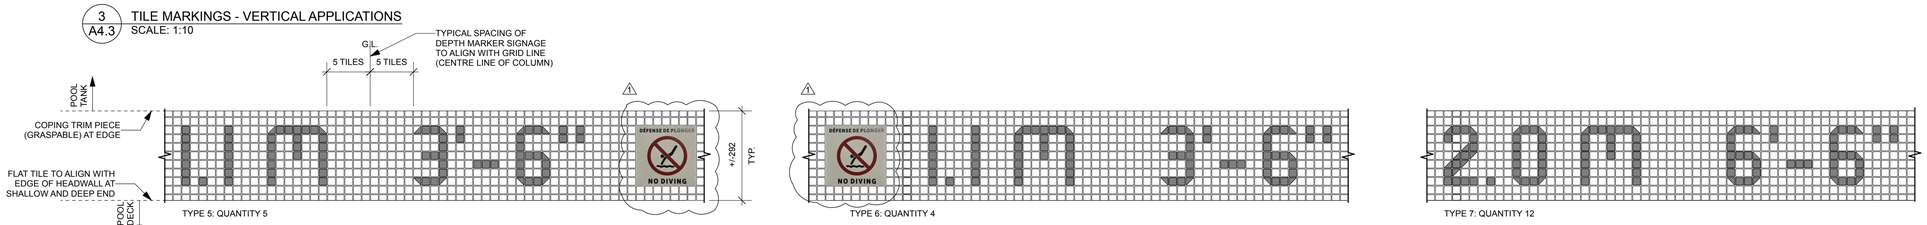

TYPE 5: QUANTITY 5

TYPE 6: QUANTITY 4

TYPE 7: QUANTITY 12

POOL TANK
COPING TRIM PIECE (GRASPABLE) AT EDGE
FLAT TILE TO ALIGN WITH EDGE OF HEADWALL AT SHALLOW AND DEEP END
POOL DECK

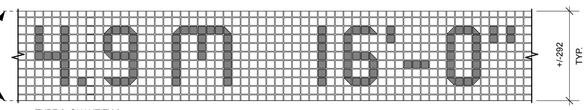

TYPE 8: QUANTITY 6

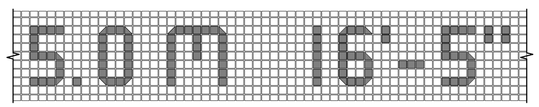

TYPE 9: QUANTITY 3

⚠
NEW SLIP RESISTANT 'NO DIVING SYMBOL' SIGNAGE TO BE INSTALLED FLUSH WITH THE TOP OF THE TILE. SIZE TO MATCH 7 TILES X 7 TILES (INSTALLED TILES). (MIN. DIMENSION OF SYMBOL TO BE 100mm x 100mm)

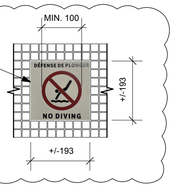

POOL TANK
RADIUS TILE AT EDGE
RADIUS TILE AT EDGE
POOL DECK

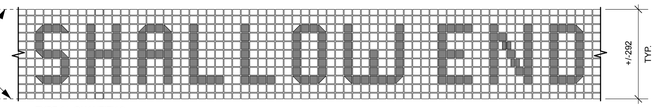

TYPE 11: QUANTITY 2

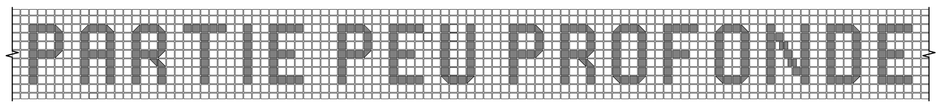

TYPE 12: QUANTITY 2

POOL TANK
RADIUS TILE AT EDGE
RADIUS TILE AT EDGE
POOL DECK



TYPE 13: QUANTITY 2

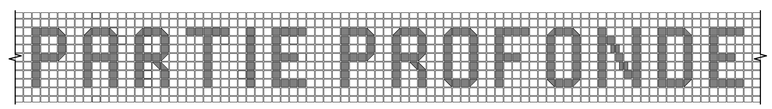

TYPE 14: QUANTITY 2

4 / A4.3 TILE MARKINGS - HORIZONTAL APPLICATIONS
SCALE: 1:10

CrosierKilgour
Structural Engineering & Building Performance

3			
2			
1	ISSUED FOR ADDENDUM 03		2026-09-25
0	ISSUED FOR CONSTRUCTION		2026-07-28

SEAL

DATE	DESIGNED	DRAWN	CHECKED	APPROVED
2026-07-28	ES	ES	TC	TC

THE CITY OF WINNIPEG
ASSETS & PROJECT MANAGEMENT DEPARTMENT
MUNICIPAL ACCOMMODATIONS DIVISION
3-65 GARRY STREET, R3C 4K4

PROJECT
PAN AM POOL
MAIN TANK RENEWAL

25 POSEIDON BAY

SHEET TITLE
RENOVATION TILE MARKINGS

SCALE	PROJECT No:	SHEET No:
AS SHOWN	2024-0660	A4.3

DRAWING SHEET SIZE: A1 (594x841) PLOT 1:1