


KEY PLAN
SCALE: NTS

GENERAL NOTES


- A. ALL ABANDONED EQUIPMENT AND SERVICES WITHIN AREA OF WORK SHALL BE REMOVED.
- B. THIS BUILDING MAY CONTAIN ASBESTOS. REFER TO FRONT END SPECIFICATIONS FOR FURTHER INFORMATION.
- C. PRIOR TO DEMOLISHING AND REMOVAL OF THE EXISTING EQUIPMENT, COORDINATE WITH THE CITY. RETURN EQUIPMENT TO THE CITY AS REQUIRED.
- D. REFER TO ROOF DETAILS AND SPECIFICATIONS FOR ALL NEW AND CAPPED OPENINGS.
- E. FOR DRAWING CLARITY, NOT ALL MECHANICAL EQUIPMENT, PIPING AND DUCTWORK HAS BEEN SHOWN.

KEY NOTES


- 1. INSTALL NEW FLUE VENT IN ACCORDANCE WITH MANUFACTURER REQUIREMENTS. PROVIDE WEATHER TIGHT SEAL IN ACCORDANCE WITH ROOF DETAIL AND MATCH THE CONSTRUCTION AND FINISH FROM ADJACENT CONDITION. CONTRACTOR TO CONFIRM EXACT LOCATION ON SITE. MAINTAIN REQUIRED SEPARATION DISTANCE FROM COMBUSTION AIR INTAKE AS PER GAS CODE.
- 2. NEW COMBUSTION INTAKE THROUGH ROOF. PROVIDE WEATHER TIGHT SEAL IN ACCORDANCE WITH ROOF DETAIL AND MATCH THE CONSTRUCTION AND FINISH FROM ADJACENT CONDITION. CONTRACTOR TO CONFIRM EXACT LOCATION ON SITE.
- 3. NEW 20PSI NATURAL GAS PIPE FROM BELOW SERVING NEW HRU.
- 4. NEW NON FREEZE ROOF HYDRANT LOCATED BESIDE HRU. COORDINATE FINAL LOCATION ON SITE. REFER TO ROOF HYDRANT SCHEMATIC DETAIL ON THIS DRAWING.
- 5. PROVIDE CONDENSATE DRAIN TO DISCHARGE ONTO ROOF C/W HEAT TRACE (BY ELECTRICAL DIVISION) AND INSULATION.
- 6. NEW HRU. REFER TO DRAWING M4.2 FOR FURTHER INFORMATION.
- 7. NEW NATURAL GAS REGULATOR VENT THROUGH ROOF. PROVIDE WEATHER TIGHT SEAL. CONTRACTOR TO CONFIRM EXACT LOCATION ON SITE.
- 8. PROVIDE NEW OVER-PRESSURE PROTECTION DEVICE.

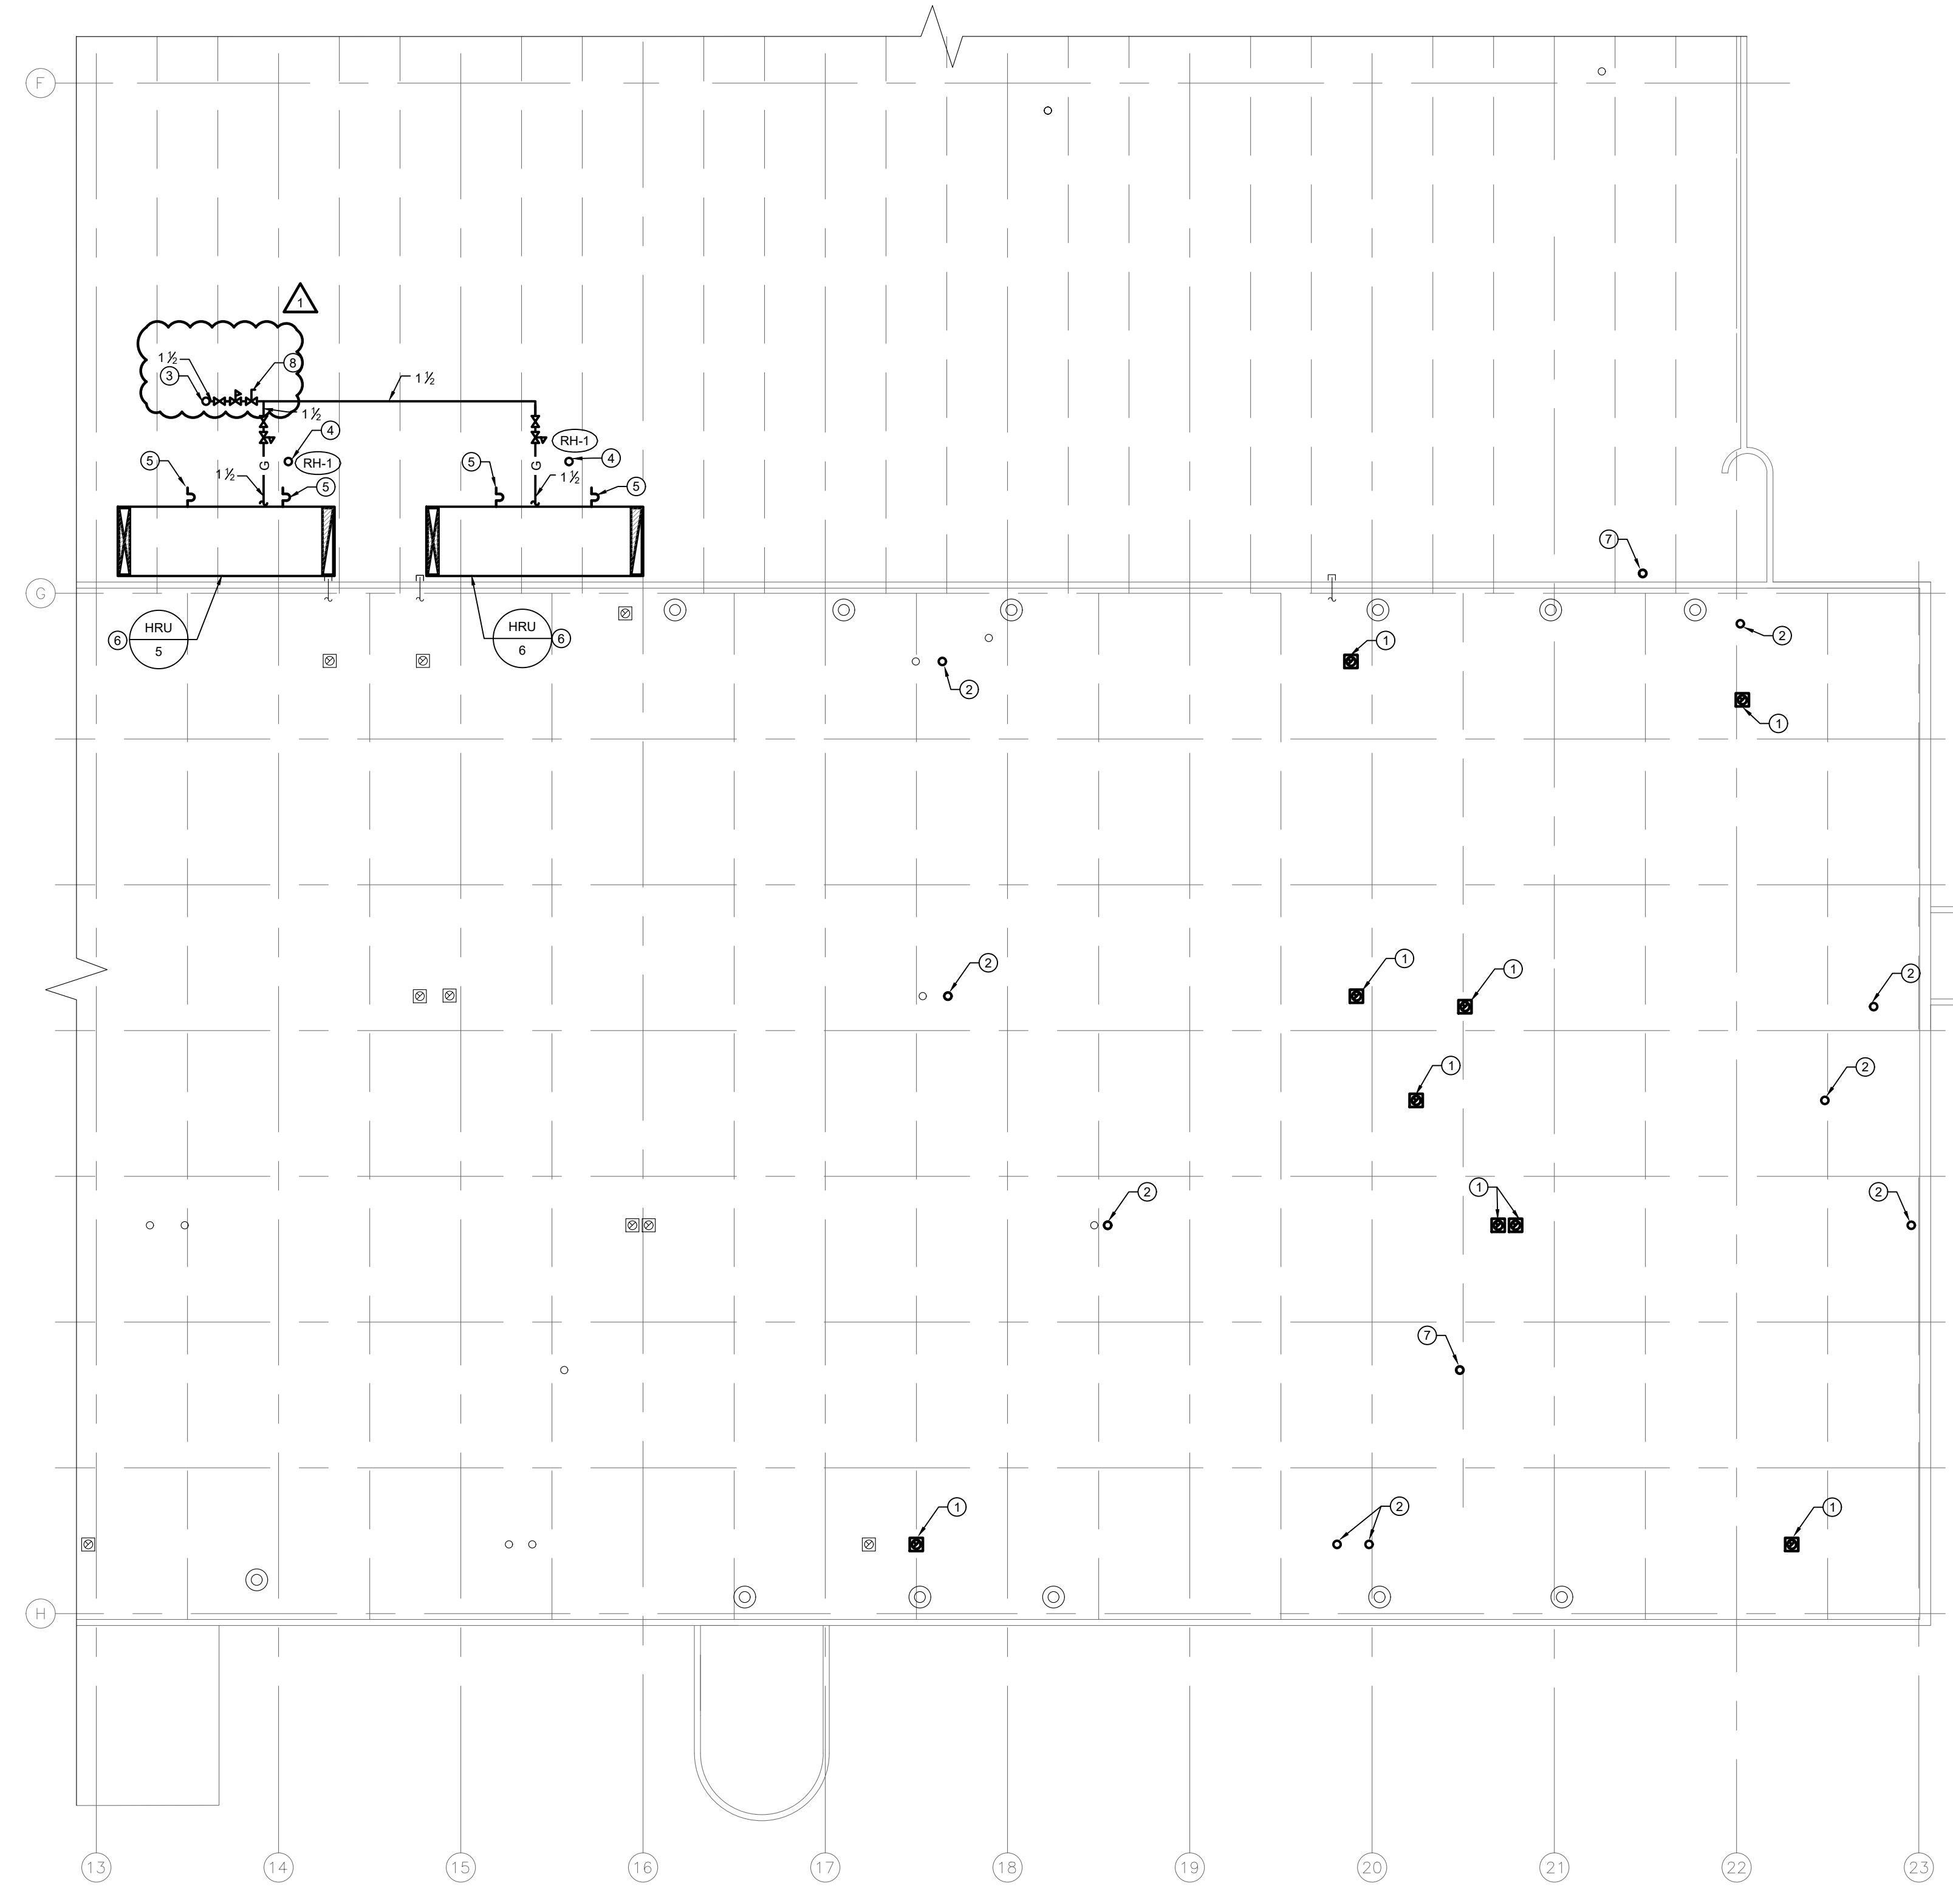

1 PARTIAL ROOF PLAN - PLUMBING - NEW CONSTRUCTION
SCALE: 1/16"=1'-0"
M2.2

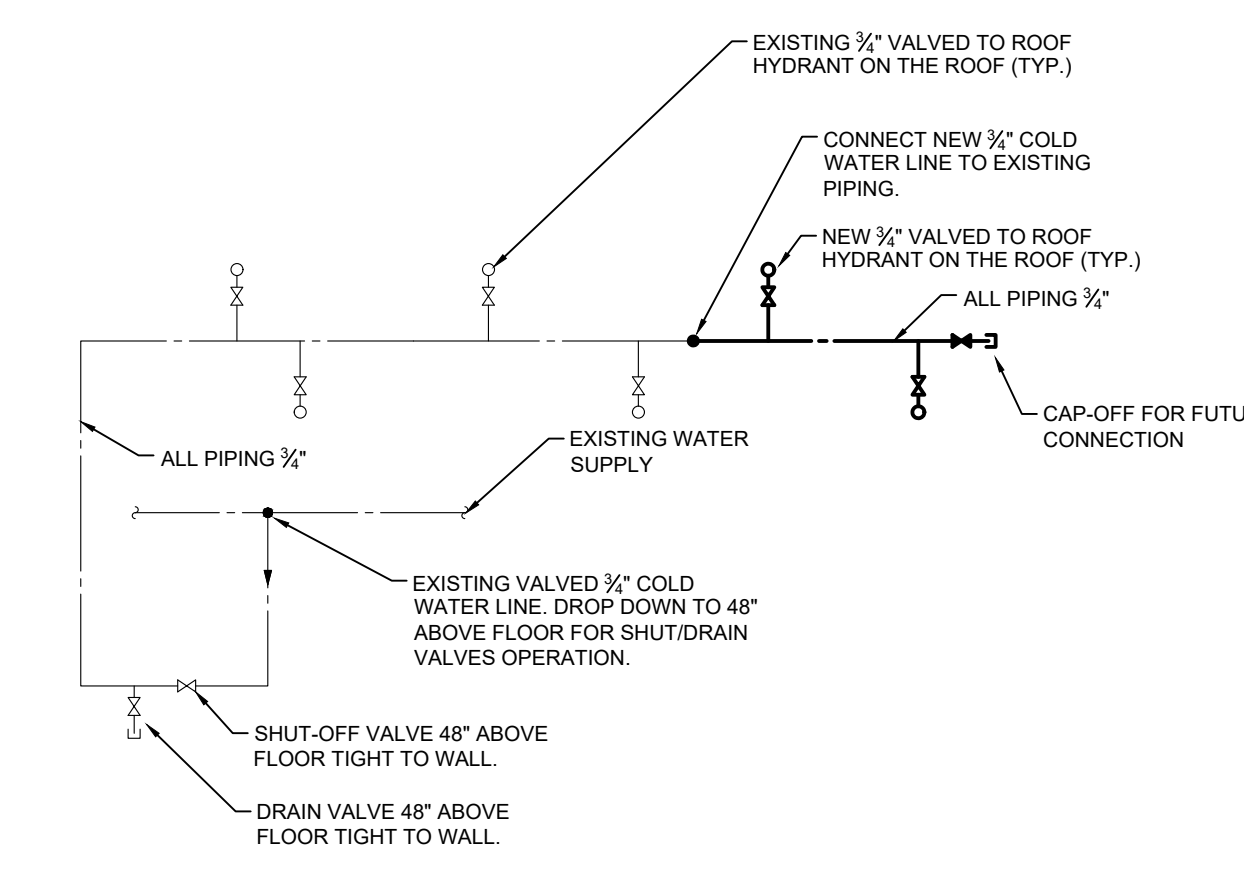

2 ROOF HYDRANT SCHEMATIC DETAIL
SCALE: NTS
M2.2

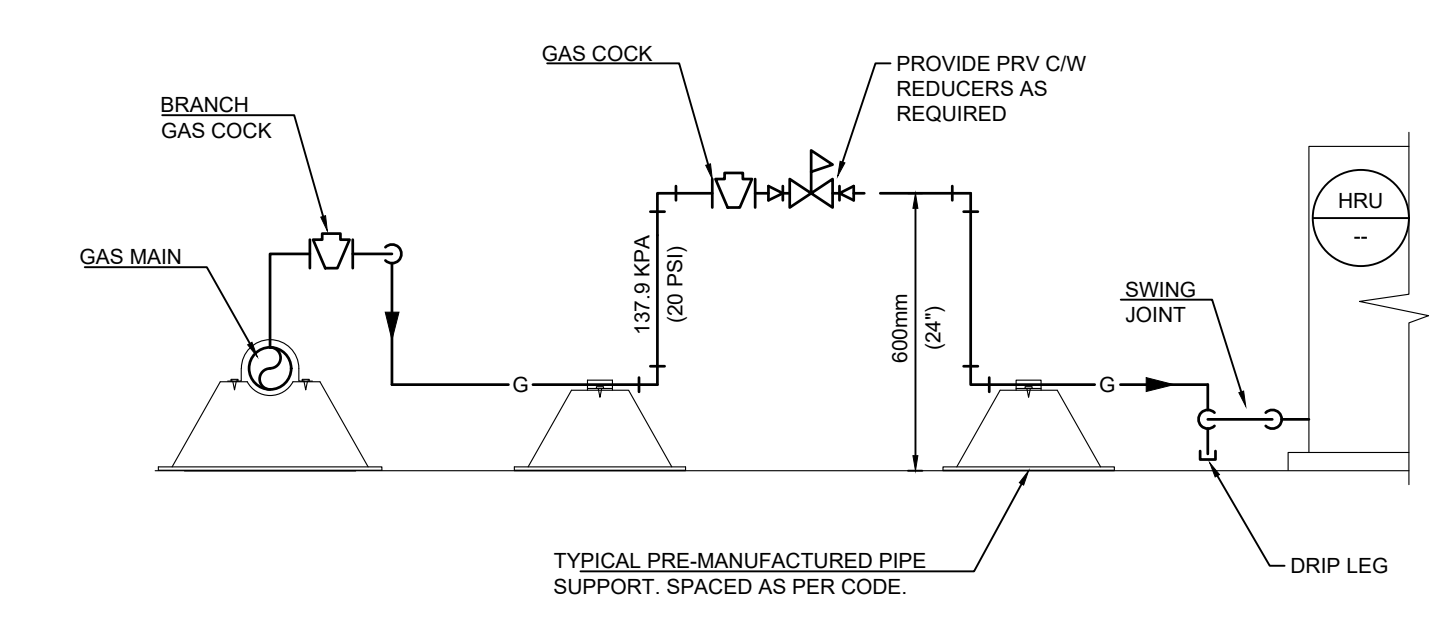

3 TYPICAL PRESSURE REDUCING VALVE DETAIL
SCALE: NTS
M2.2

FILE NAME AND PATH: G:\Projects\2025\25-330 Transit East High Bay Ventilation Upgrade\3D CAD\3D Model\PHASE 0325330_M2.2_P1_R1.dwg
LAYOUT: M2.2 LAST SAVED BY: ajm DATE PLOTTED: January 9, 2026 8:15:28 AM

LETTER OR NUMBER	DESCRIPTION	BY	DDMMYY
1	ISSUED FOR ADDENDUM-1	JH	23/04/2026
0	ISSUED FOR CONSTRUCTION	JH	27/03/2026

**ENGINEERS
GEO-SCIENTISTS
MANITOBA**
Certificate of Authorization
SMS Engineering Ltd.
No. 166

ORIGINAL
CONTRACT DRAWING
SIGNED AND SEALED BY
J.T. HOPKOCKS, P. ENG
MARCH 27, 2026

SMS Engineering
770 Bradford Street Winnipeg, Canada (204) 775-0291
smseng.com

Project Title
**TRANSIT MAINTENANCE
AND REPAIR BUILDING
MECHANICAL UPGRADE -
EAST HIGH BAY**
WINNIPEG MAINTOBA

Drawing Title
**PARTIAL ROOF PLAN -
PLUMBING -
NEW CONSTRUCTION**

Drawn By
AP
Checked By
AJ
Approved By
JH
Scale
AS NOTED
Date
MARCH 2026
Project No.
25-330-01

Revision Number
0
Drawing Number
M2.2
Sheet Order
07 OF 10

